

boundary line


405 2

boundary line


boundary line

2 406

boundary line

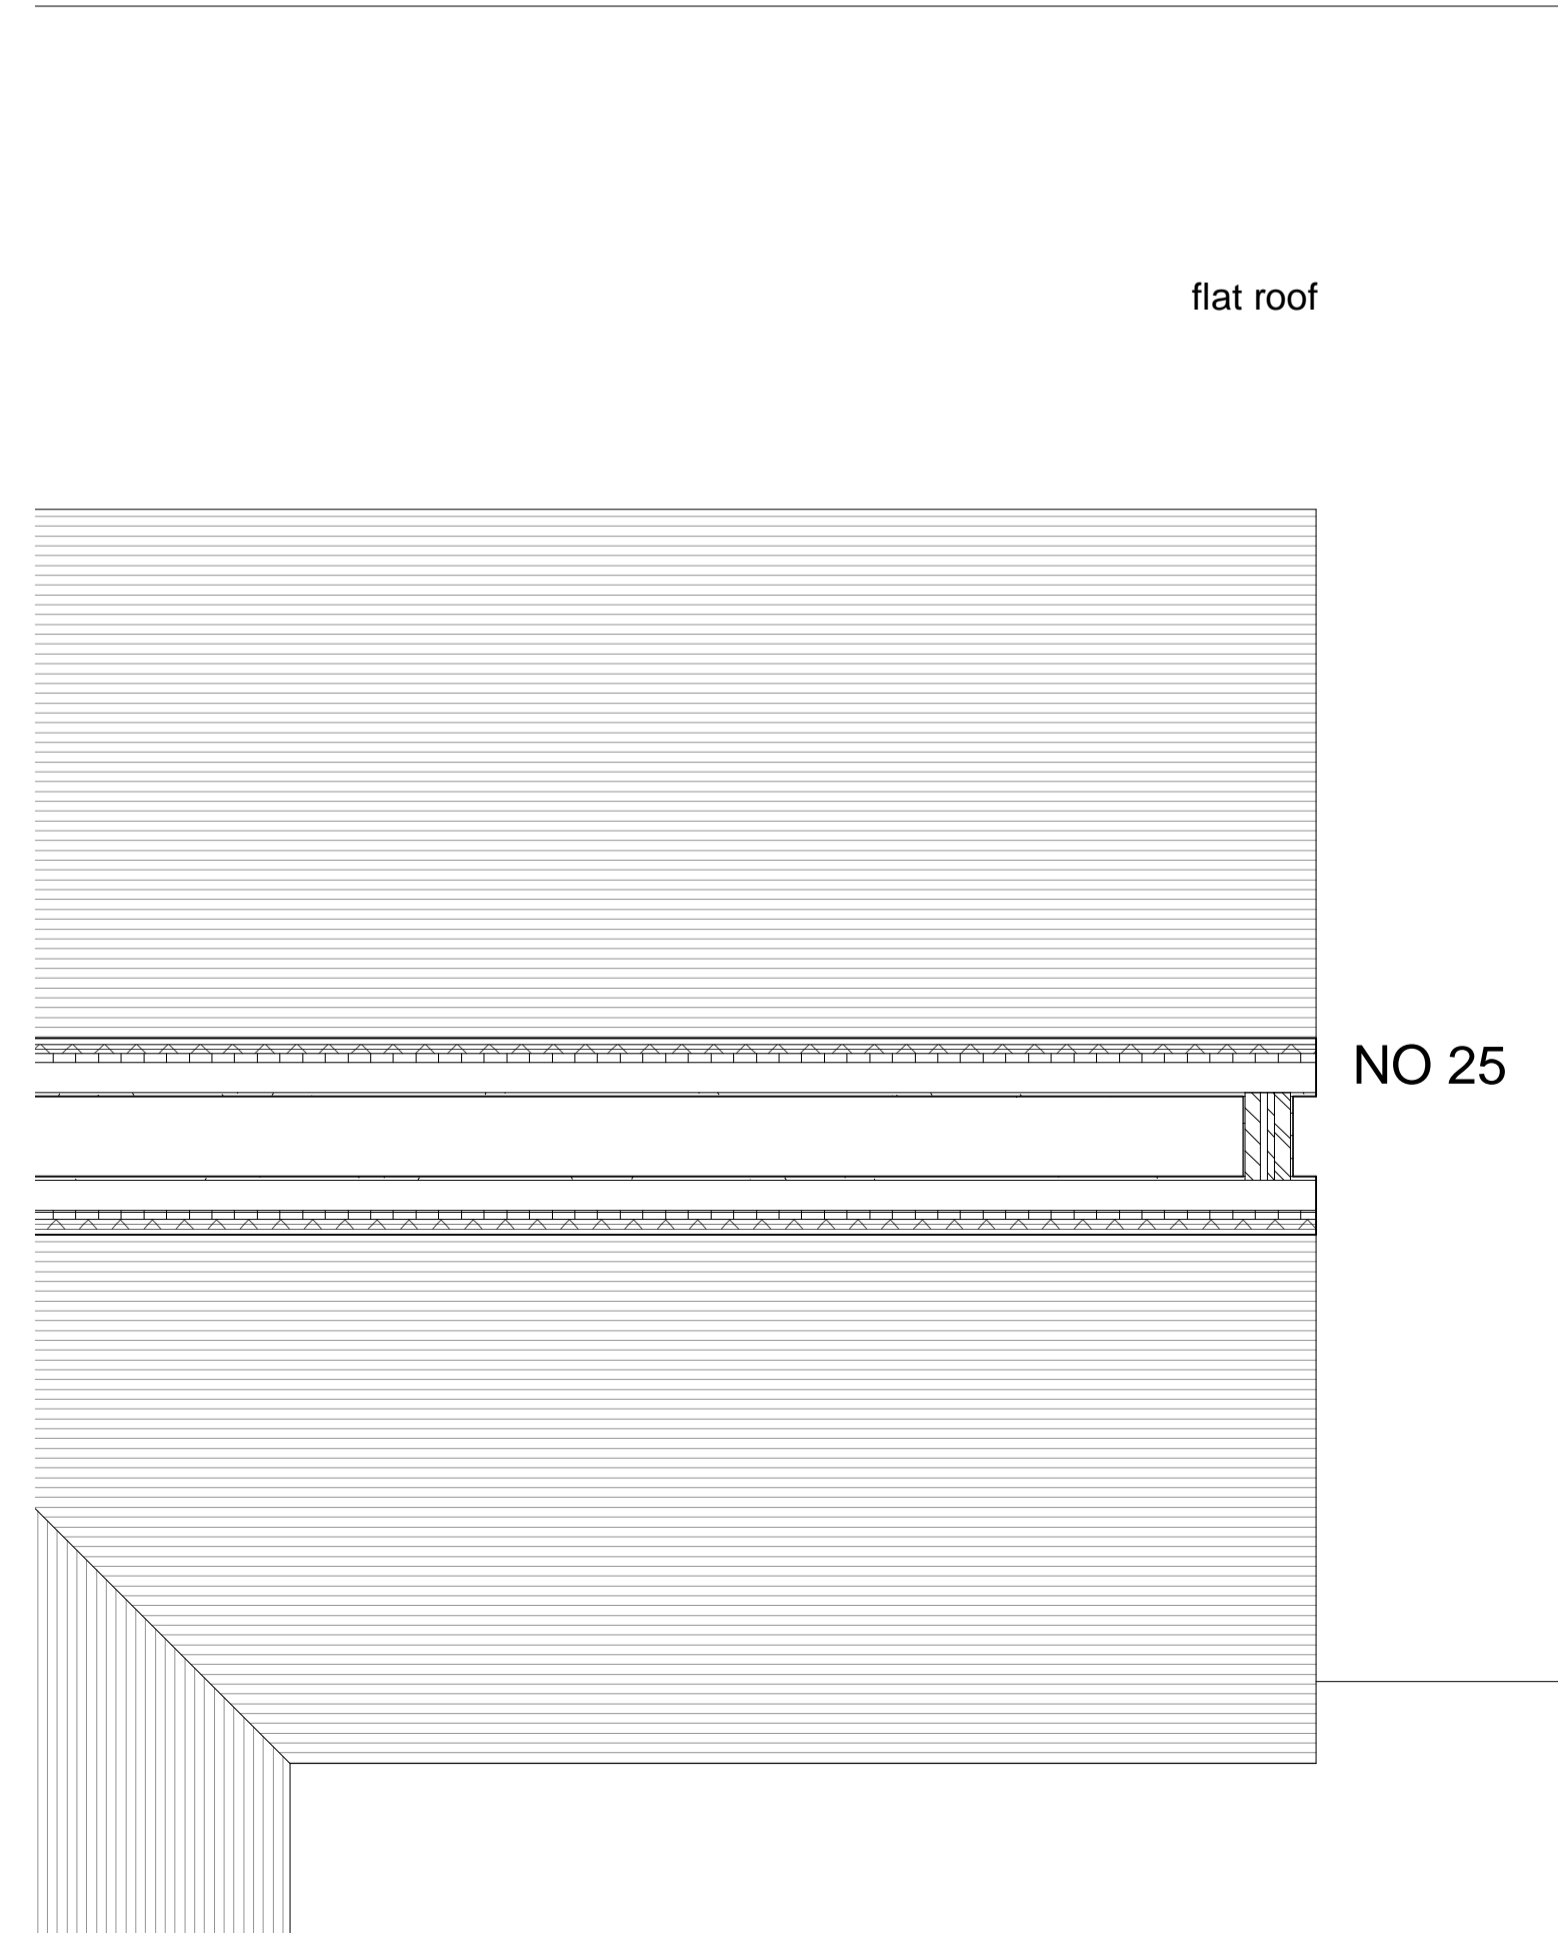

NO 25

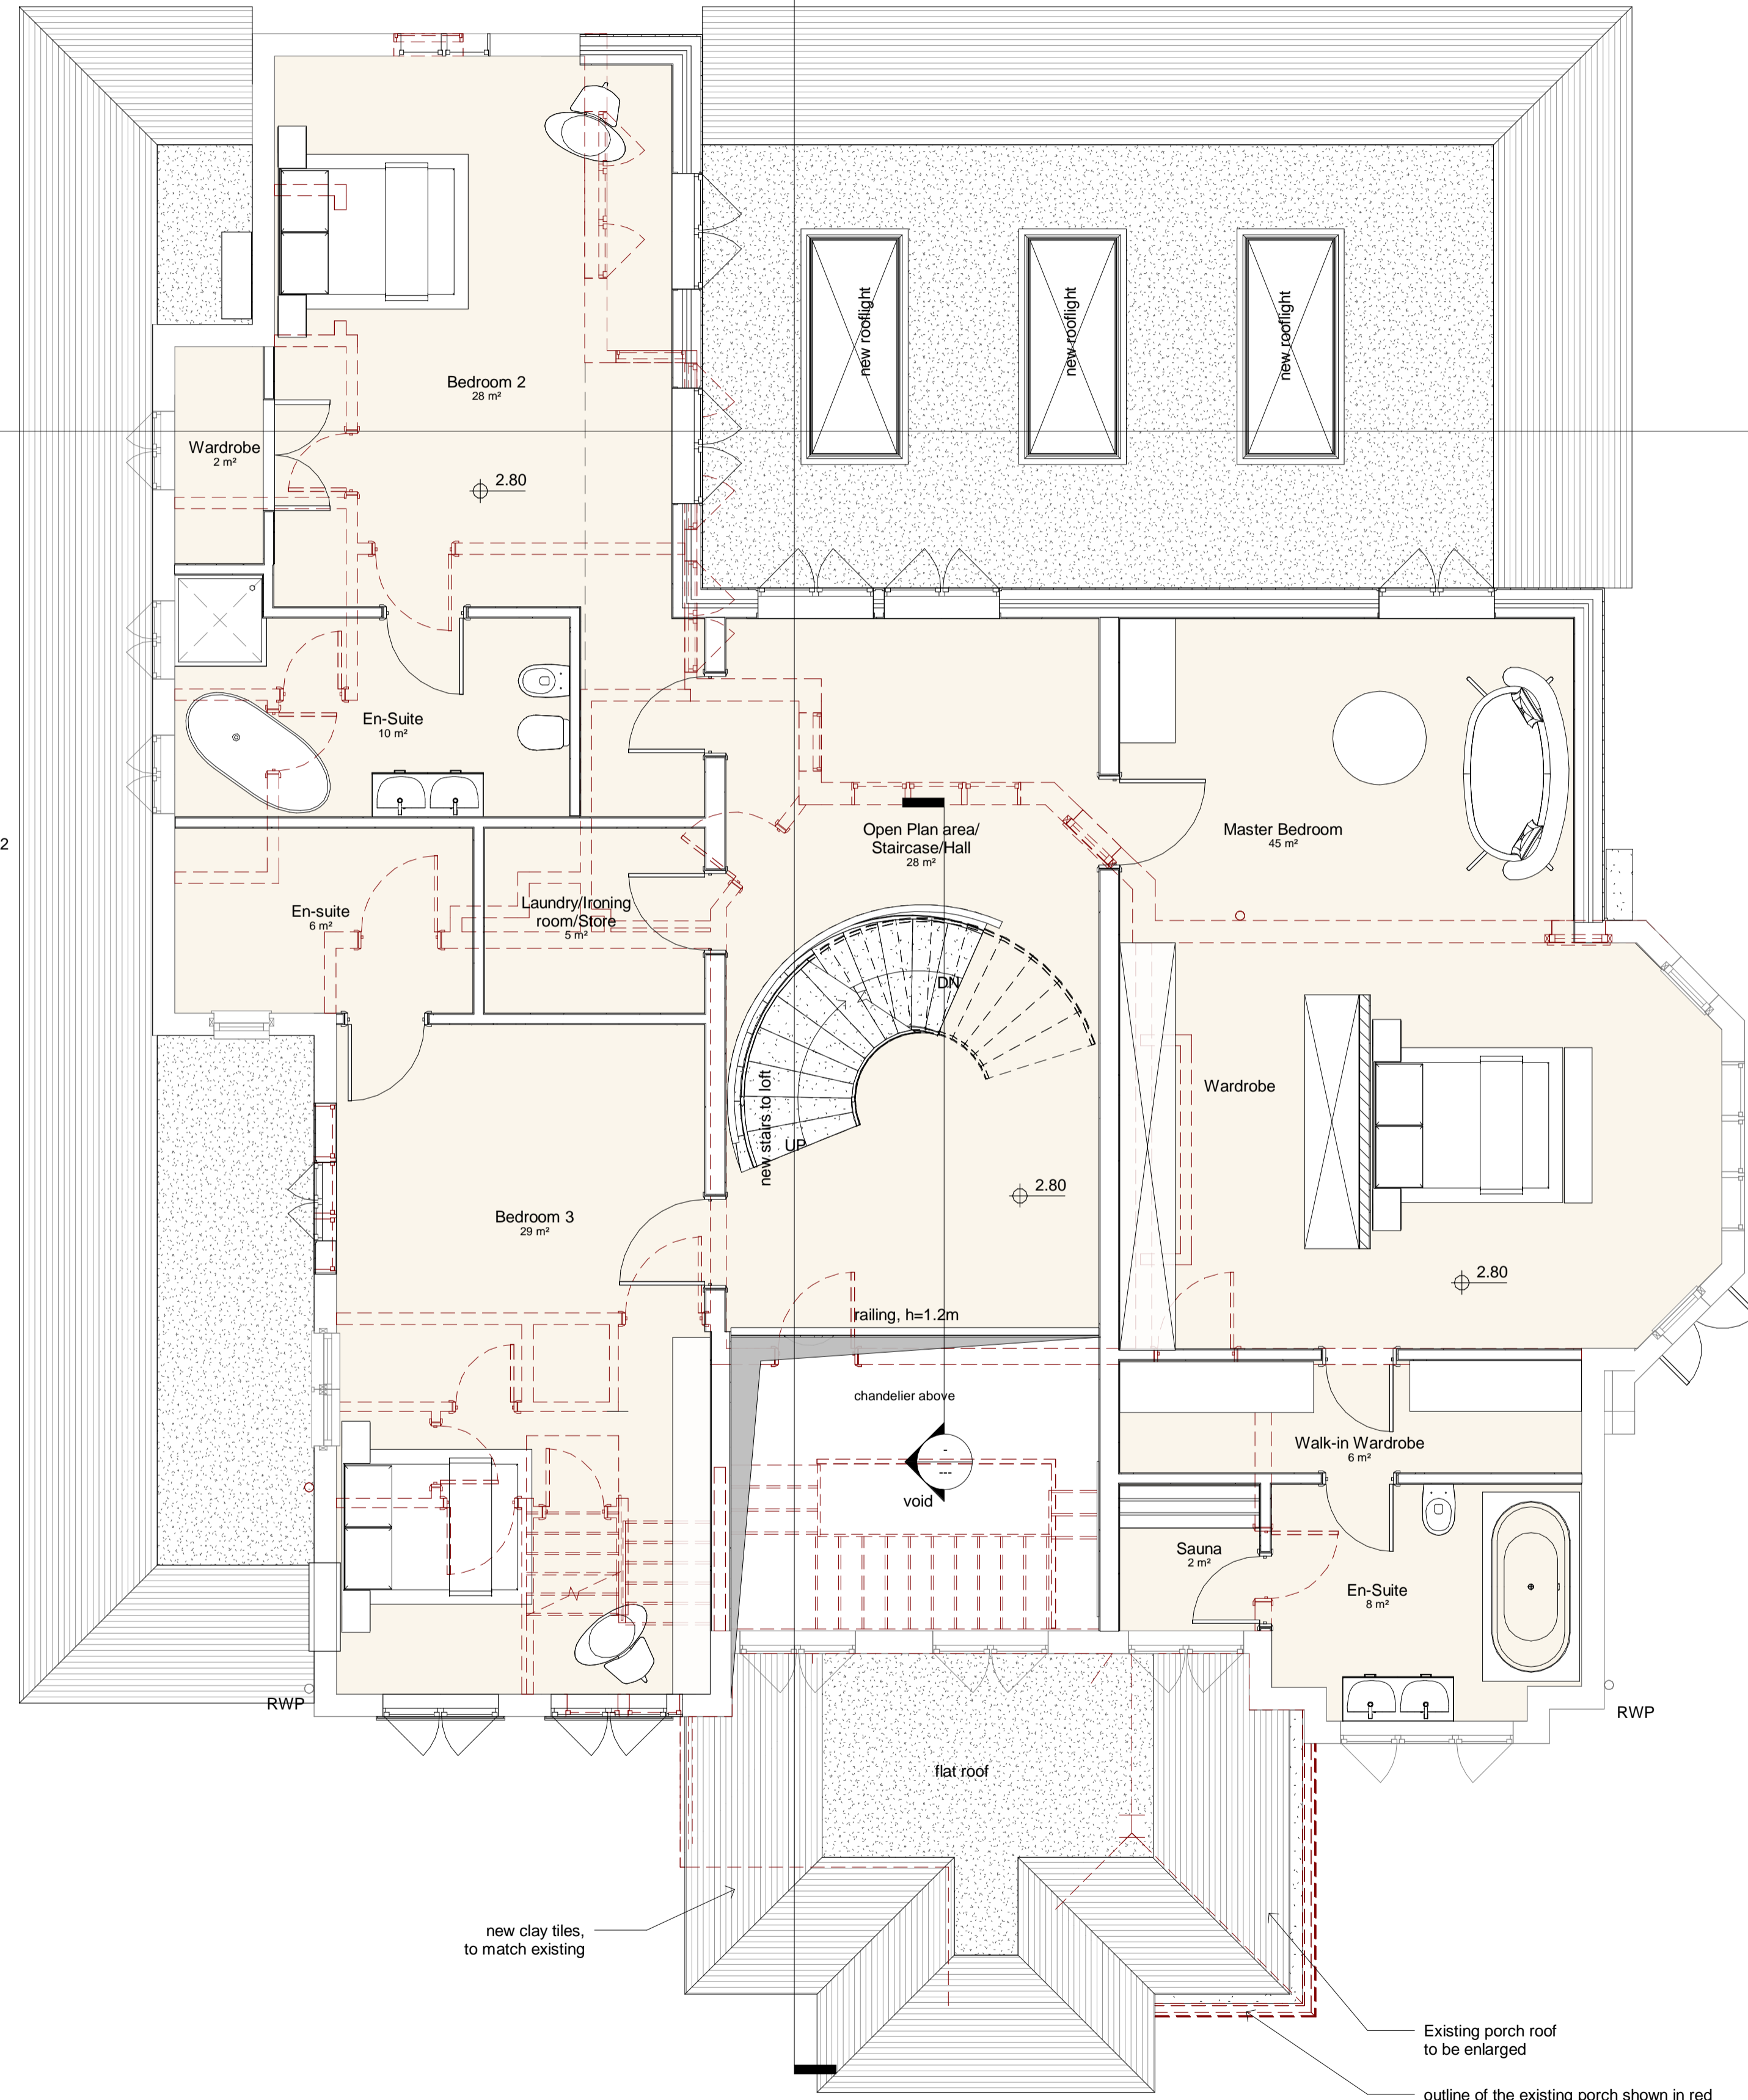

new clay tiles, to match existing

Existing porch roof to be enlarged  
outline of the existing porch shown in red

NO 27

**1 First Floor Plan**  
1 : 50

**NOTES**

| Rev. | Amendments | Date | Chkd. |
|------|------------|------|-------|
|      |            |      |       |

Client  
**Mr Mohammad Farooq Azami**

**STS Structural Engineering Ltd**  
58 Crossway, Welwyn Garden City, Hertfordshire, AL8 7EE  
Tel: 01707 695466 Fax: 01707 692006  
Web: www.sts-se.co.uk Email: sia@sts-se.co.uk

Project  
27 Burdon Lane, Cheam, Sutton, London SM2 7PP

Title  
**First Floor Plan - As Built**

|                |             |              |
|----------------|-------------|--------------|
| Drawn NK       | Date Jul'21 | Scale 1 : 50 |
| Checked MN, DS | Date Jul'21 | Size A1      |
| Approved SS    | Date Jul'21 |              |

|                                     |           |
|-------------------------------------|-----------|
| Drawing No.<br><b>1910-1220-402</b> | Rev.<br>- |
|-------------------------------------|-----------|

7/22/2021 5:17:55 PM