

NOTES

Rev.	Amendments	Date	Chkd.

Client Mr Mohammad Farooq Azami


STS Structural Engineering Ltd
 58 Crossway, Welwyn Garden City, Hertfordshire, AL8 7EE
 Tel: 01707 695466 Fax: 01707 692006
 Web: www.sts-se.co.uk Email: sia@sts-se.co.uk

Project 27 Burdon Lane, Cheam, Sutton, London SM2 7PP


Title Ground Floor Plan - As Built

Drawn NK	Date Jul'21	Scale 1:50
Checked MN, DS	Date Jul'21	Size A1
Approved SS	Date Jul'21	

Drawing No. 1910-1220-401
 Rev. -

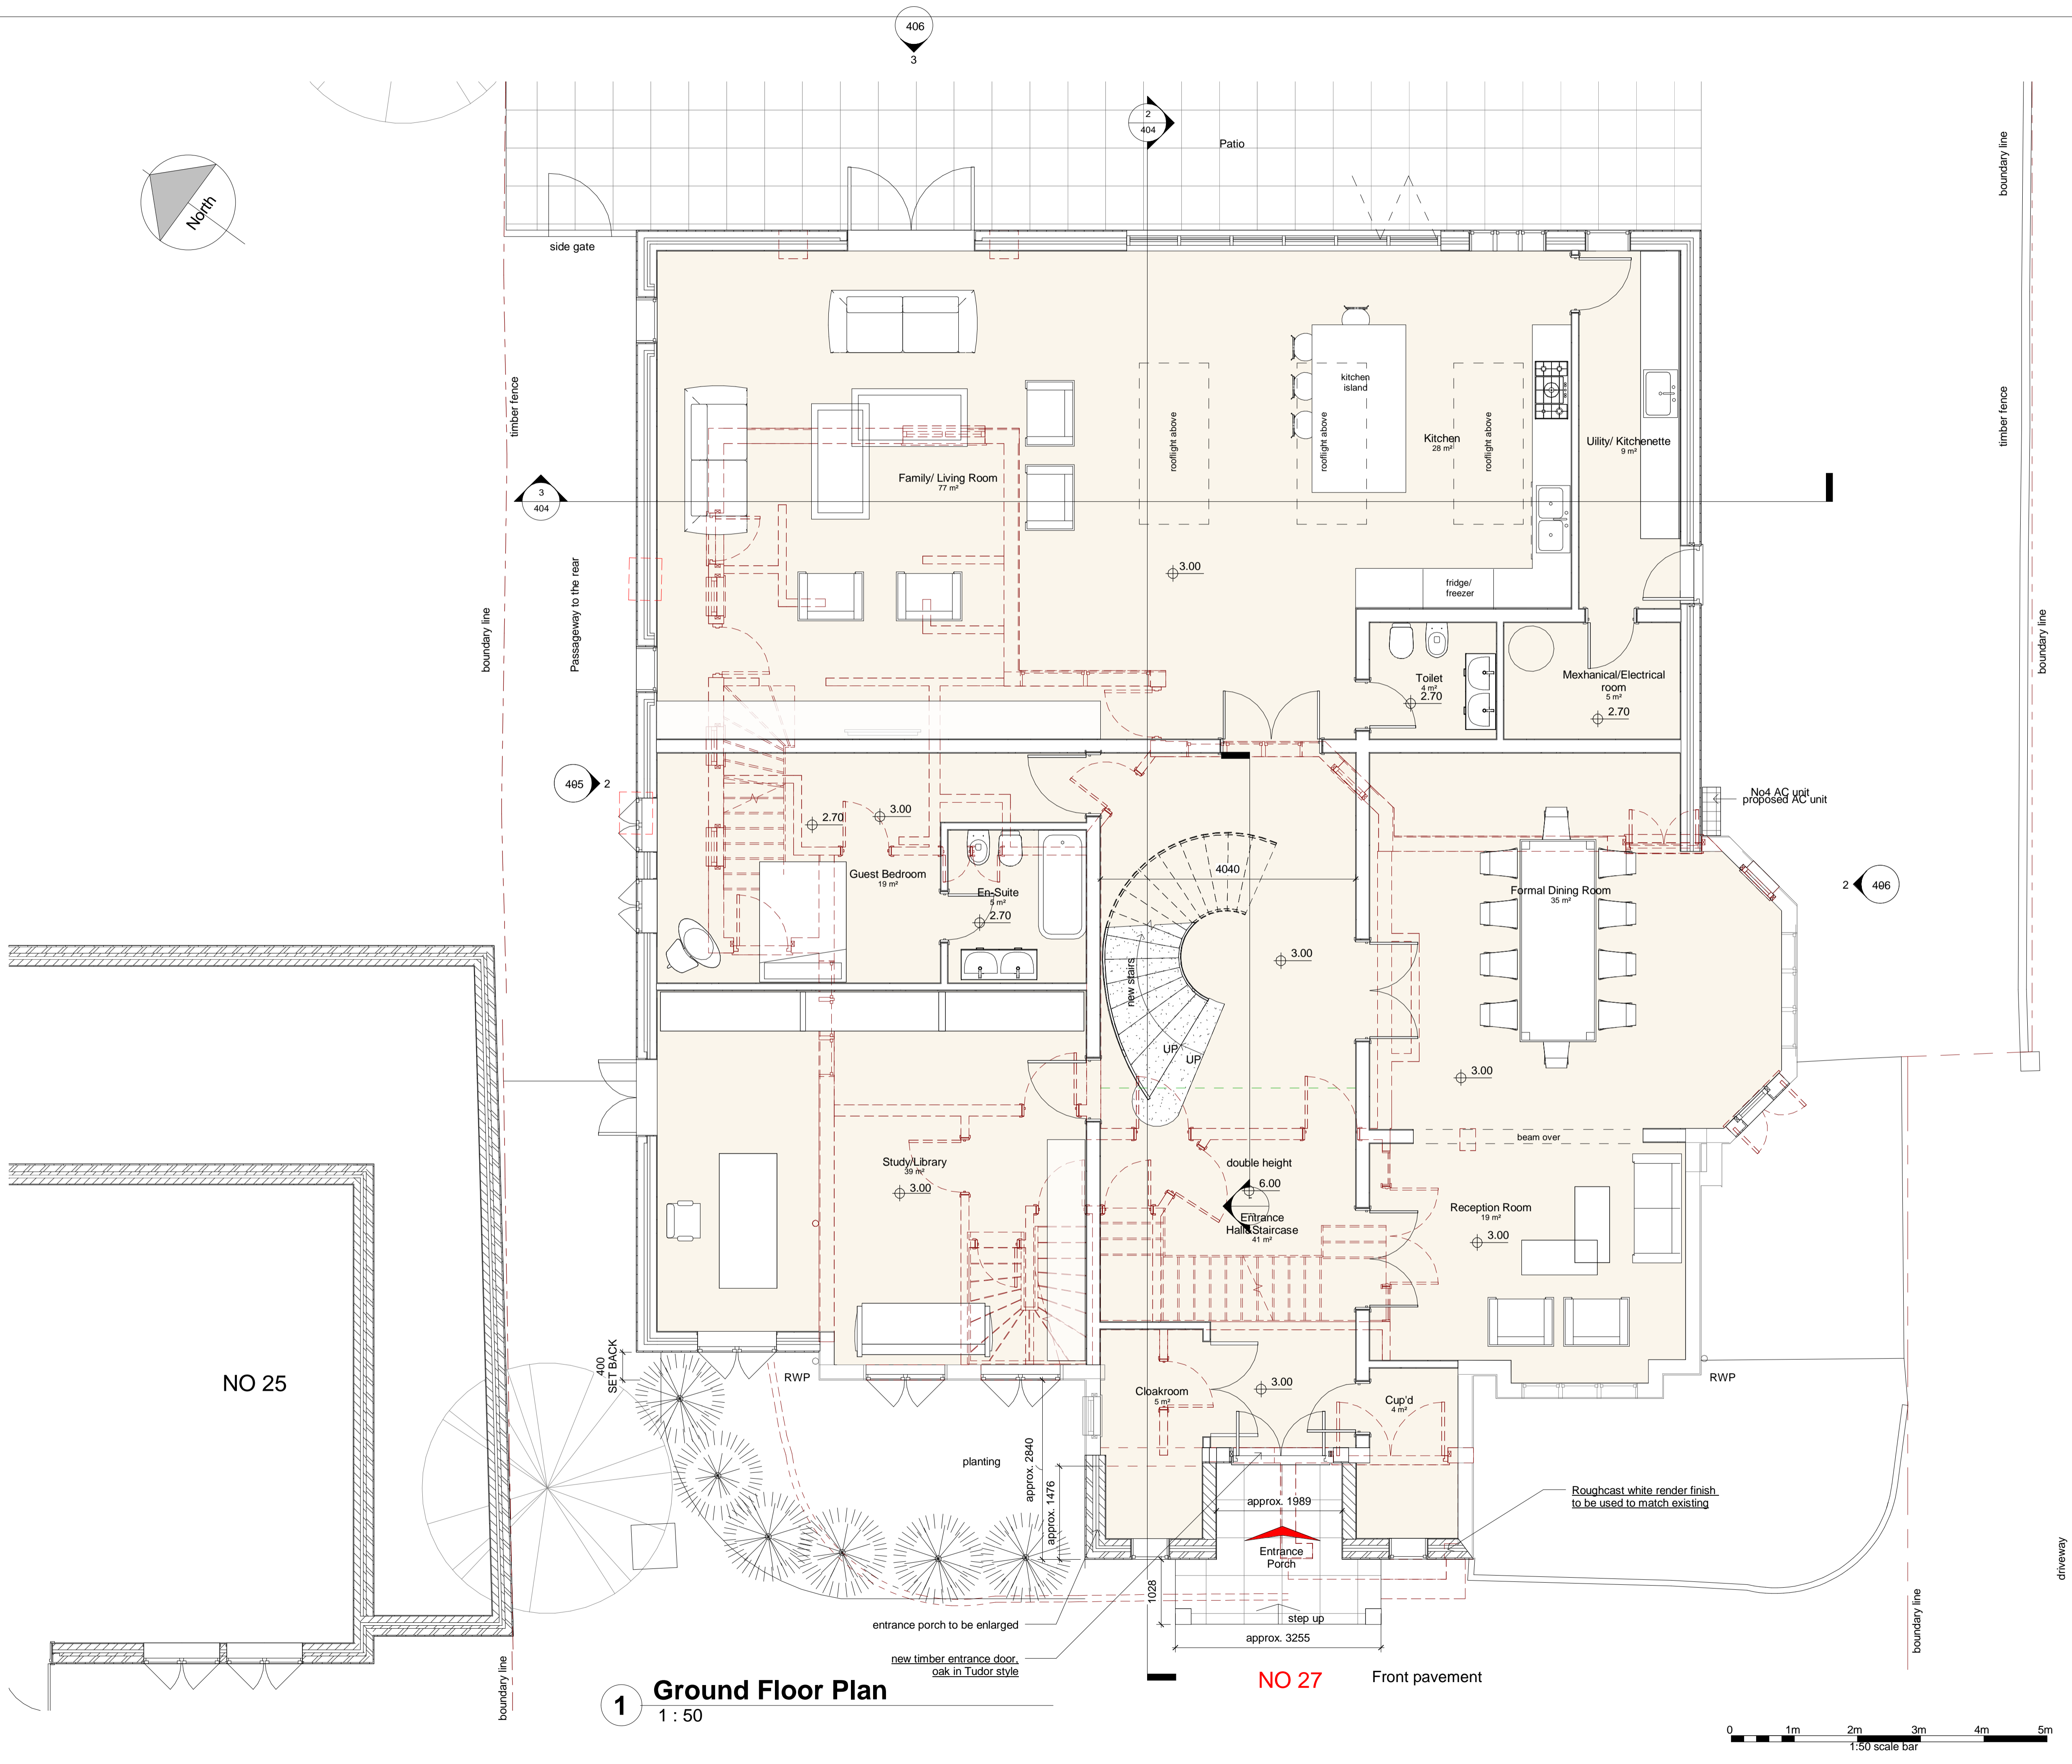

1 Ground Floor Plan 1:50

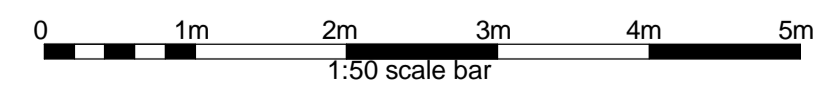

7/22/2021 5:02:01 PM