

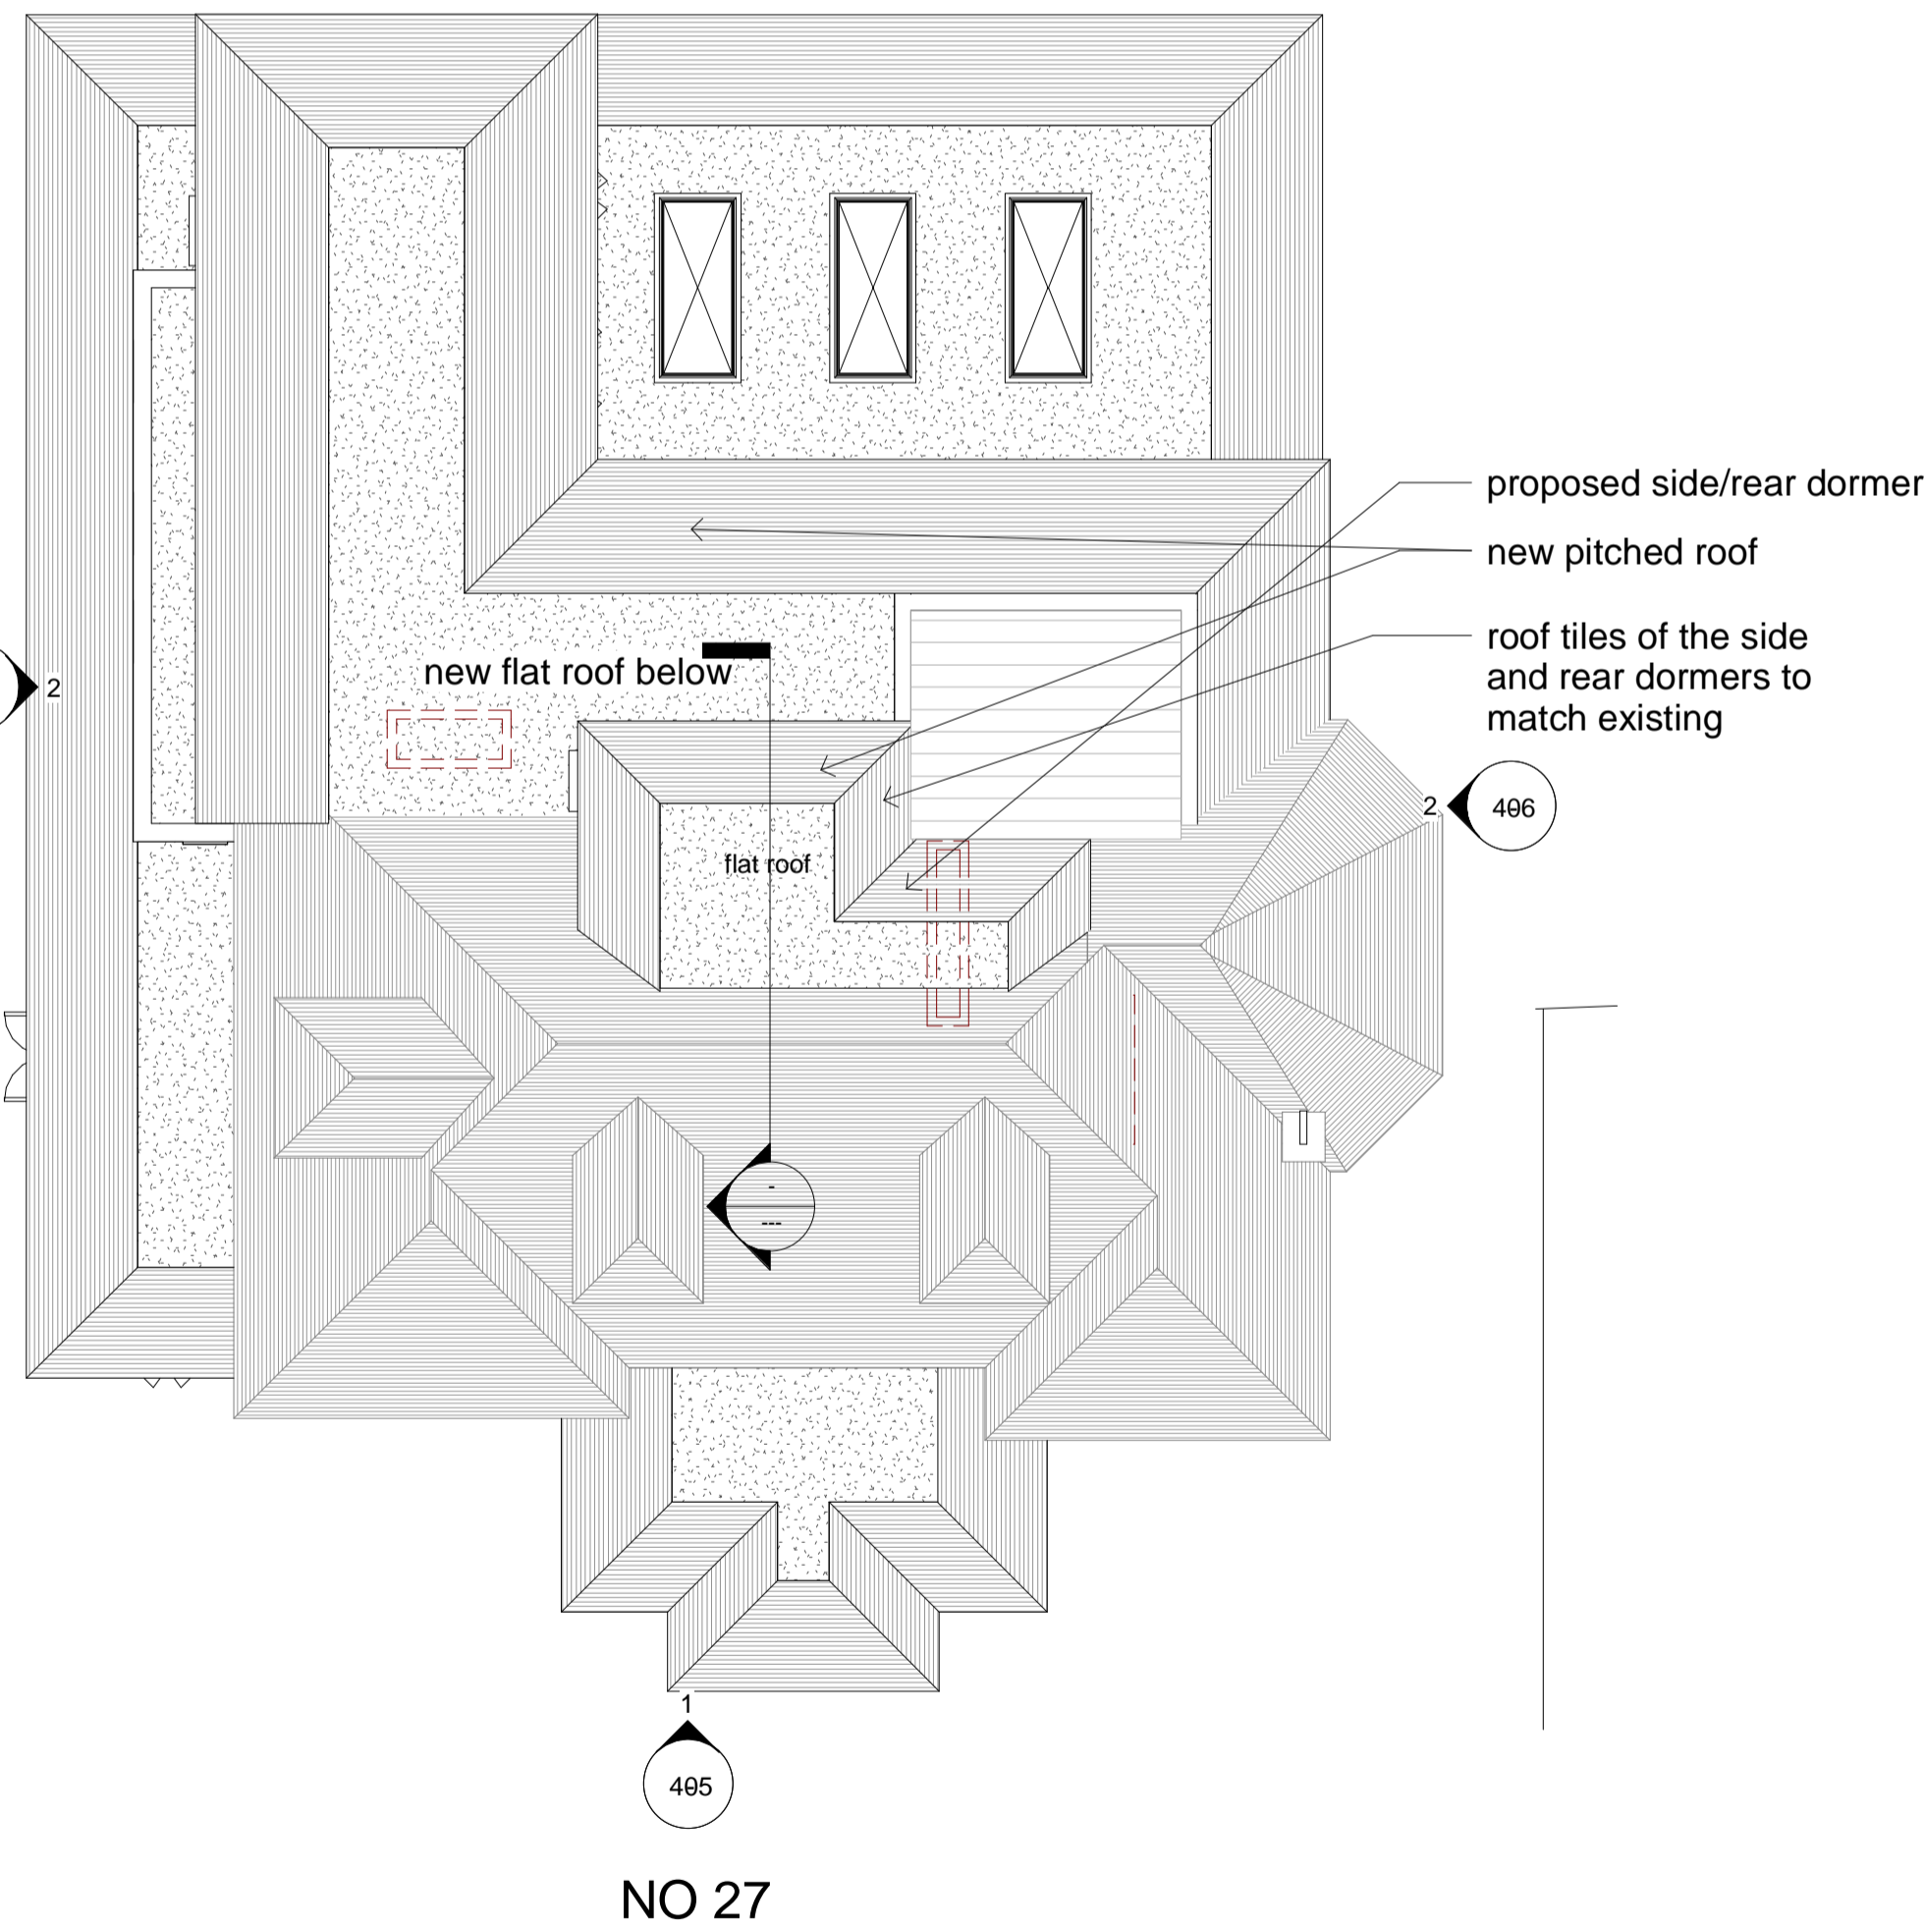
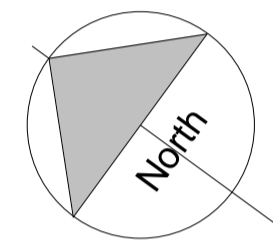



NOTES

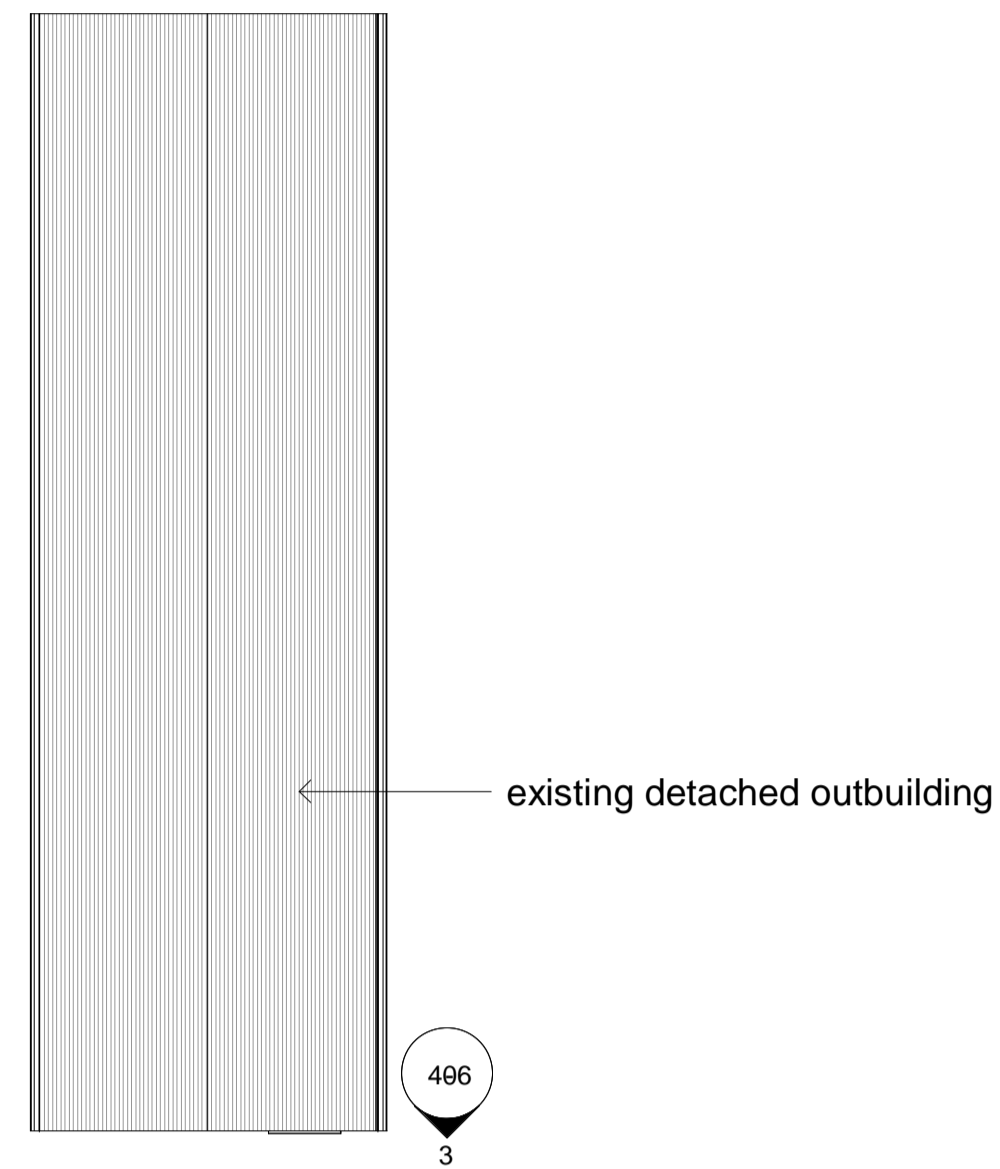


1 Roof Plan-As Built
1 : 100

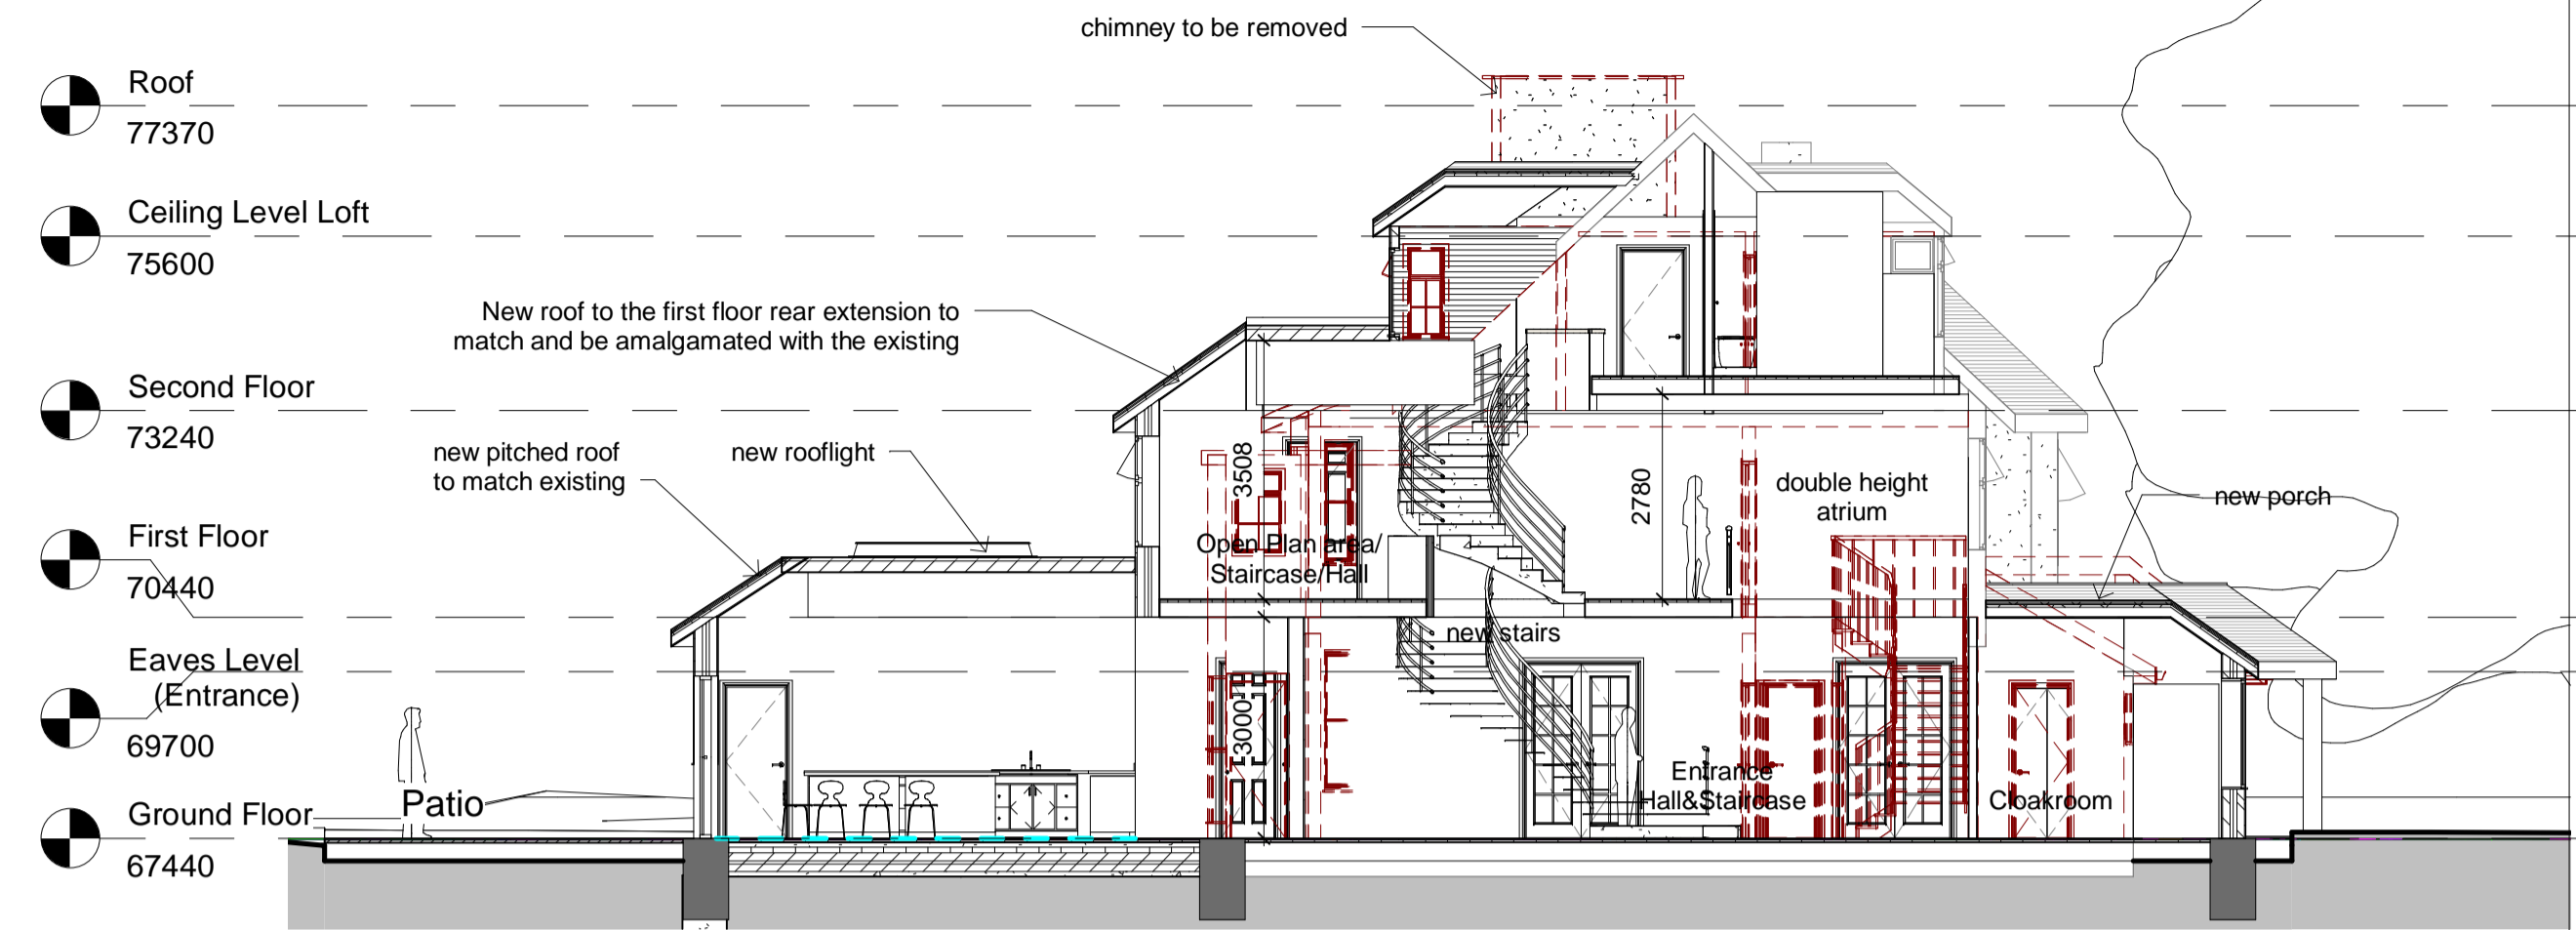

2 Proposed Longitudinal Section
1 : 100

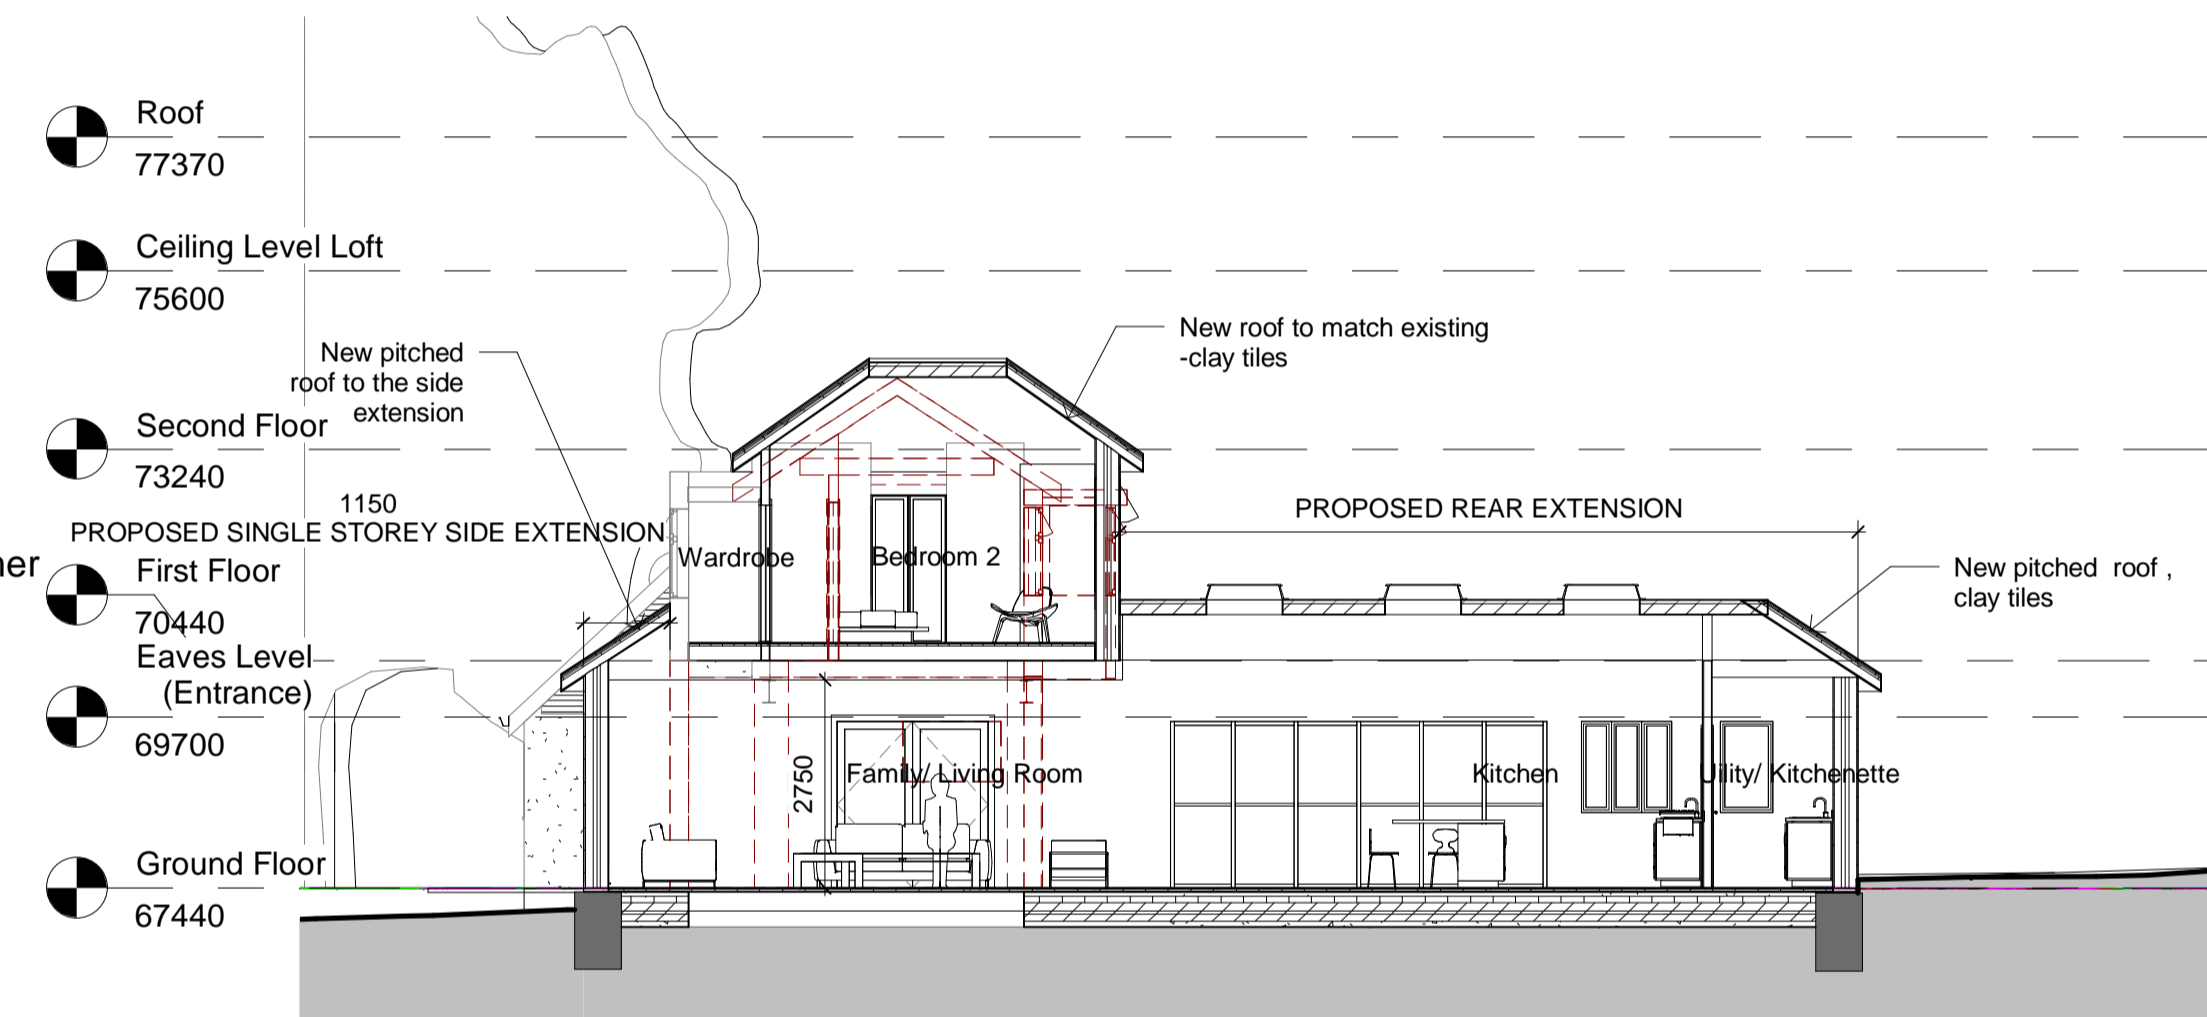

3 Proposed Cross Section
1 : 100

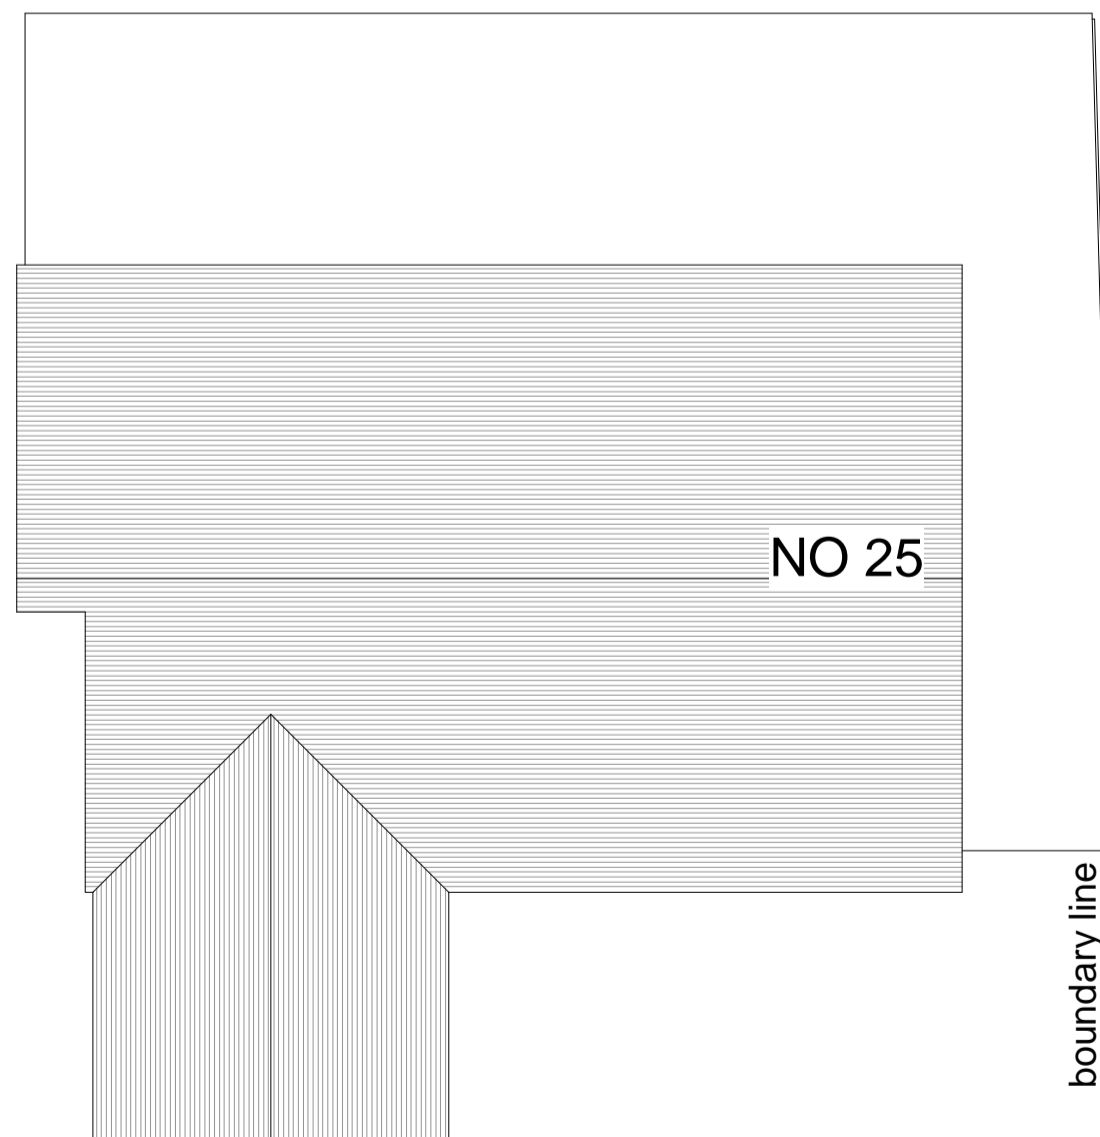

Rev.	Amendments	Date	Chkd.

Client
Mr Mohammad Farooq Azami

STS Structural Engineering Ltd
58 Crossway, Welwyn Garden City, Hertfordshire, AL8 7EE
Tel: 01707 695466 Fax: 01707 692006
Web: www.sts-se.co.uk Email: sia@sts-se.co.uk

Project
27 Burdon Lane, Cheam, Sutton, London SM2 7PP

Title
As Built Roof Plan and Proposed Sections

Drawn	NK	Date	Jul'21	Scale
Checked	MN DS	Date	Jul'21	1 : 100
Approved	SS	Date	Jul'21	Size A1

Drawing No. 1910-1220-404
Rev. -