




TSES- 20195- 806- MBS- 03
 -
 Originator | Project Number | Type | Number | Revision

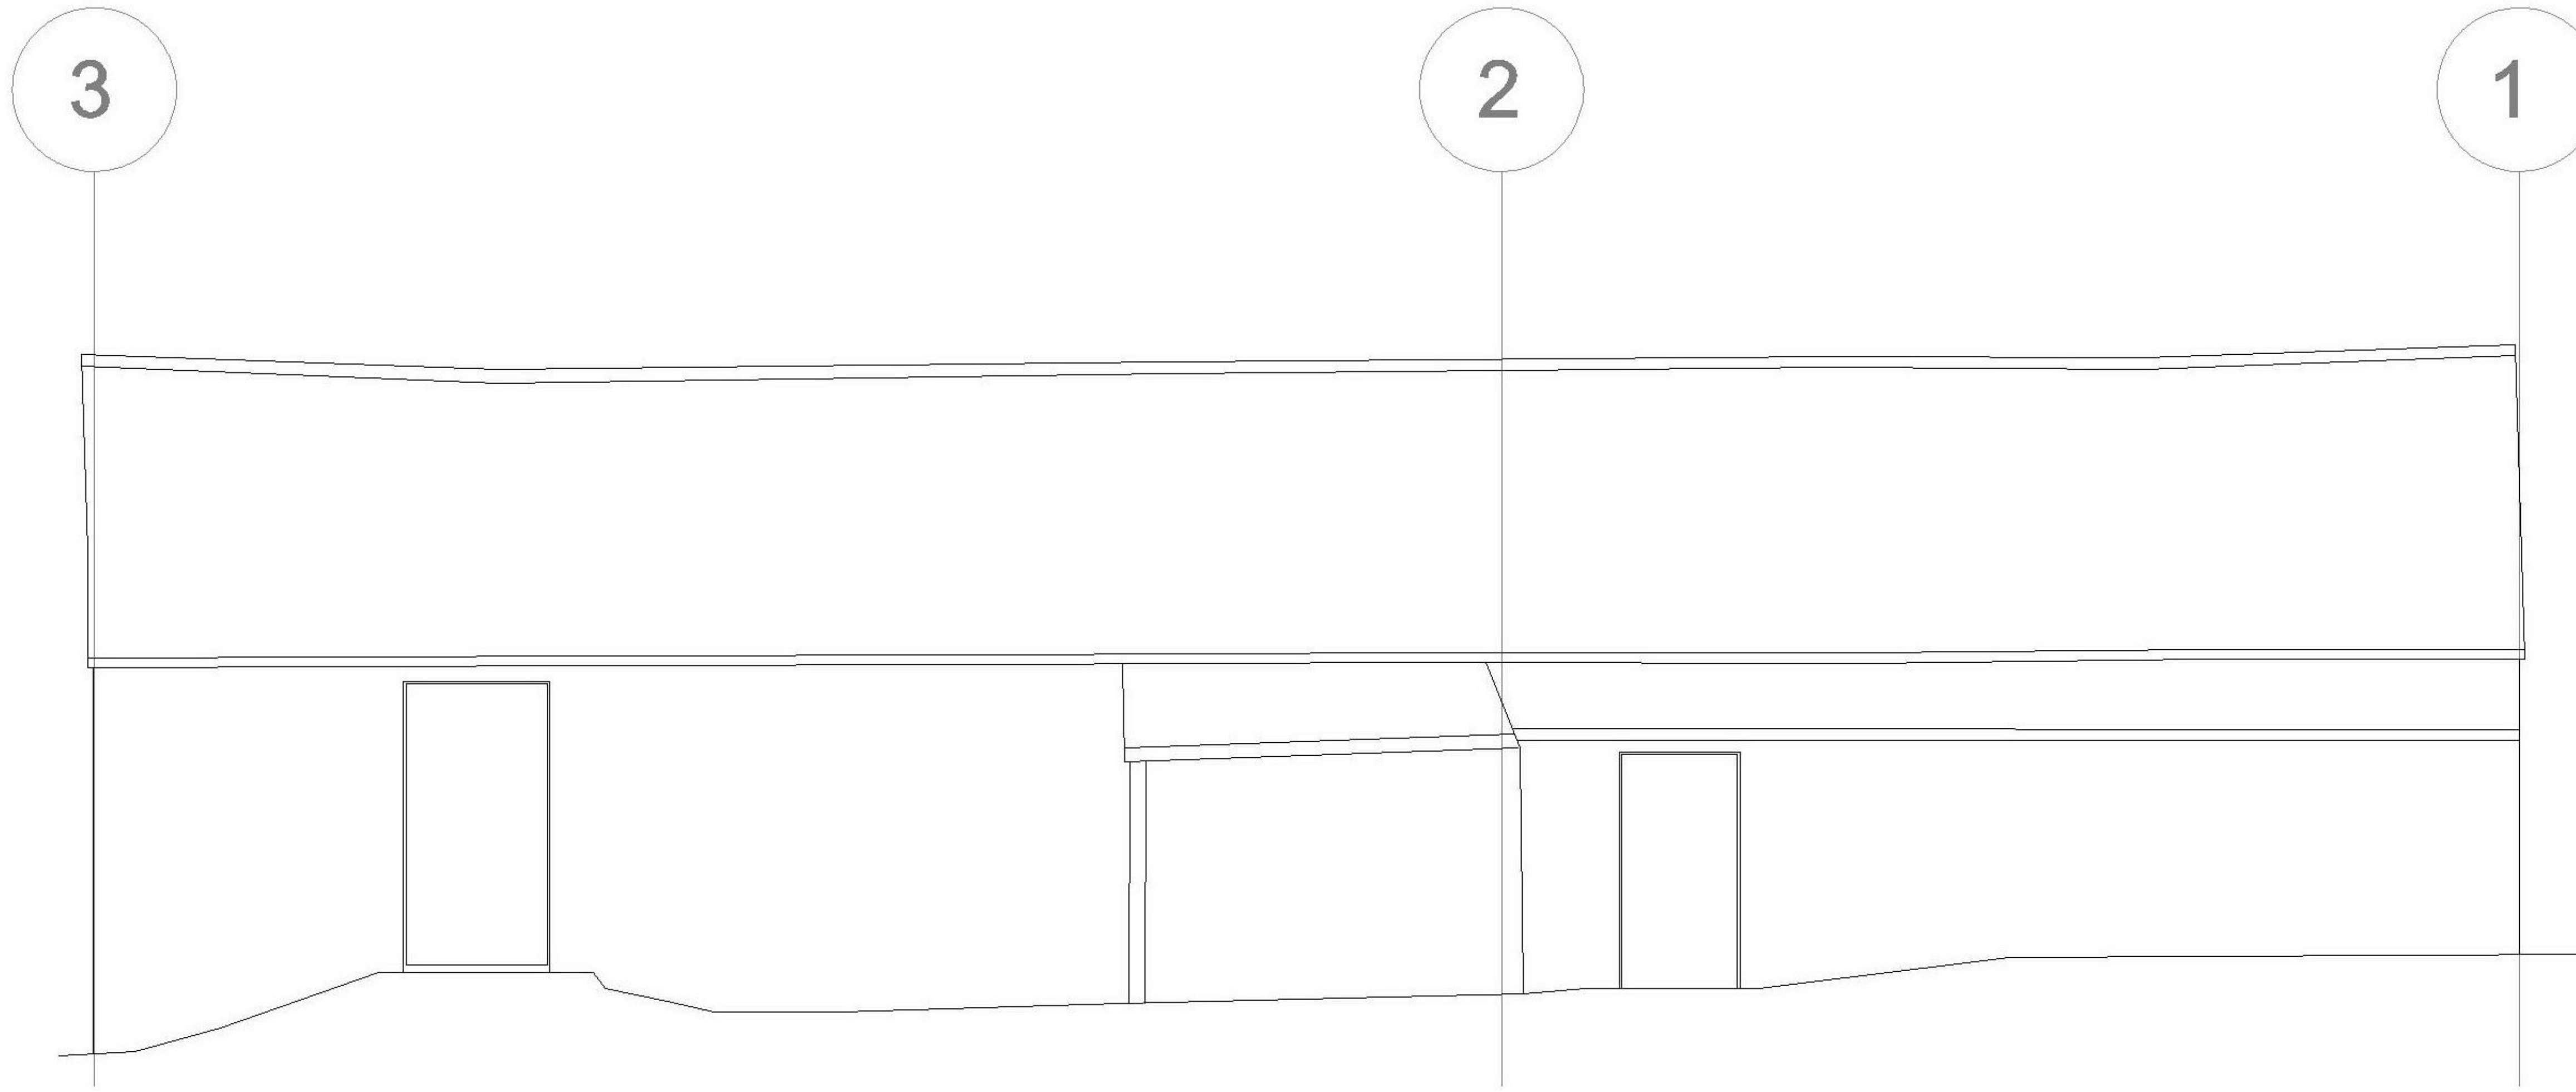

Datum = 68.000m
North West Elevation

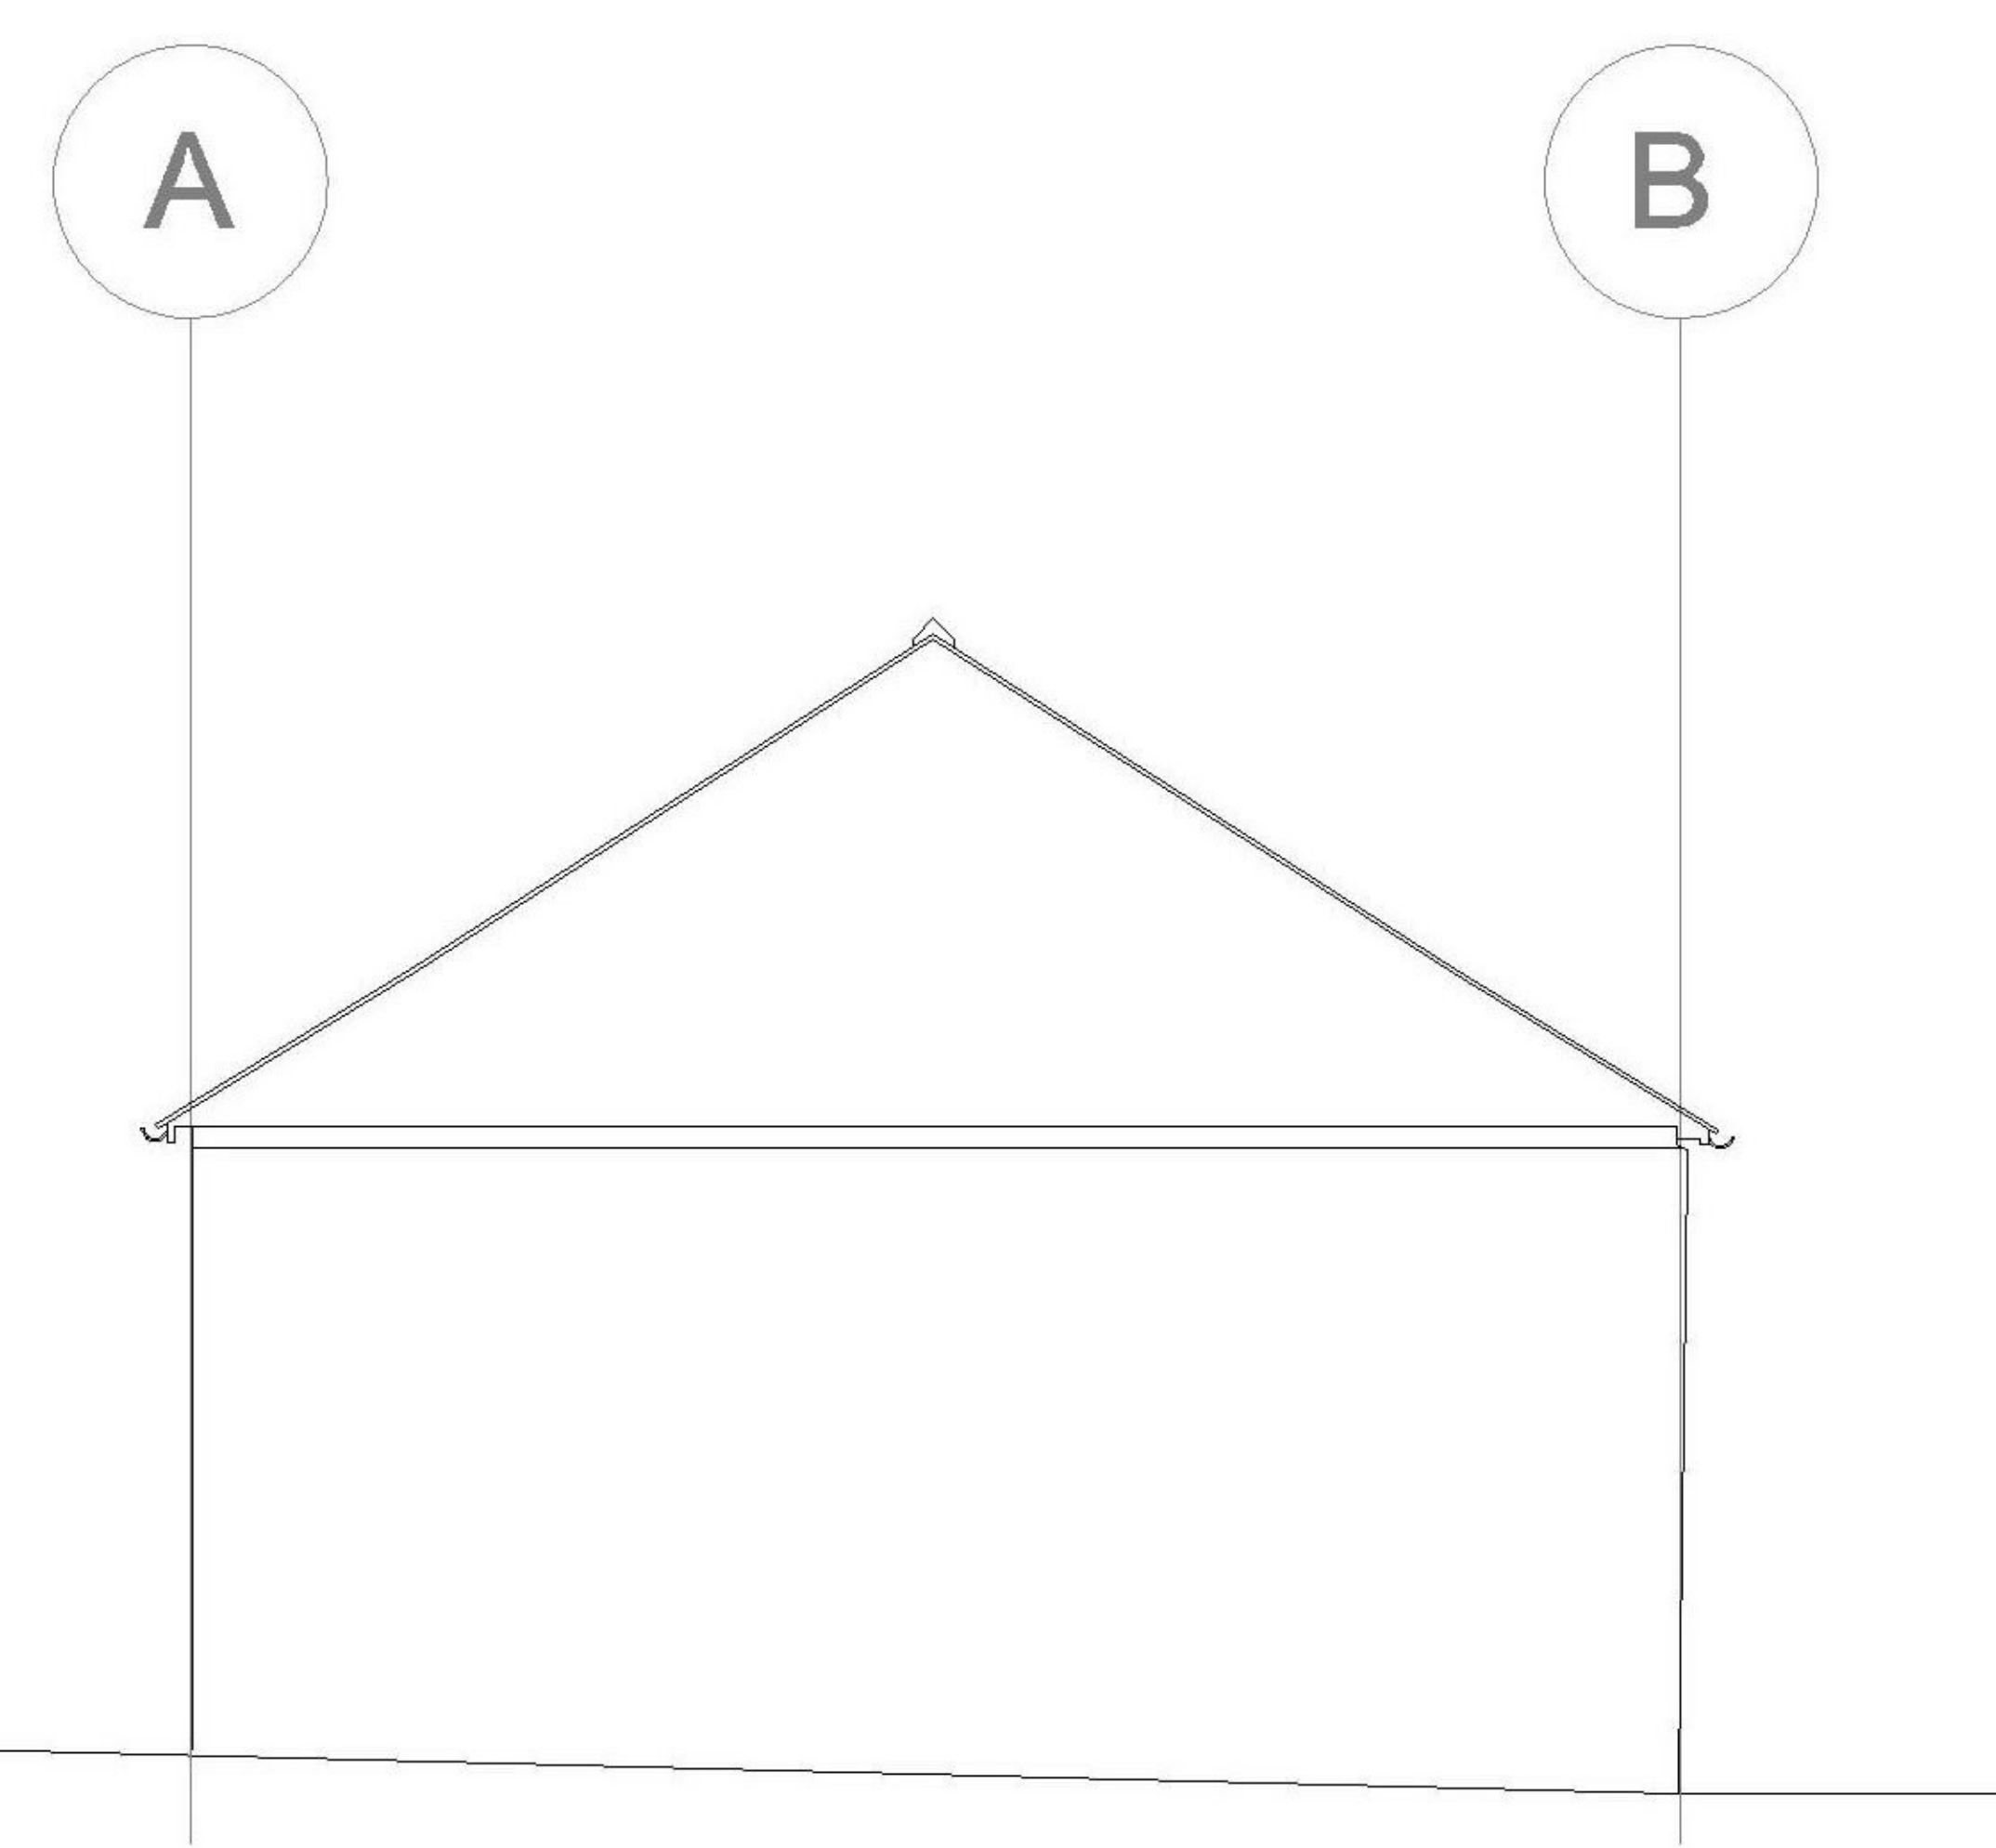

Datum = 68.000m
North East Elevation

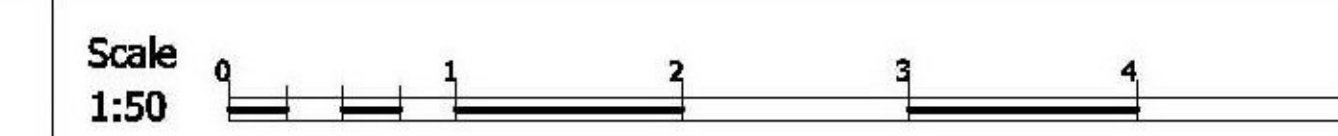

MBS Notes

Standard Abbreviations (where applicable)


AB	Air Brick
ACU	Air Conditioning Unit
AH	Access Hatch
AP	Access Panel
AV	Air Valve
BH	Beam Height
BR	Brick
BSL	Beam Soffit Level
CB	Cupboard
CC	Ceiling Change
CH	Clear Internal Height
CA	Chimney
CH	Chimney Head Height
C-S	Chimney to Spring Height
DB	Door Base Height
DR	Door Head Height
DR	Drain
EXF	Extractor Fan
FA	Fire Alarm
FA	Floor to Apex Height
F-C	Floor to Ceiling Height
F-H	Floor to Head Height
F-S	Floor to Spring Height
GEA	Gross External Area
GIA	Gross Internal Area
GU	Gully
HT	Heater
HW	Hot Water Tank
IA	Net Internal Area
NTS	Not to Scale
RD	Radiator
RE	Roof Eave Height
RFV	Raised Floor Void
RL	Roof Light
RSB	Roof Slope
RWP	Rain Water Pipe
SVP	Soil Vent Pipe
V	Vent
WA	Wardrobe

Symbols (where applicable)

- 0 Floor to Structural Ceiling Height
- 0 Floor to Suspended Ceiling Height
- ↘ Direction of Sloping Ceiling

- DH 2000 Floor to Door Head
- 10.00 Floor Level Relative to Datum

Building Heights

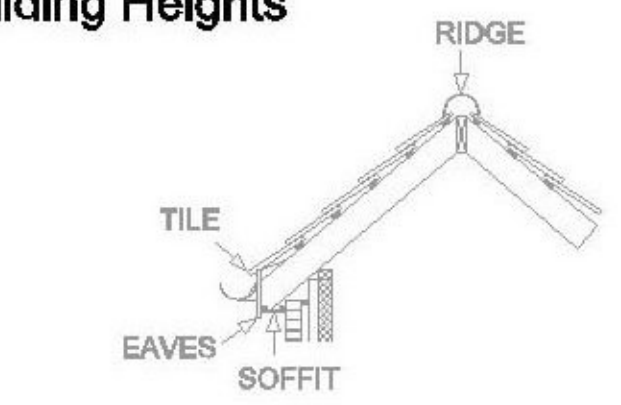

SURVEY CARRIED OUT USING PANDA PANDA 360 LASER SCANNER, TRIMBLE SP TOTAL STATION & TRIMBLE R10 GPS.
 THE SURVEY HAS BEEN ACCURATELY POSITIONED ON THE ORDNANCE SURVEY NATIONAL GRID SYSTEM (OSNG) OBSERVATIONS TO THE OS ACTIVE NETWORK AND THE LATEST ORDNANCE SURVEY TRANSFORMATION (OSNG2019).
 ALL LEVELS RELATE TO ORDNANCE SURVEY DATUM (OSNGVD). VERTICAL CONTROL HAS BEEN ESTABLISHED USING GPS OBSERVATIONS TO THE OS ACTIVE NETWORK AND THE LATEST ORDNANCE SURVEY TRANSFORMATION (OSNG2019).
 ALL DIMENSIONS ARE IN METRES UNLESS OTHERWISE STATED.
 ANY CRITICAL DIMENSIONS AND MEASUREMENTS SHOULD BE BASED ON THE ORIGINAL DIGITAL DATA AND COMPARED WITH TARGET SES LTD.
 ANY ERRORS SHOULD BE NOTIFIED TO TARGET SES LTD.

REV	DATE	TH	FLAT ISSUE	COMMENTS
-	06.06.21	TH	Flat Issue	

Scale at A1	1:50	Project Number	20195-806
-------------	------	----------------	-----------

<input checked="" type="checkbox"/> Measured Building Survey <input type="checkbox"/> As Built Survey <input type="checkbox"/> For Information



2 Flint Cottages, Lackford,
Bury St Edmunds, Suffolk, IP28 6HW
t: 01284 711476
m: 07557 734388
e: info@targettd.co.uk

Client: **Hartog Hutton**

Project: **Lower Farm Great Saxham**

Title: **Measured Building Survey North Elevations**

TSES- 20195- 806- MBS- 03				-
Originator	Project Number	Type	Number	Revision