


APPROVED AND AS BUILT SITE PLAN

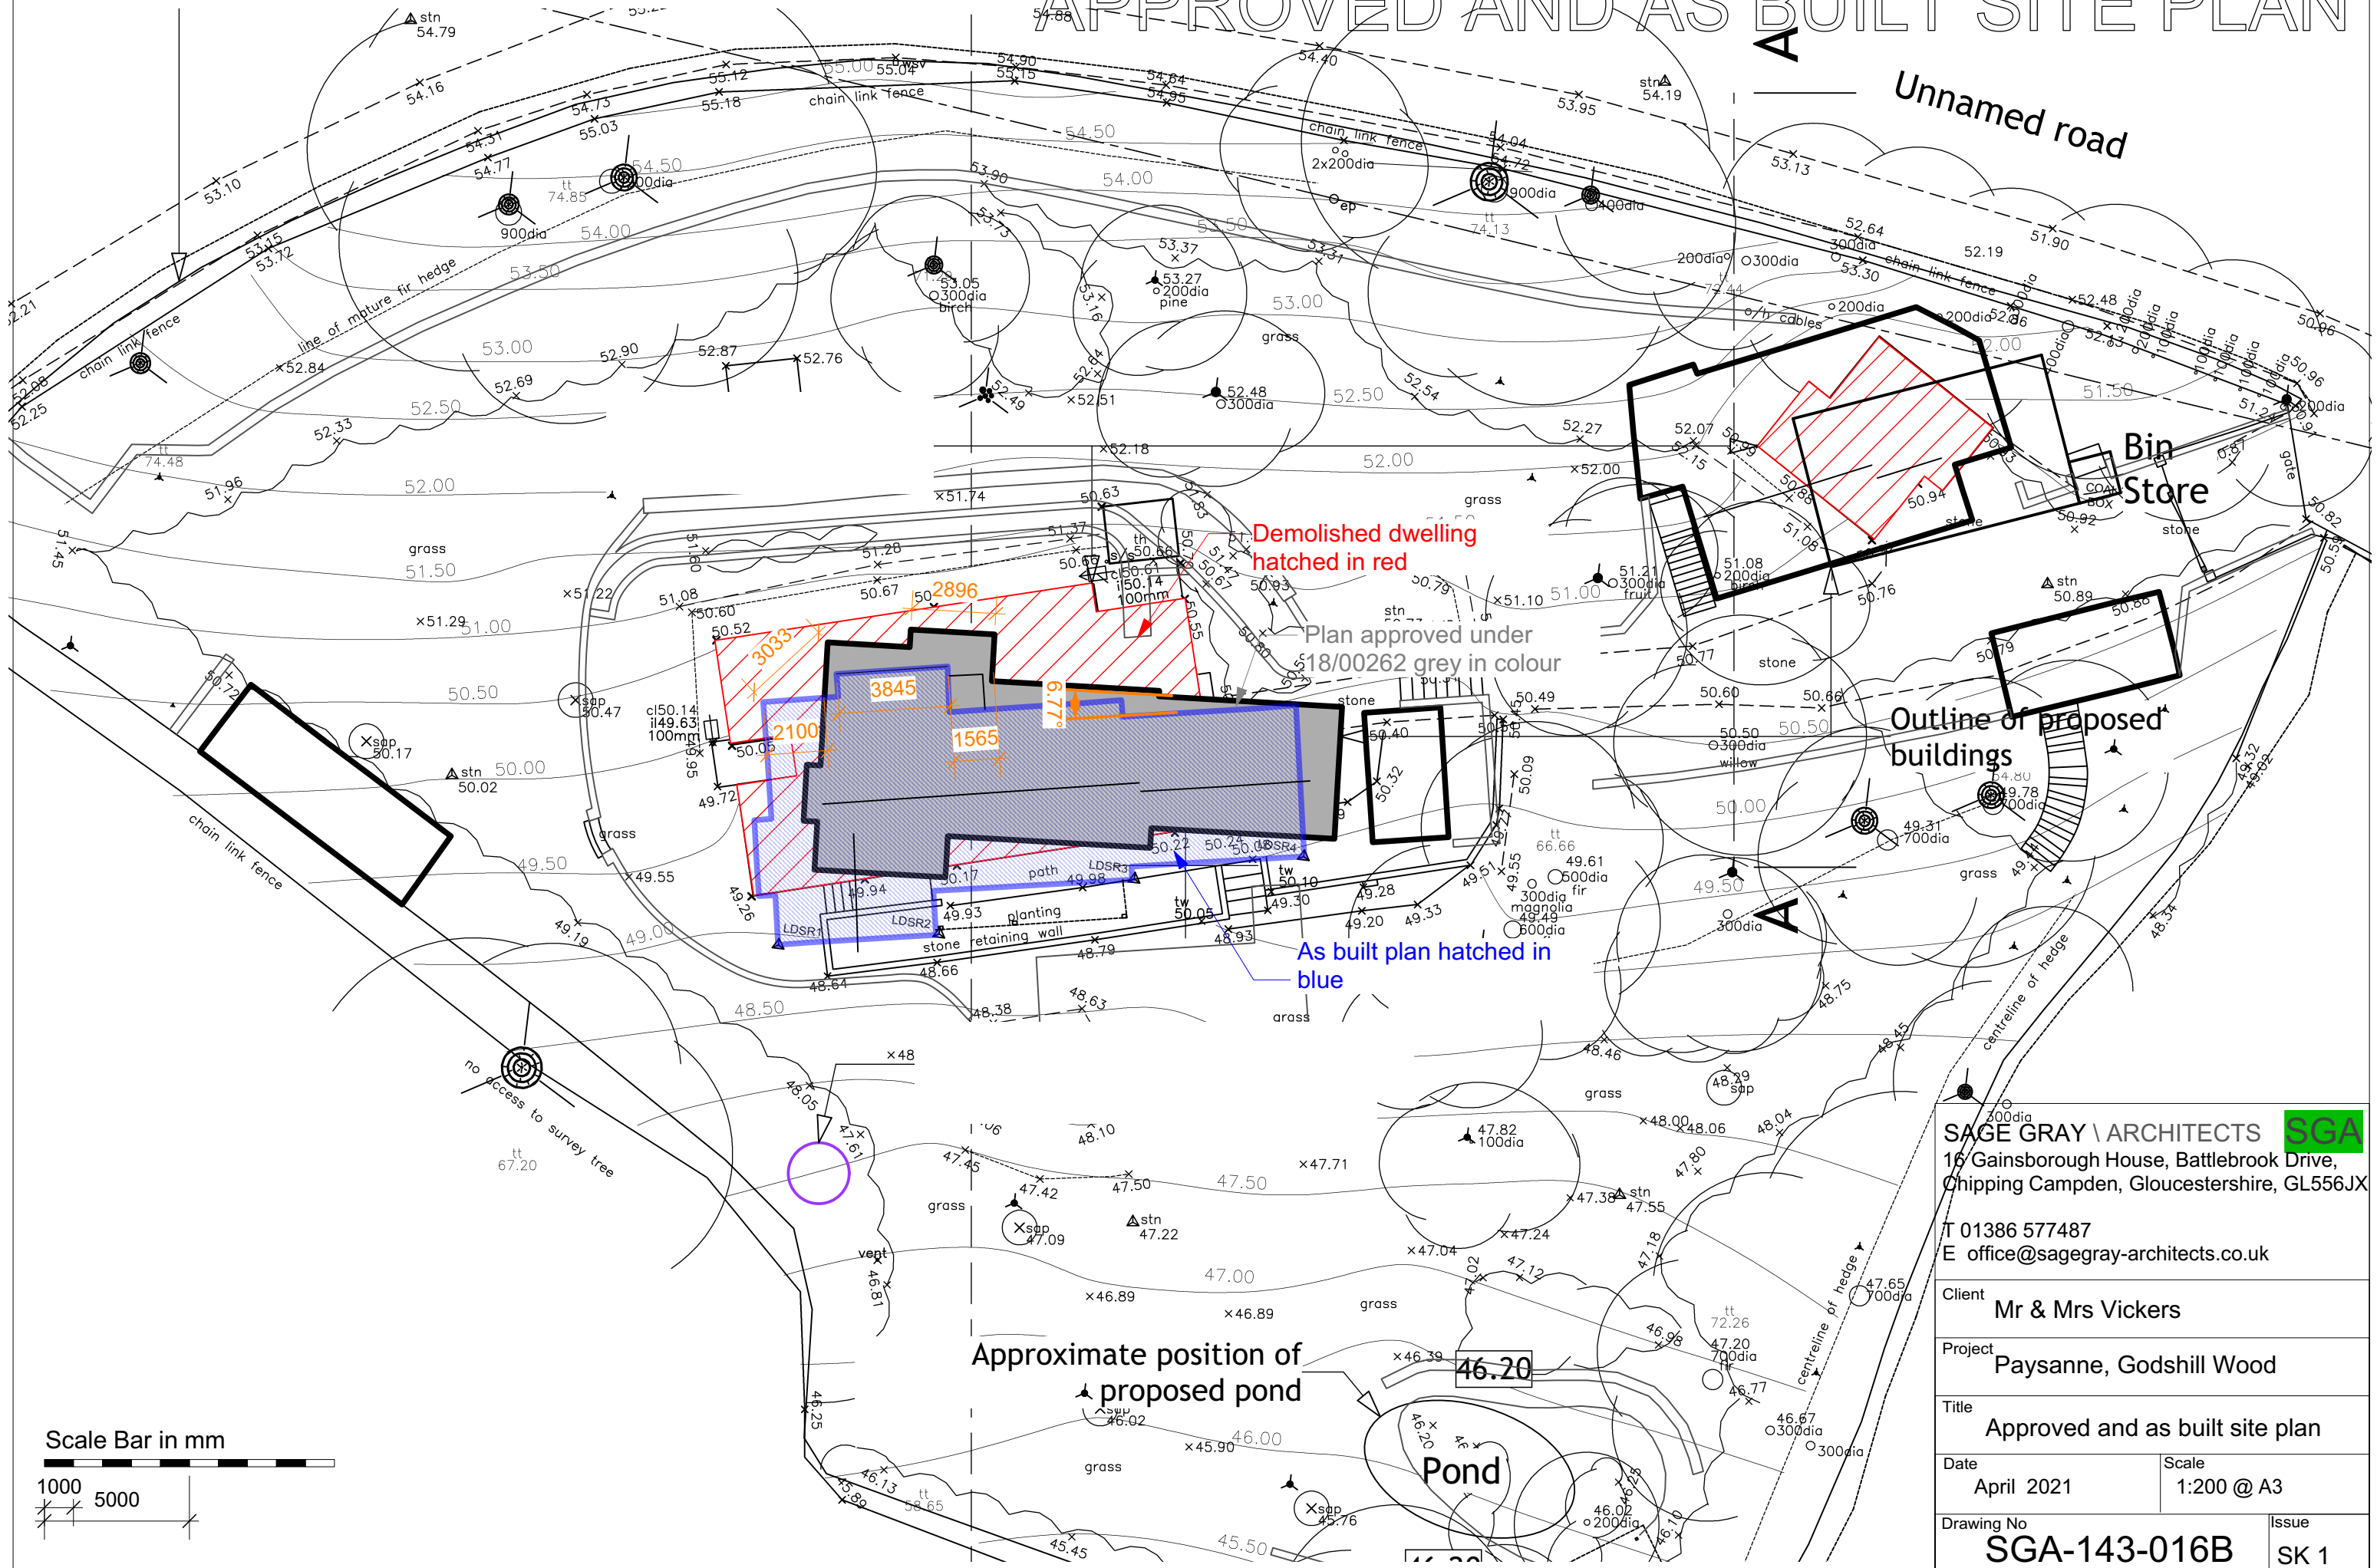

SAGE GRAY ARCHITECTS  16 Gainsborough House, Battlebrook Drive, Chipping Campden, Gloucestershire, GL556JX	
T 01386 577487 E office@sagegray-architects.co.uk	
Client Mr & Mrs Vickers	
Project Paysanne, Godshill Wood	
Title Approved and as built site plan	
Date April 2021	Scale 1:200 @ A3
Drawing No SGA-143-016B	Issue SK 1