




NORTH ELEVATION



WEST ELEVATION


47.00m Datum Line

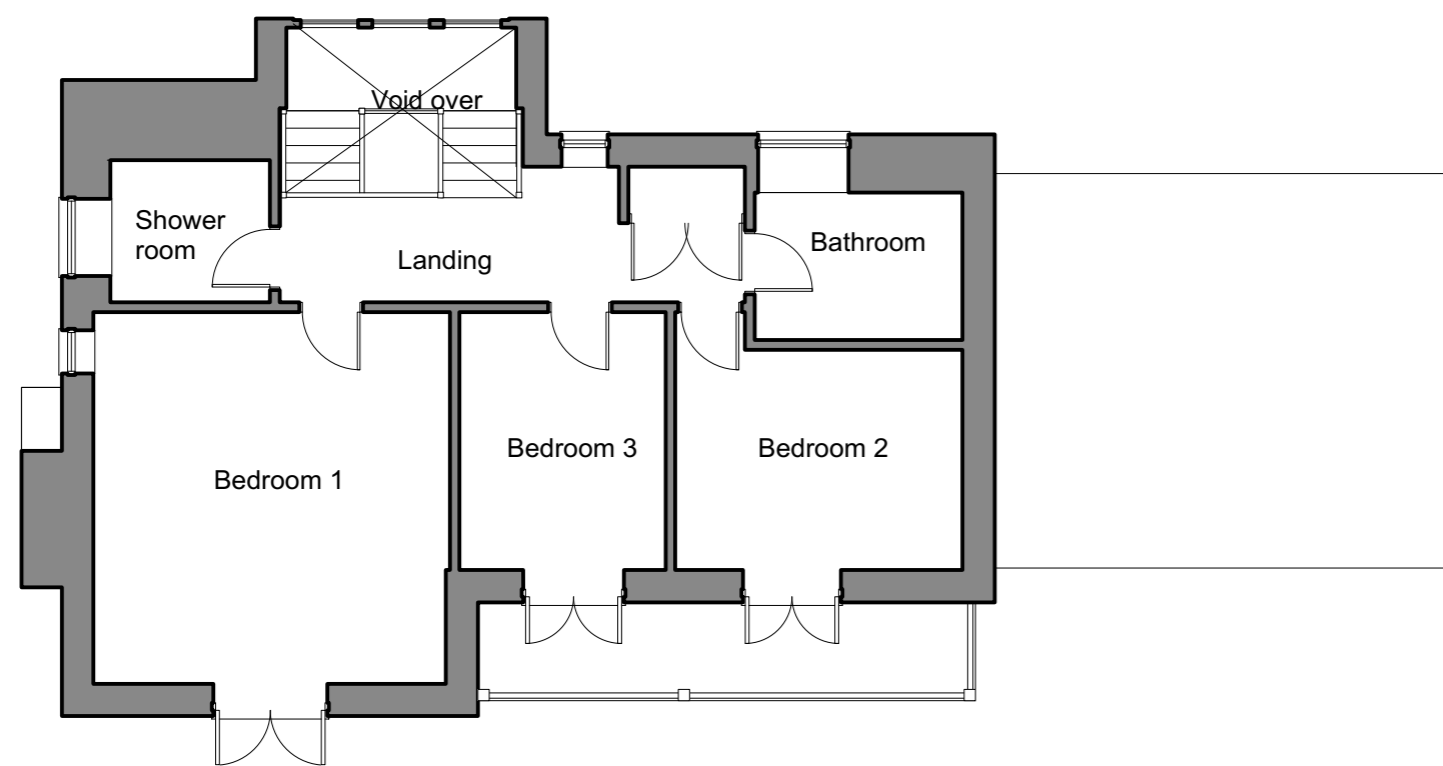

FIRST FLOOR PLAN



SOUTH ELEVATION

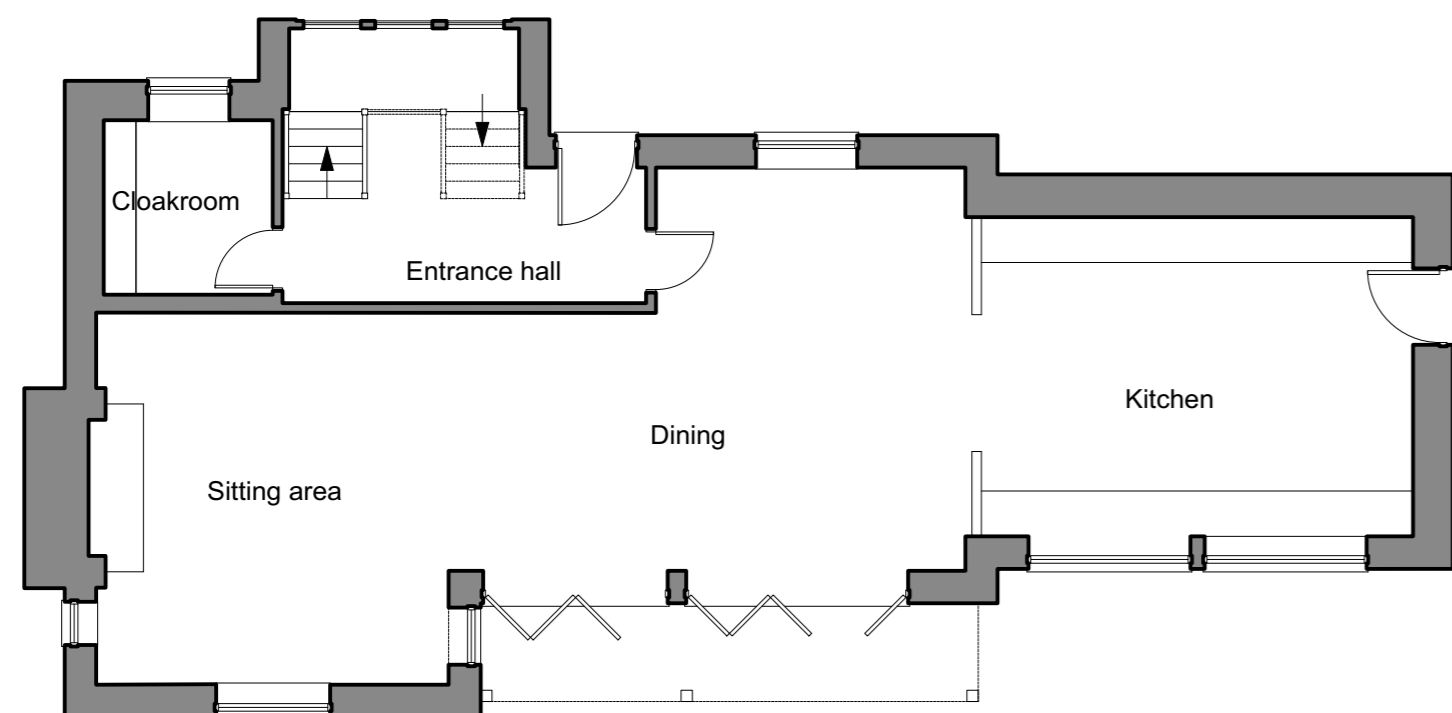

GROUND FLOOR PLAN



EAST ELEVATION

NB The elevations and external footprint are as surveyed by LDS ltd. Poole, Dorset.  
The internal layouts are based on Symmetry Architecture's drawing 1530-SYM-ZZ-00-D2-A-0214 P07 and internal check dimensions by the clients

REV	Note	Date
C	Drawing amended as per letter from registration team at LPA	13.8.21
B	Scale and drawing size amended	30.7.21
A	Internal layout adjusted to clients dims	12.7.21

**SAGE GRAY \ ARCHITECTS**  
16 Gainsborough House, Battlebrook Drive,  
Chipping Campden, Gloucestershire, GL556JX

T 01386 577487  
E office@sagegray-architects.co.uk

Client **Mr & Mrs Vickers**

Project **Paysanne, Godshill Wood**

Title **As Built plans and elevations**

Date **June 2021** Scale **1:100 @ A2**

Drawing No **SGA-143-103C** Issue **PL1**



Scale bar in metres

