



FLOOR PLANS UNITS H - L

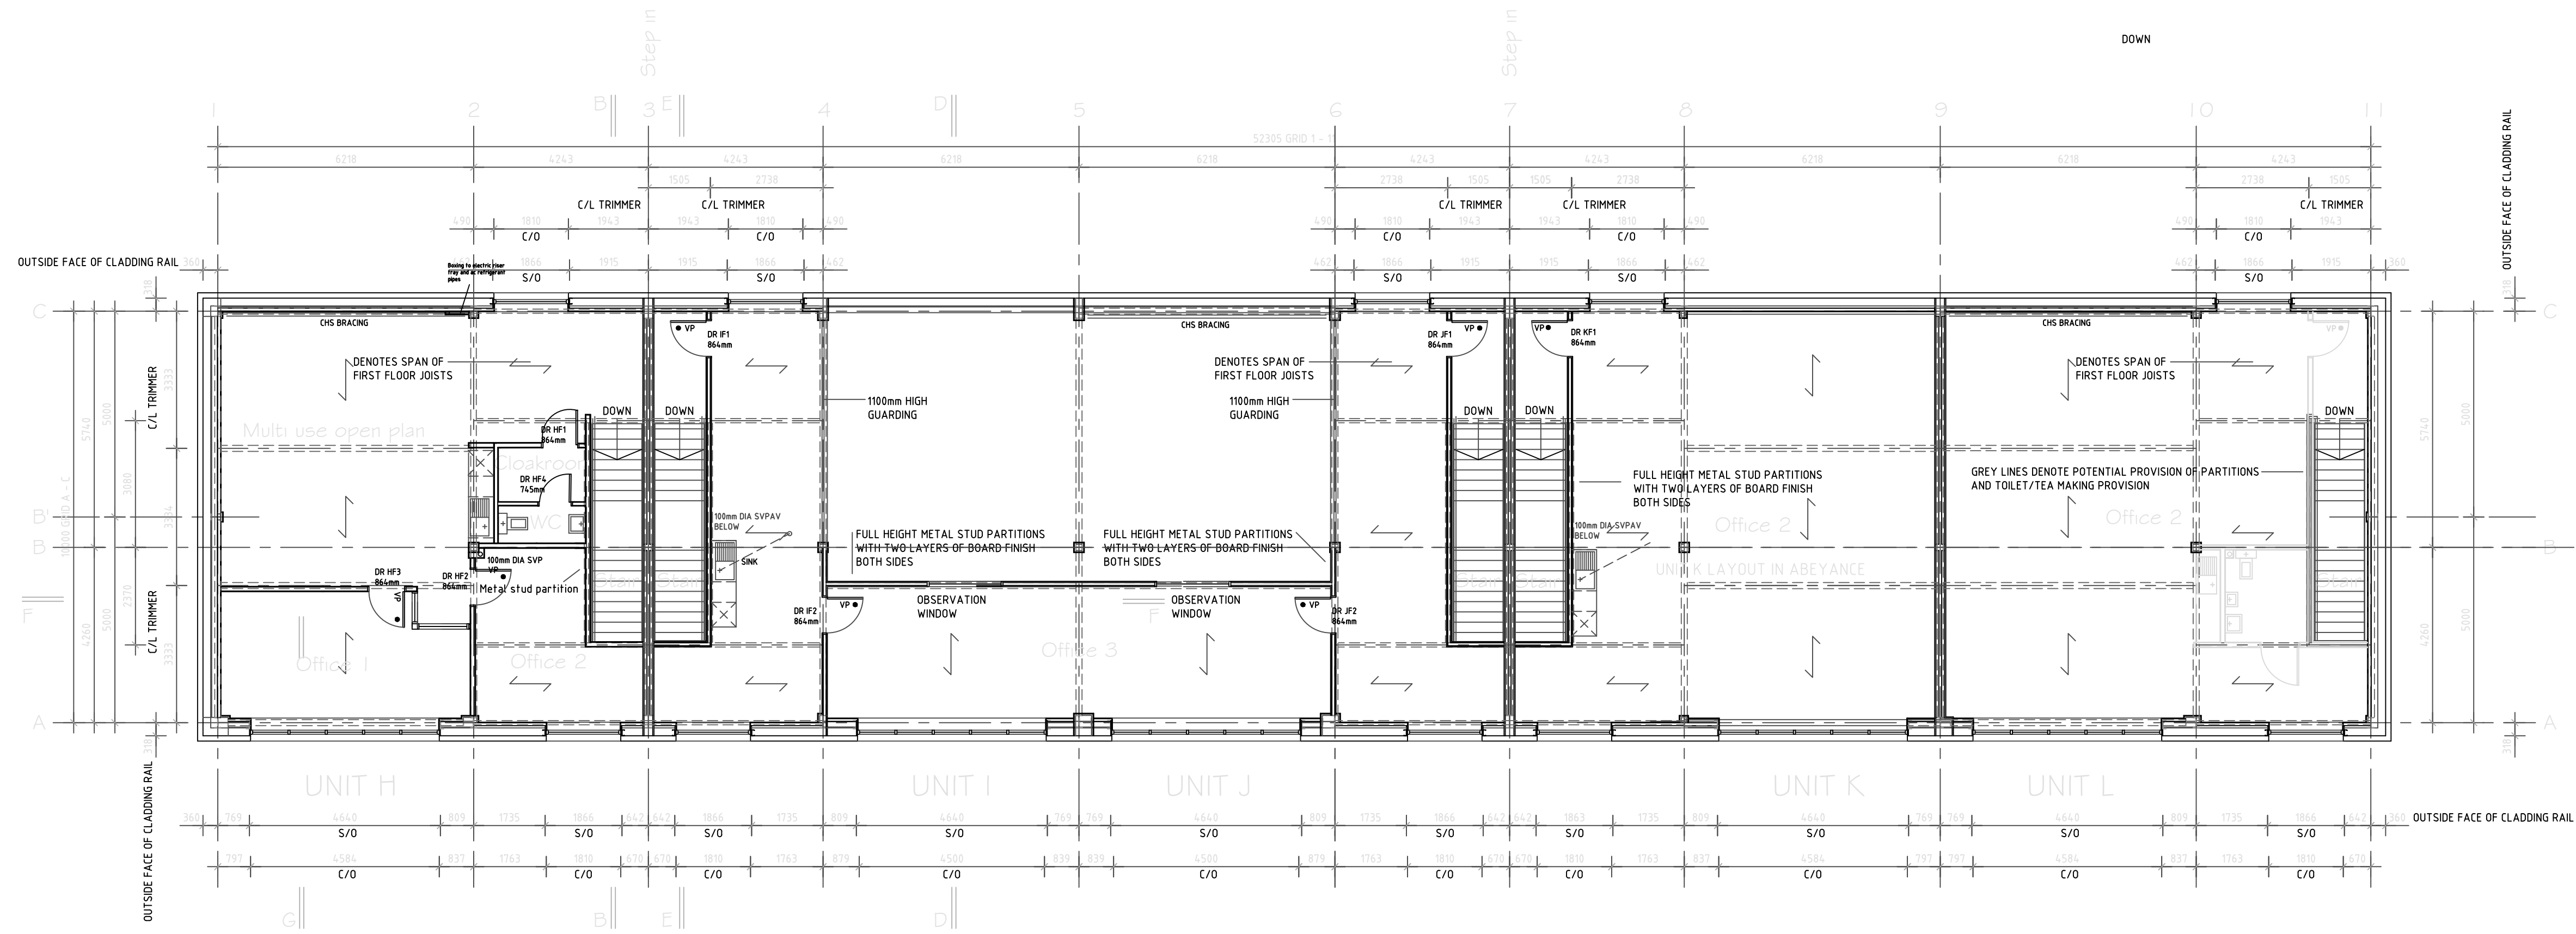

First Floor Plan

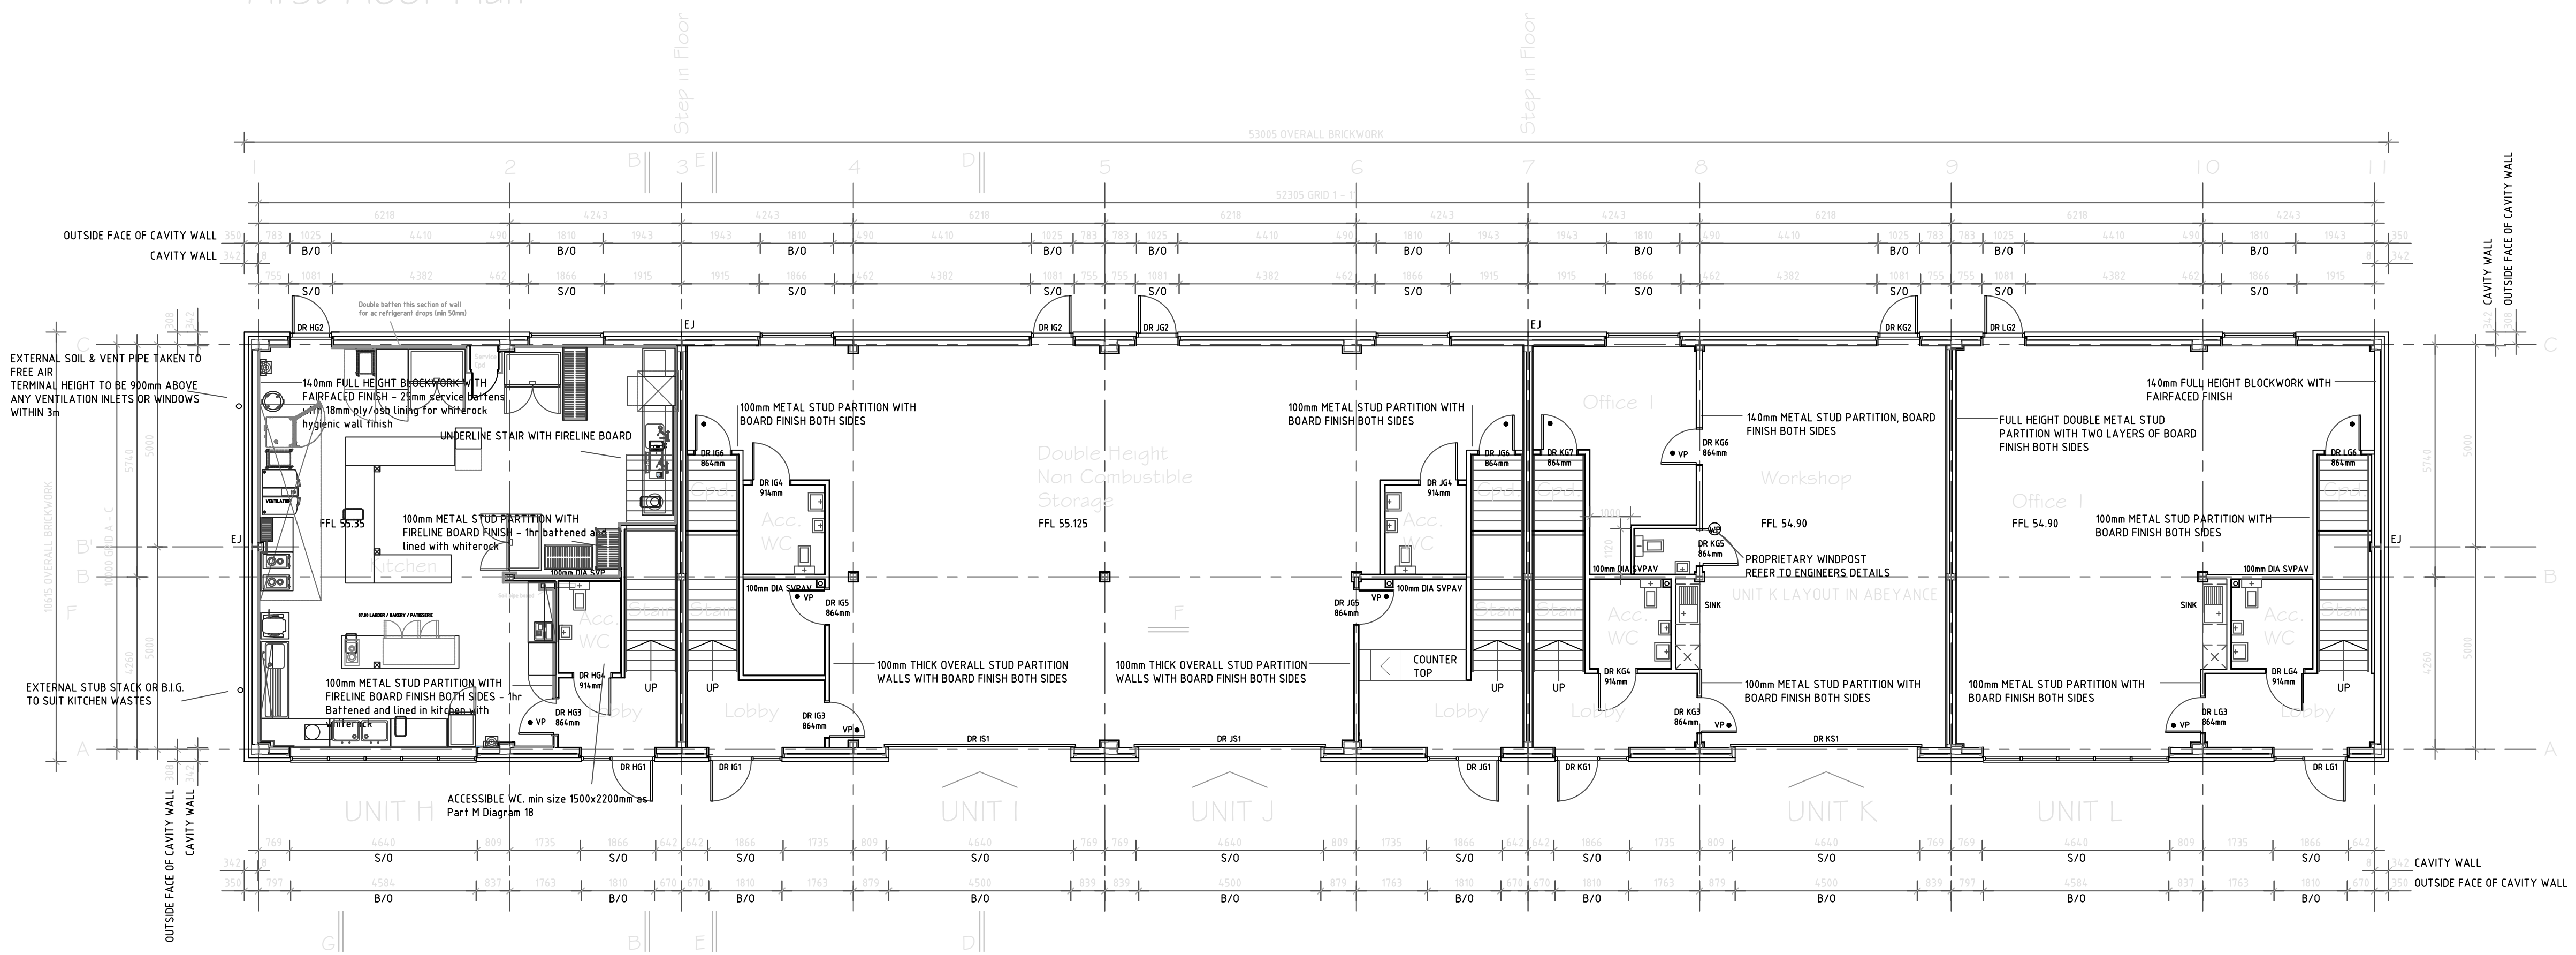

Ground Floor Plan

GENERAL NOTE
 S/O DENOTES STRUCTURAL OPENING AT DOOR/WINDOW OPENINGS TO ACCOMMODATE INSULATED FLASHINGS
 25mm RIGID INSULATION BOARD AT PEDESTRIAN DOOR/WINDOW AND SCREEN OPENINGS
 70mm RIGID INSULATION BOARD AT VEHICLE ACCESS DOOR OPENINGS
 B/O DENOTES CLEAR OPENING AT DOOR/WINDOW AND SCREEN OPENINGS WITHIN BRICKWORK
 C/O DENOTES CLEAR OPENING WIDTH AT DOOR/WINDOW AND SCREEN OPENINGS WITHIN CLADDING

- REV C9 RISER CUPBOARD ADDED. DOUBLE BATTEN REAR WALL OS&S 15.12.17
- REV C8 UNIT H FF WC PARTITION ADDED OS&S 6.7.21
- REV C7 UNIT H PARTITIONS AMENDED TO AS BUILT POSITIONS OS&S 28.5.21
- REV C6 UNIT H RECONFIGURED FOR END USER OS&S 19.5.21
- REV C5 UNIT H FIRST FLOOR OPEN PLAN OFFICE 2 CREATED. PARTITION TO STAIRWELL ADDED WITH DOOR AT HEAD. KITCHENETTE ADDED. GROUND FLOOR OFFICE 1 ALTERED. WC ADDED. GF PARTITIONS CHANGED TO METAL STUD OS&S 8.3.21
- REV C4 UNIT I COUNTER REMOVED AND WALL ADDED. UNIT J DOOR J63 REMOVED OS&S 18.1.21
- REV C3 BLOCK/STUD ANNOTATION ADDED TO UNITS I & J 01.12.2020
- REV C2 TENANT ALTERATIONS ADDED TO UNITS I & J AND UNIT L OPTIONS ADDED 27.11.2020
- REV C1 CONSTRUCTION ISSUE 27.11.18
- REV P6 PRELIMINARY ISSUE UNITS H, K & L AMENDED TO SUIT CLIENTS REQUIREMENTS 06.11.18
- REV P5 PRELIMINARY ISSUE WALLS INCREASED FROM 100mm TO 140mm THICK WITH WIND POSTS BETWEEN OFFICE 1 AND WORKSHOP TO SUIT ENGINEER REQUIREMENTS 29.08.17
- REV P4 PRELIMINARY ISSUE STEELWORK ARRANGEMENT REVISED TO SUIT STRUCTURAL STEELWORK RE-DESIGN 09.06.17
- REV P3 PRELIMINARY ISSUE STEP IN FLOOR LEVELS ADDED/UNITS I-J, K-L HANDED/ACCESSIBLE TOILETS HANDED 19.03.17
- REV P2 PRELIMINARY ISSUE 02.02.17
- REV P1 PRELIMINARY ISSUE 18.01.17

PROJECT
 Proposed Commercial Development
 at Elm Farm Park
 Great Green, Thurston
 Bury St Edmunds, IP31 3SH
 for HAYDON HOLDINGS LTD
 SCALE 1:100@A1 DATE Jan. 2017
 DRAWN CHD/AUTHD.

David Clarke & Associates
 TURRET HOUSE
 TURRET LANE
 IPSWICH
 IP4 1DL
 Tel: 01473 213563
 Email: mail@dcaspswich.co.uk

DRAWING NUMBER
4620-20 C9
 REVISION
 © THIS DRAWING MUST NOT BE REPRODUCED IN WHOLE OR IN PART WITHOUT WRITTEN CONSENT. DO NOT SCALE FROM THIS DRAWING. ALL DIMENSIONS ARE TO BE CHECKED AND VERIFIED ON SITE AND ALL DISCREPANCIES REPORTED TO DAVID CLARKE AND ASSOCIATES PRIOR TO CONSTRUCTION WORK TAKING PLACE.
 FLOOR PLANS UNITS H - L