



Existing Front Elevation

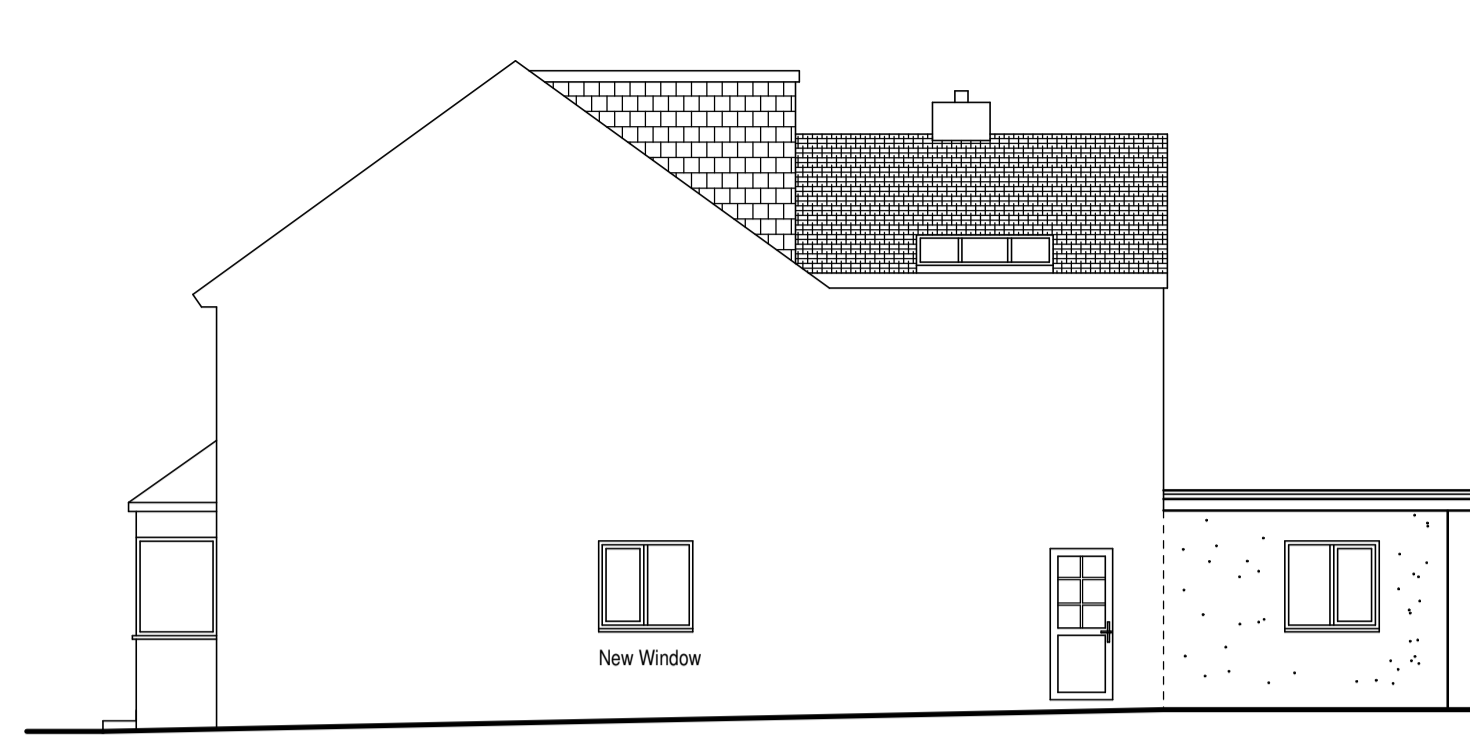


Existing Right Elevation


Flat Roof  
Existing Single Storey Extension  
To Be Retained  
Upvc Windows  
Painted Render To Match Existing

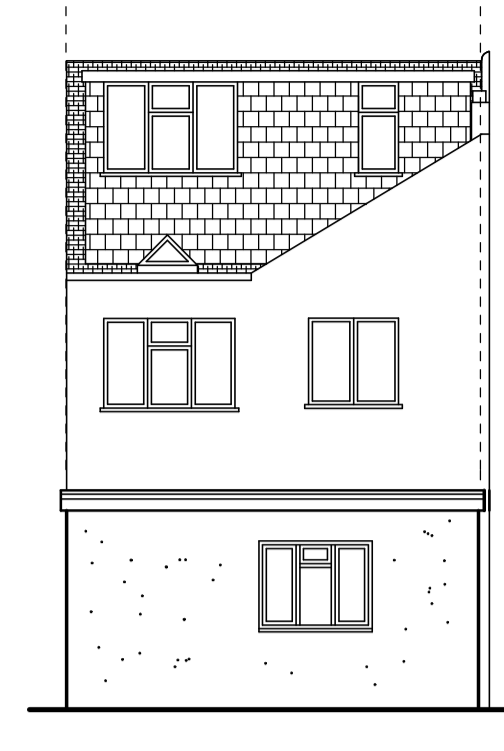


Existing Rear Elevation

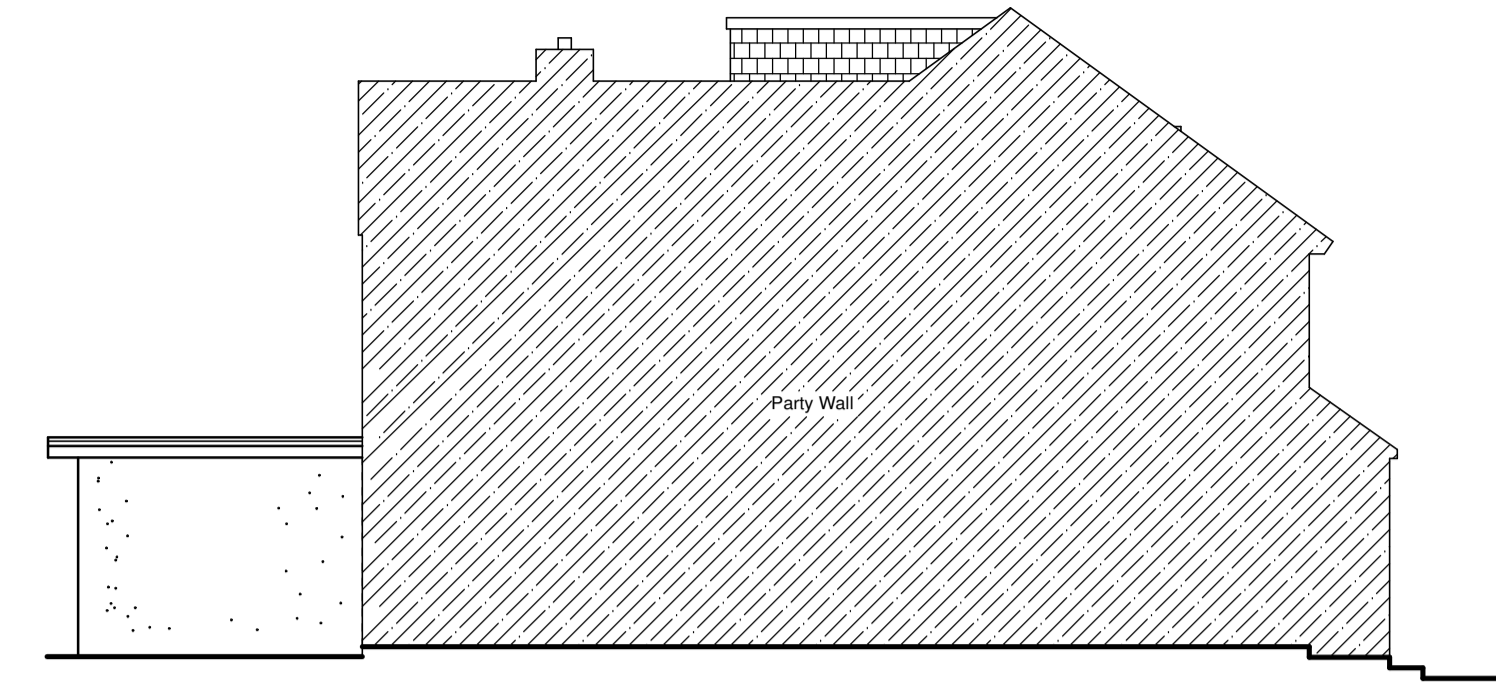


Existing Left Elevation

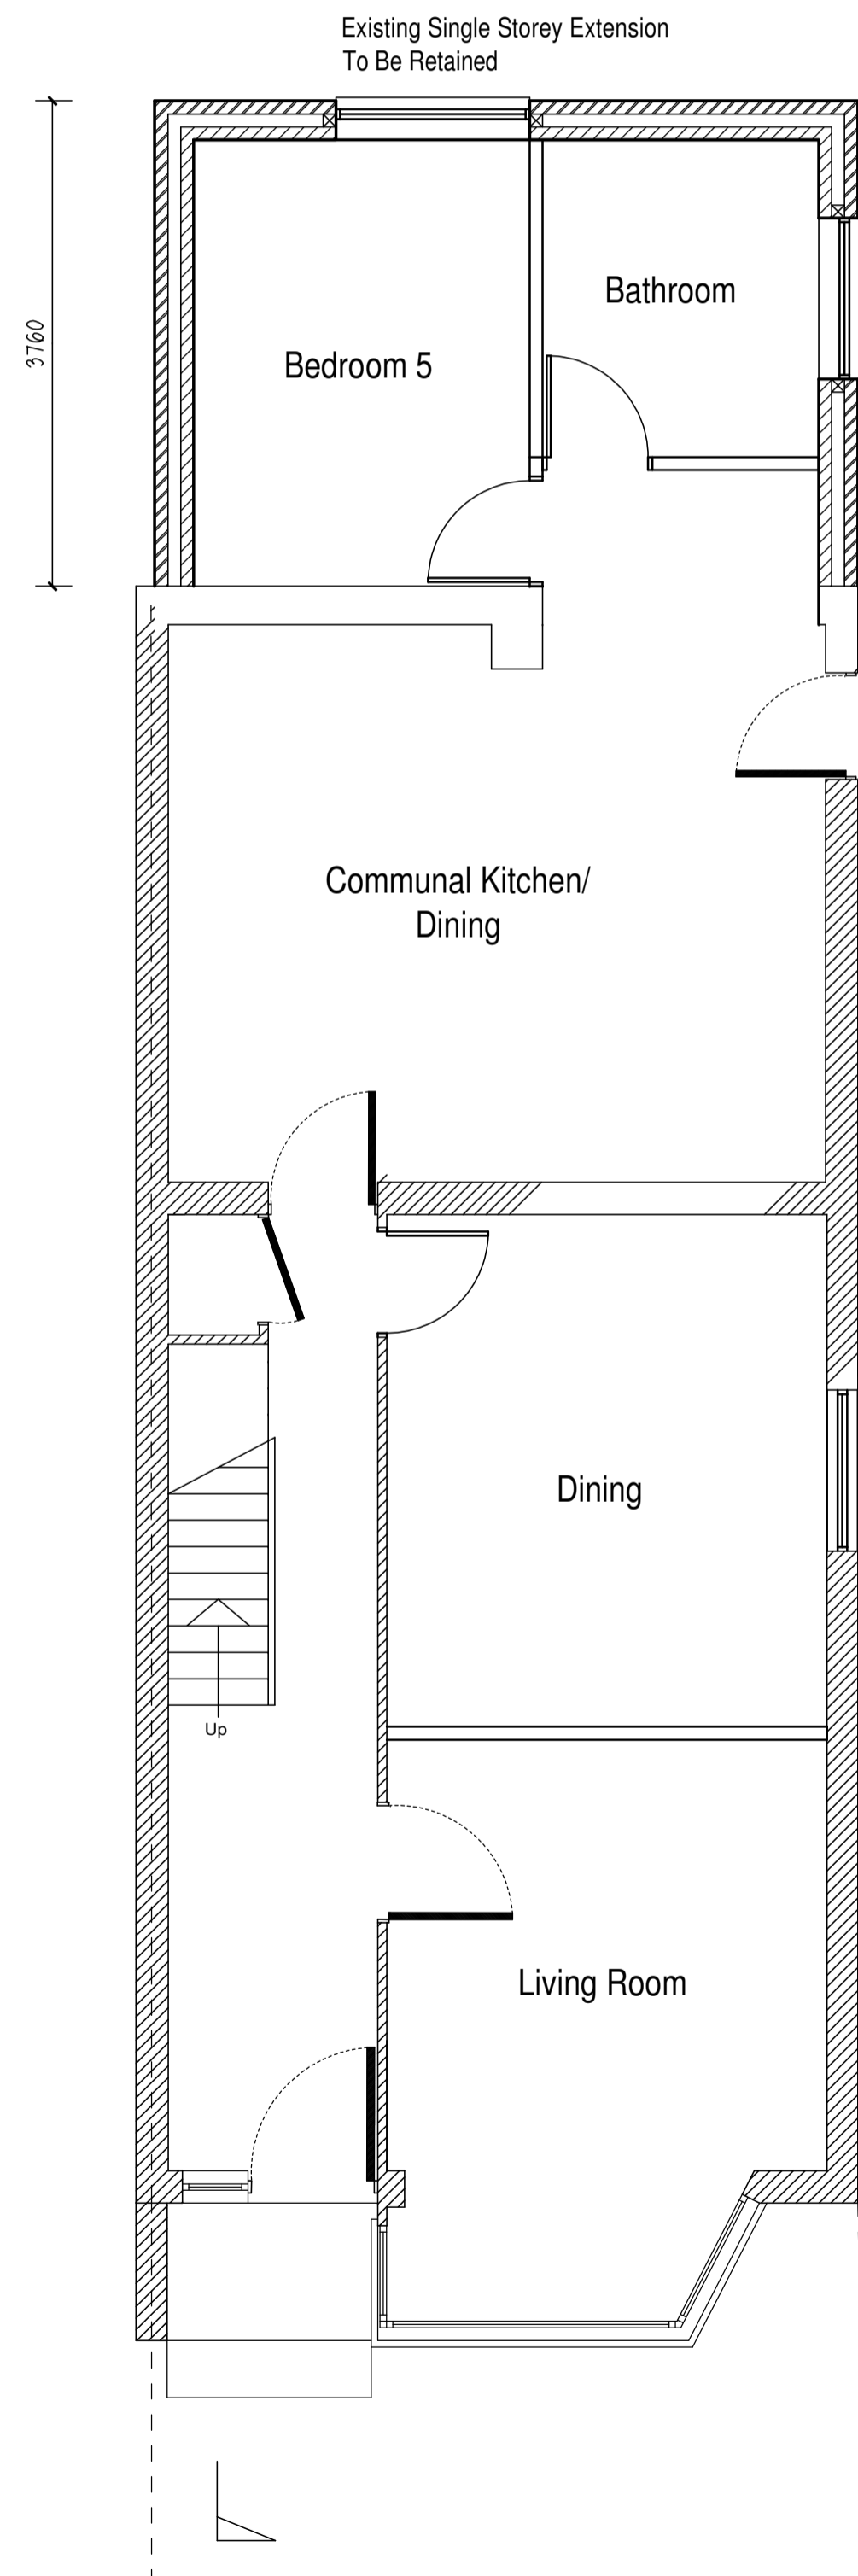


Existing Ground Floor

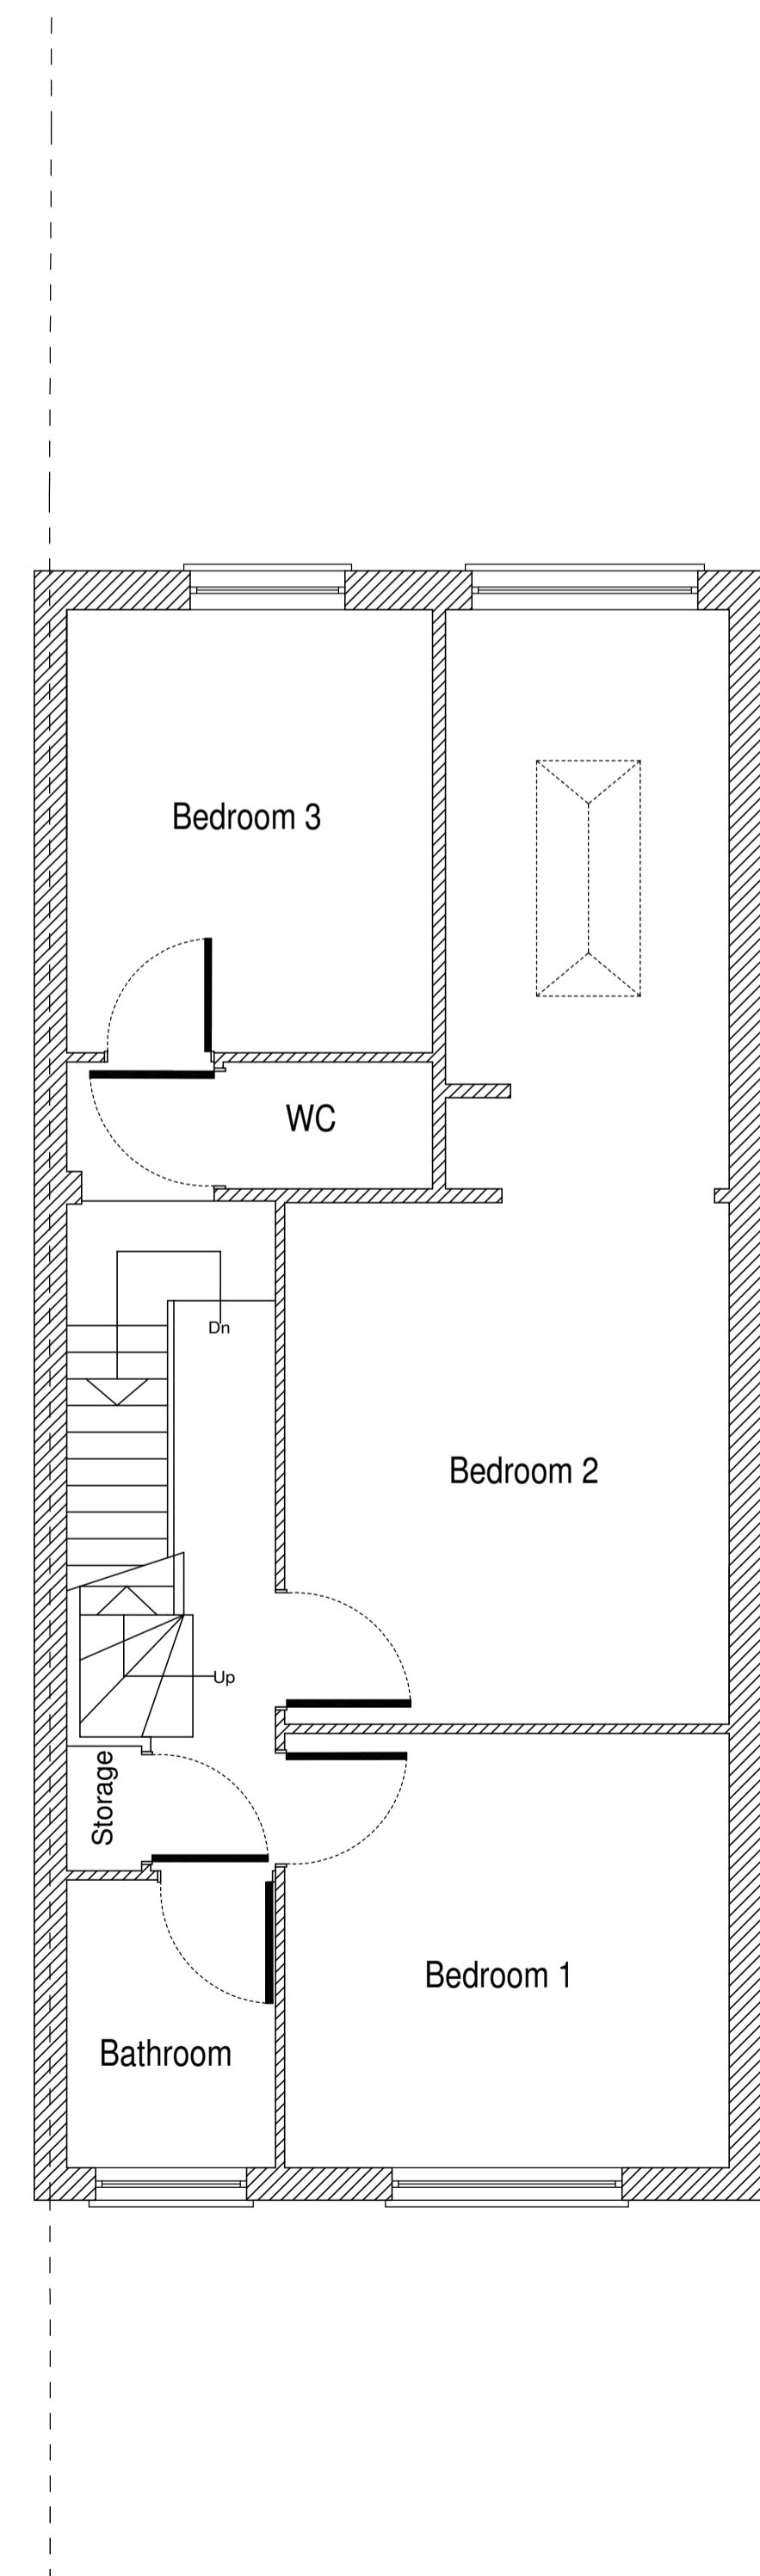


Existing First Floor

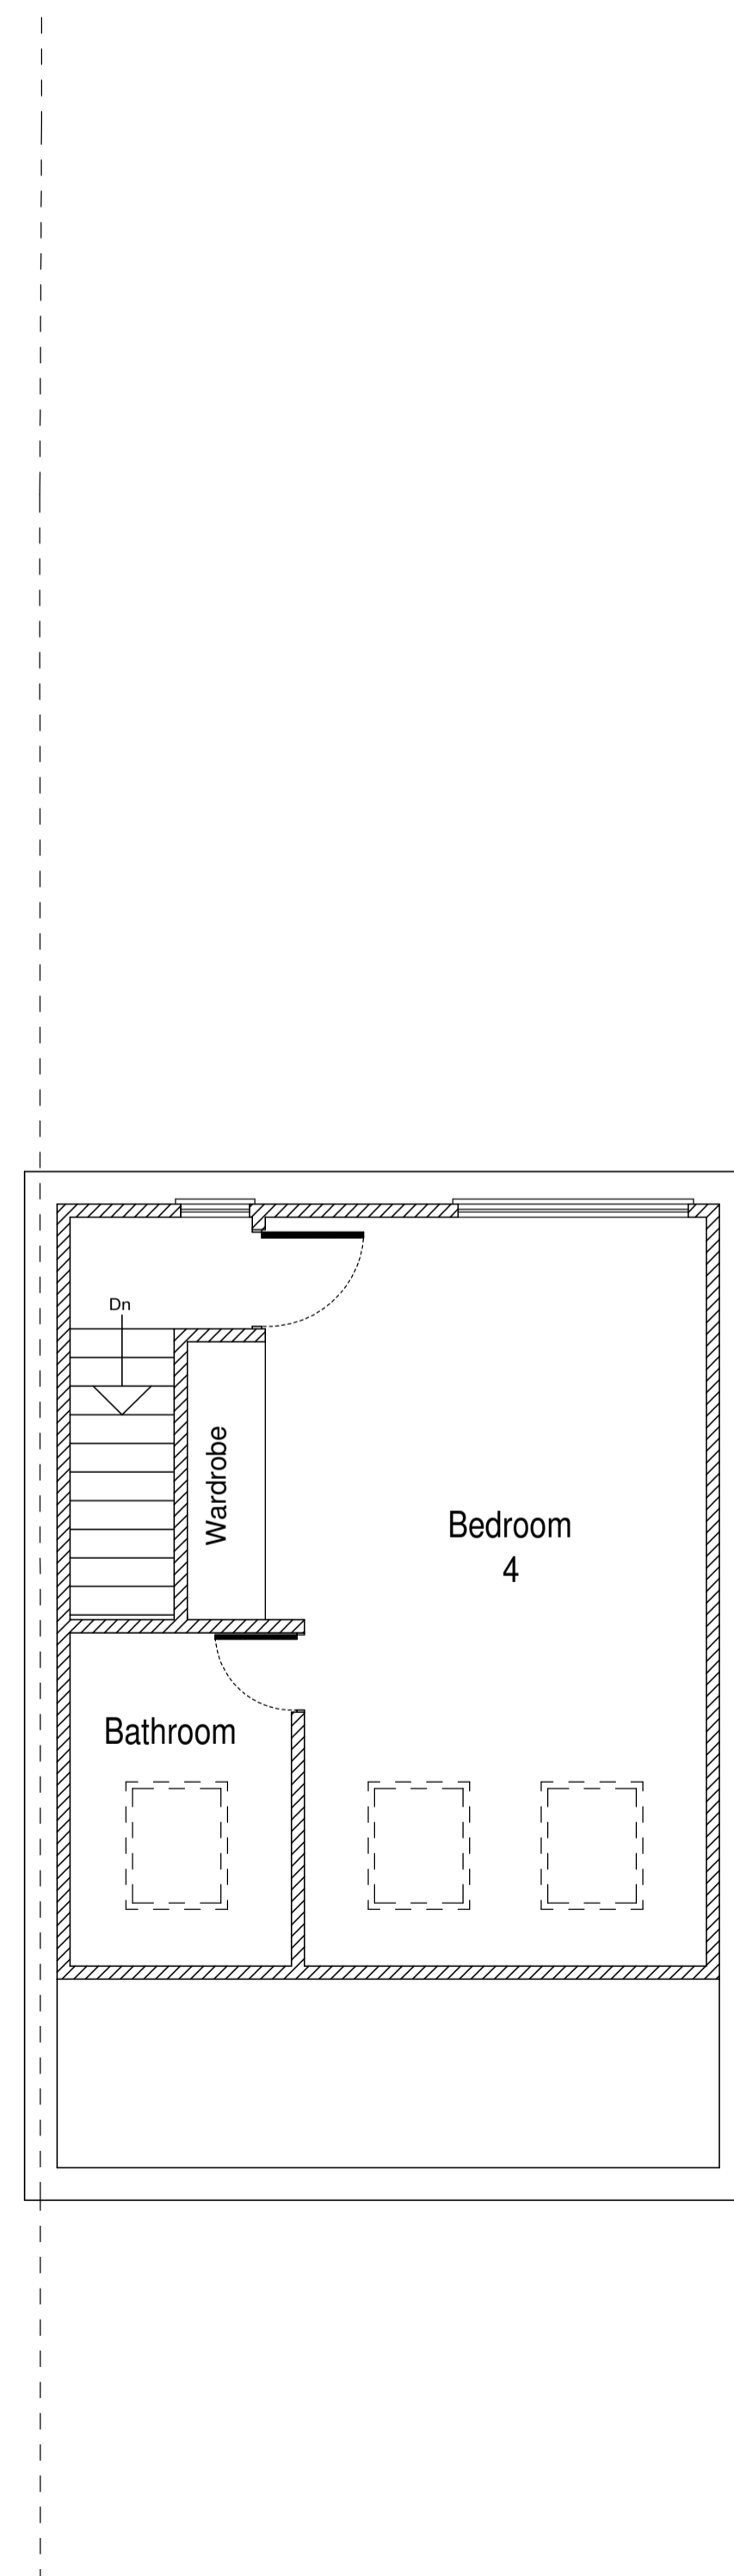

Existing Loft Floor

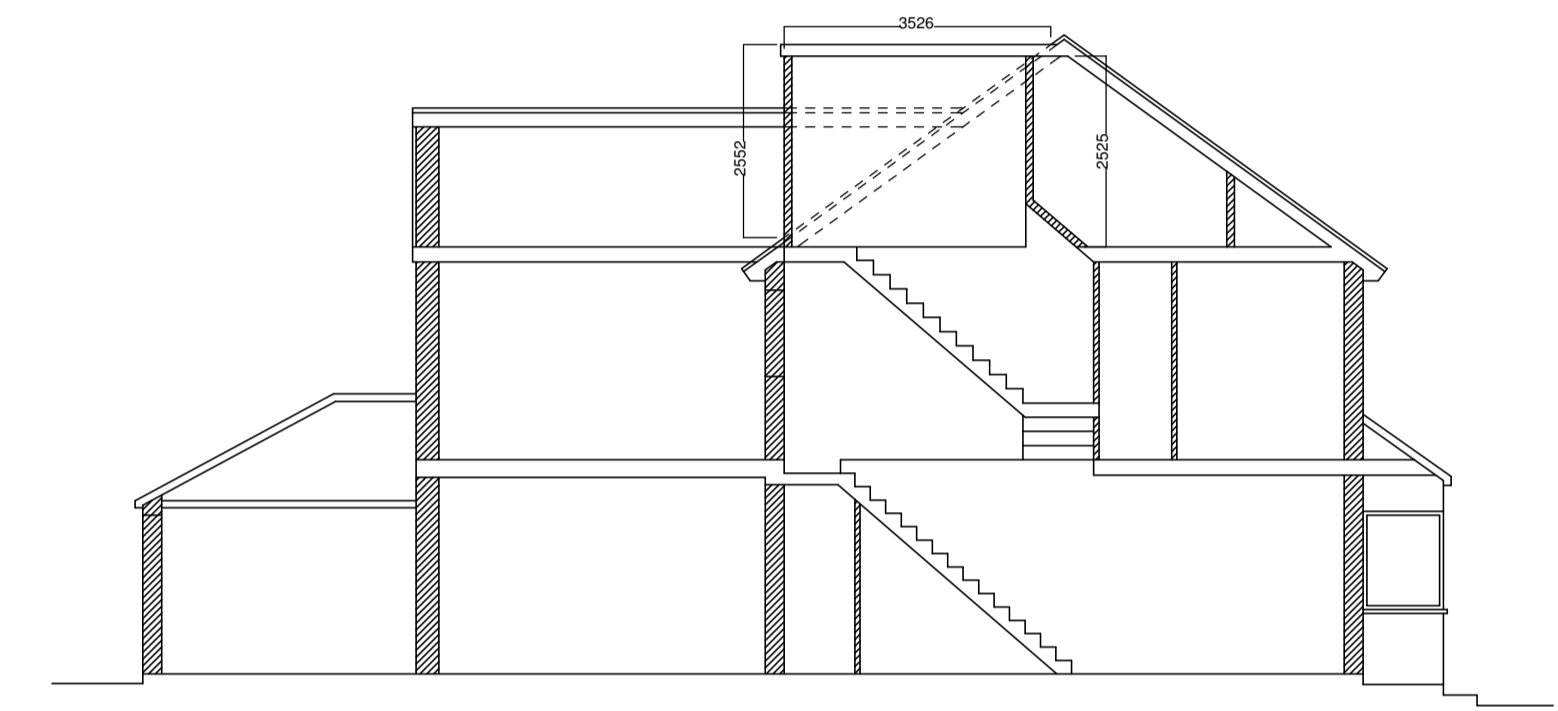

Existing Section

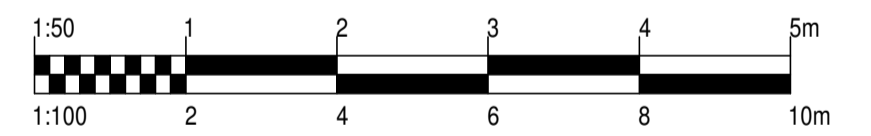

| REV. | DATE | DESCRIPTION | BY |
|------|------|-------------|----|
|      |      |             |    |

**GD Designs**  
Architectural Services

49, The Crescent,  
Cradley Heath,  
West Midlands.  
B64 7JS  
Tel 0121 602 6233  
Mob 07939 436557

contract  
EXTENSION & ALTERATIONS  
31 IZANE ROAD  
BEXLEYHEATH, KENT. DA6 8NU

drawing  
AS BUILT PLANS & ELEVATIONS

client  
MR & MRS KAJNOZI

scale 1:50/1:100@A1 date JULY 2021 drawn by GCD

drawing no GD2311/01 rev plot cad lines

T.A.M.F.  
P.A.R.K.S.O.  
D.A.T.F.  
B.H.O.R.N.E.L.L.