




Existing North West
Elevation 1:100

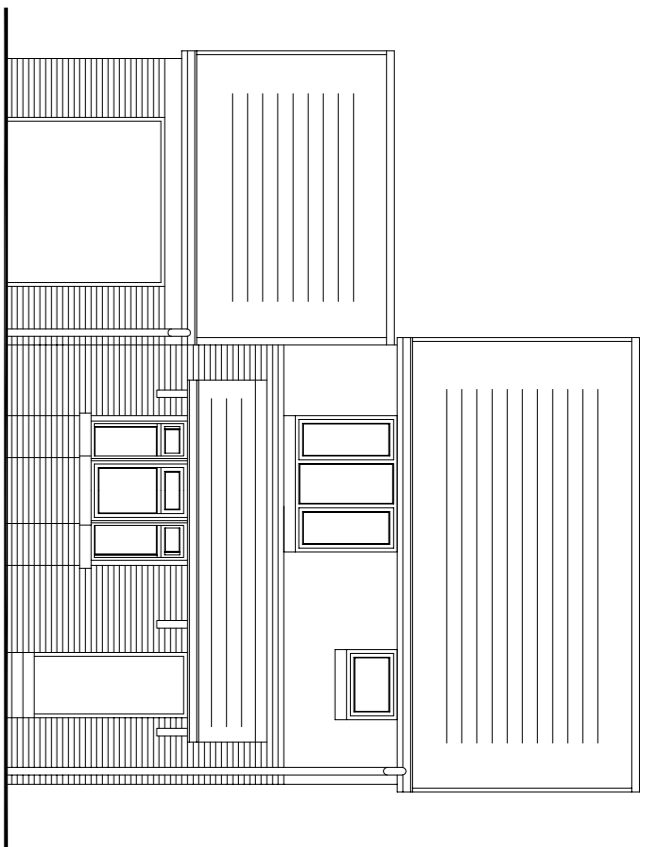


Existing South East
Elevation 1:100

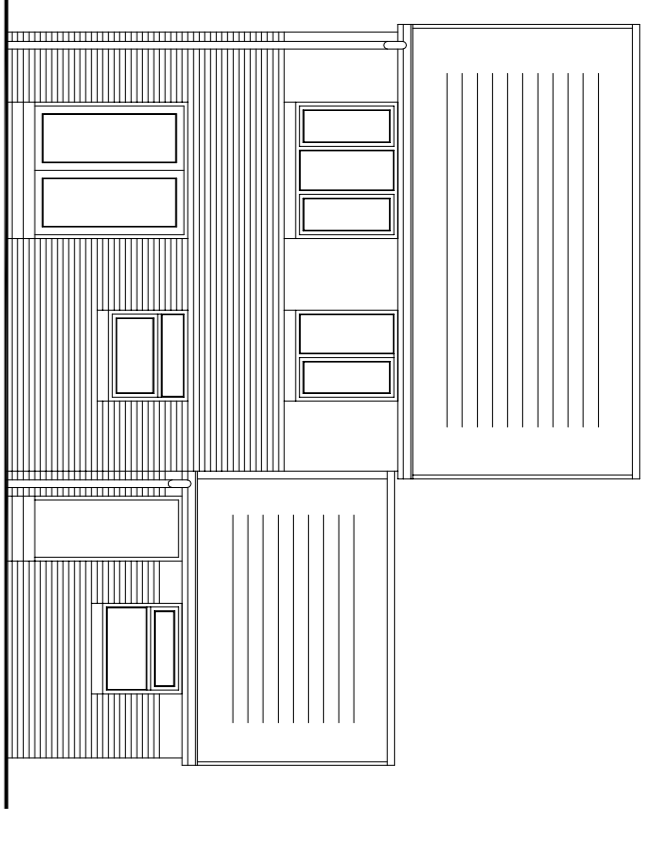


Existing South West
Elevation 1:100

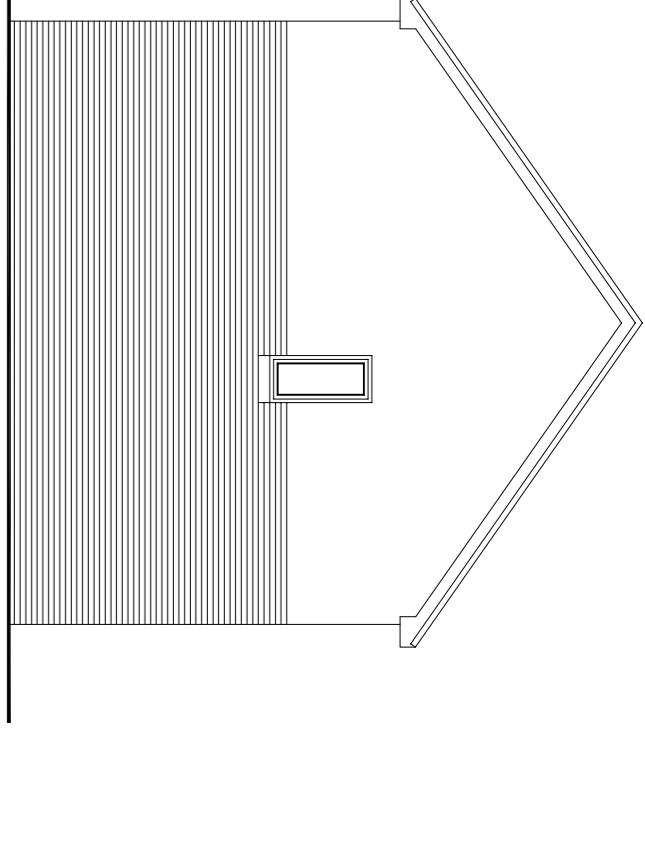


Existing Ground Floor Plan
1:100

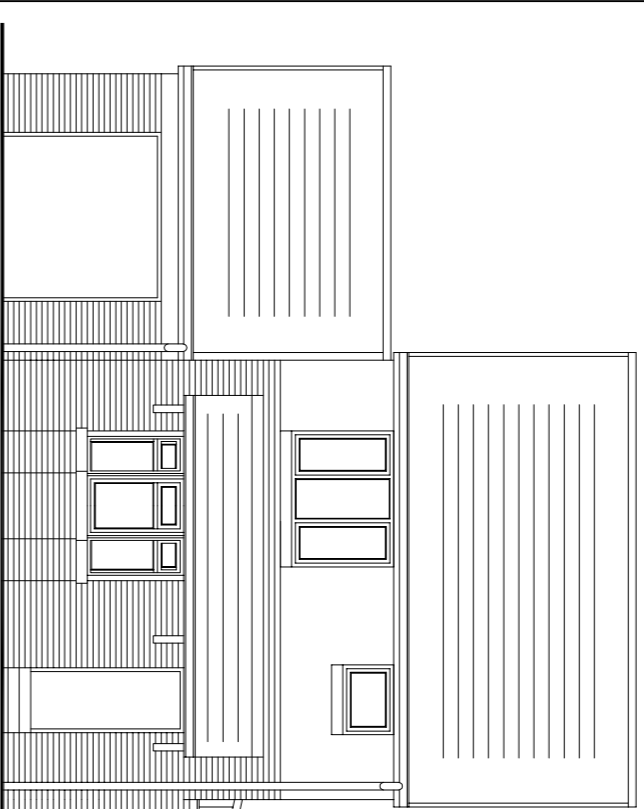


Proposed North West
Elevation 1:100

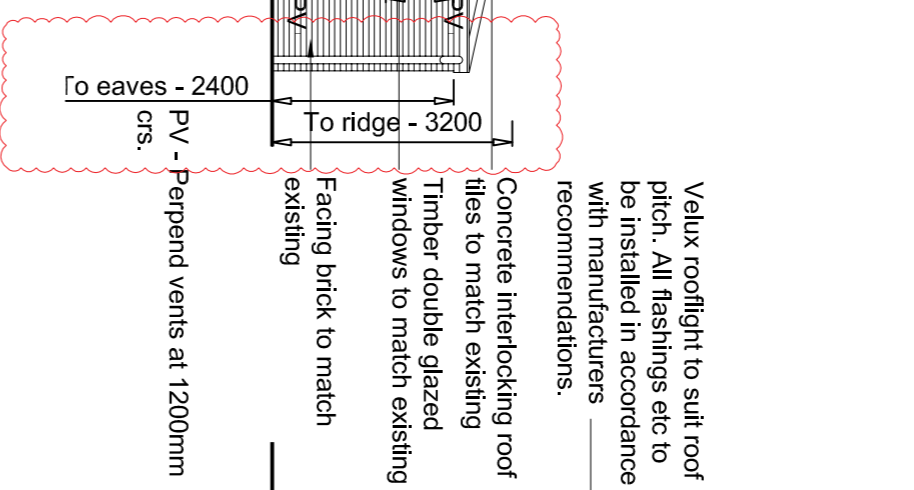

Proposed South West
Elevation 1:100

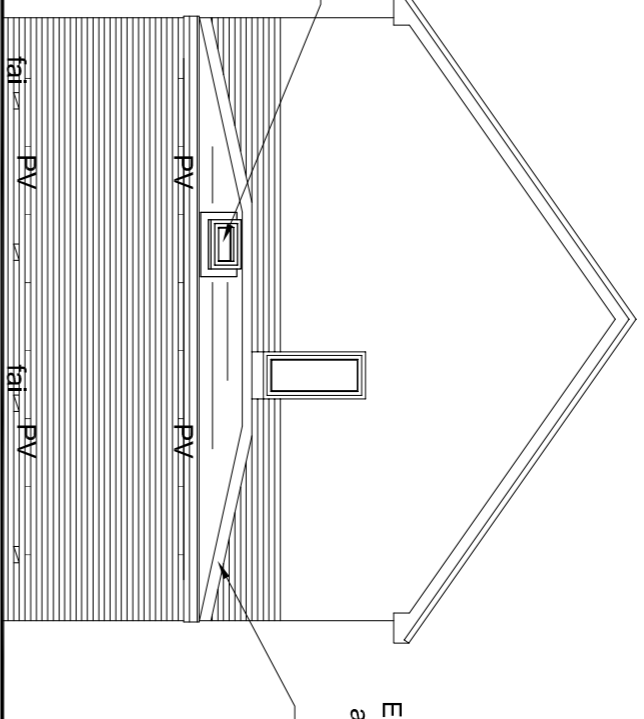


Proposed South East
Elevation 1:100

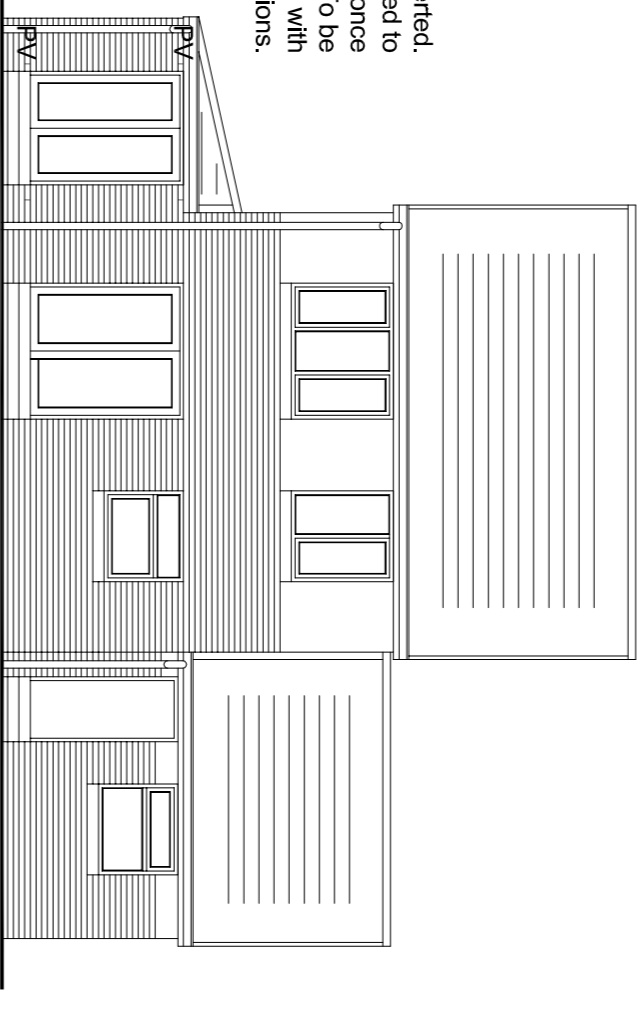

Door & Windows
Doors to be double glazed units, with U Value of 1.4 W/m²K. Windows to be double glazed, argon filled, low-E, with U Value of 1.4 W/m²K. All windows to be fitted with trickle vents in accordance with BS 6822:2005. Windows to match existing windows to match existing facings brick to match existing concrete infill/locking roof tiles to match existing recommendations. Timber double glazed windows to match existing facings brick to match existing concrete infill/locking roof tiles to match existing recommendations.

Concrete Slabs:
Rise - 300mm
Going - 150mm

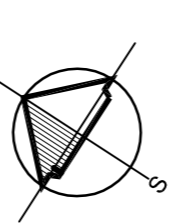

Existing brick wall to be lined with det and dab fixed 12.5mm plasterboard, all joints taped and filled for decoration.
New opening in existing wall, 2 no. Robeslee type C lintels to be inserted. Min. 150mm rest both side.
New work to be connected to existing using Carline wall connector system ensuring continuity of cavity.
New work to be connected to existing using Carline wall connector system ensuring continuity of cavity.

Existing brick wall to be lined with det and dab fixed 12.5mm plasterboard, all joints taped and filled for decoration.
New opening in existing wall, 2 no. Robeslee type C lintels to be inserted. Min. 150mm rest both side.
New work to be connected to existing using Carline wall connector system ensuring continuity of cavity.
New work to be connected to existing using Carline wall connector system ensuring continuity of cavity.

Electrical Fixtures
Outlets and controls of electrical fixtures and systems should be positioned at least 350 mm from any internal corner, projecting wall or similar obstruction and, unless the need for a higher location can be demonstrated, not more than 1.2 m above floor level. This would include fixtures such as sockets, switches, fire alarm call points and timer controls or programmes. This height range:
Smoke alarms to be interconnected and permanently wired to an independent circuit. All smoke detectors should be installed in a minimum of two bedrooms. Installation shall be in accordance with BS 5839:Part 6:2019 and installed in accordance with the guidance in clause 2.11.2.

1. light switches should be positioned at a height of between 900 mm and 1.1 m above floor level.
2. standard switched or unswitched socket outlets and outlets for other services such as power sockets should be positioned at least 400mm above floor level. Above an obstruction such as a worktop, fixtures should be at least 150 mm above the projecting surface.

ACCESS CONTROLS -
Windows
An operable window or rooflight, that provides natural ventilation, should have controls for opening, positioned at least 350 mm from any internal corner, projecting wall or similar obstruction and at a height not more than 1.7 m above floor level, where access to controls is unobstructed.

ELECTRICAL LEGEND
⊕ Ceiling mounted Pendant Light
⏻ Light Switch
Ⓢ Double Socket
Ⓢ Smoke Detector
Ⓢ Mechanical Extract Fan

DAMP PROOFING - D.p.c.'s around all external openings and 150mm above ground level linked to d.p.m.
WINDOWS / DOORS - Windows to match existing and to be double glazed, argon filled, low-E, with U-value of 1.4 W/m²K. Windows to be fitted with trickle vents - 12000mm².
Opening areas 1/30th floor area.
Glazed areas 1/15th floor area.
Doors + windows shall comply with BS 8213:Part 1:1991.
All glazing must comply with BS 6822:2005
Rooflights to be fitted with trickle vents in accordance with BS 6822:2005.
Rooflights to be fitted with trickle vents in accordance with BS 6822:2005.
Rooflights to be fitted with trickle vents in accordance with BS 6822:2005.
Rooflights to be fitted with trickle vents in accordance with BS 6822:2005.

Roof Abutment Detail 1:10
Existing wall construction
Cavity Tray to be inserted. Existing brick to be removed to allow fixing and replaced once cavity in position. To be installed in accordance with manufacturers instructions.
Roof trusses to be fixed to timber kit with galvanised holding down straps / truss clips every 2nd truss.
Final truss design to be by truss manufacturer including all bracing etc.
Timber roof trusses at 600mm o/s.
Timbers around velux opening.
Double trusses to velux opening.
Roof to be insulated with 100mm Kingspan Kooltherm K7 Pitched Roof Board over trusses / 100mm Kingspan Kooltherm K7 Pitched Roof Board between trusses
Eaves detail to match existing
Wall cavities to be vented to provide equivalent of opening brick equivalent every 1200mm above and below horizontal freestops.
DPC to be min. 150 above GL
Lean mix concrete infill cavity to GL
Contractor to ensure existing and proposed floor levels match

Cross Section 1:50
170mm Kingspan Kooltherm K103 Insulation
12.5% fall
Roof vent
For roof abutment detail see adjacent
Contractor to ensure existing and proposed floor levels match

Proposed Underbuilding Plan 1:50
215 x 75 fall
Span of ex 150 x 50 timber treated joists @ 400 C/S
SVP connected to existing storm drainage
Contractor to survey existing drainage to establish exact positions.
No existing sub-floor vents to be affected.

Proposed Roof Plan 1:50
Timber roof trusses at 600mm o/s.
Timbers around velux opening.
Double trusses to velux opening.

GENERAL SPECIFICATION
FOUND etc. Clear carriage of area of extension of all organic material. Ensure foundations are taken down to a suitable formation level and at least as deep as existing foundations. Ensure that existing foundations are protected during the works. Foundations shall be to Engineers standards.
Light switches adjacent to all doors.
Light fittings and lamps installed in the dwelling should be low energy type e.g. tubular fluorescent and compact fluorescent fittings (CFLs) with luminous efficacy at least 40 lumens / circuit watt.
VENTILATION -
Mechanical extract fan to be provided to Shower Room and be vented to outside and to give an extraction rate of 15 l/s.
PLUMBING/DRAINAGE - Drainage to BS EN752-1:1996, BS EN752-2:1997, BS EN752-3:1997, BS EN752-4:1998, Sanitary pipework to BS EN12056-2:2000. All to the satisfaction of Building Control. Meeting to be held on site prior to start of work commencing.
Plumbing and SVPs to be installed in accordance with BS 6841:2009 and BS 6842:2009.
110mm connections to w.c. 42mm dia. pvc to sinks and 32mm dia. pvc to w.h.b's.
All connections to be made separately to outlet and all fittings fitted with deep seal traps.
Drainage to s.v.p.s to be 50x50mm softwood framing with 12.5mm plasterboard. Pipework wrapped in acoustic insulation. Hot and cold pipework insulated.
Gutters to match and be connected to existing.
Central Heating to CORGI Regs. designed in accordance with CIBSE Guide.
Radiators fitted with thermostatic control valves.
Sanitaryware connections shall be to the satisfaction of the Design Authority.
Local Authority.
Underground drainage shall be to BS 5422:2001.
Pipework and 150mm para gravel surrounds.
GENERAL NOTES - All building works to be carried out within the curtilage and in accordance with Building Standards Scotland 2007 final, all relevant amendments. Structural timbers shall be treated in accordance with BS 5268 and on site cut ends shall be twice treated with a coloured preservative.
Scalloping + blemishes etc. shall comply with BS 5993.
The contractor shall:
-be responsible for verifying all sizes, dimensions and angles prior to purchasing & ordering materials or building elements.
-ensure work is carried out in accordance with the drawings approved by the local authority.
-submit notice of commencement of operations to Local Authority.
-contract structural engineer (if applicable) and Building Control to inspect foundation trenches
-ensure existing and proposed floor levels line through relevant stages
-do not scale drawings: 'If in doubt, ask!

Notes
Building to be constructed to limit thermal bridges and gaps in building envelope within the building at junction between various building elements and at edges of building elements (e.g. around window openings). Building should be constructed in accordance with BRE Report BR262. Thermal insulation. Avoiding risks'. 2nd Edition, 1994.
Building to be constructed to minimise air leakage paths. Contractor to ensure that all gaps between dry linings and masonry walls at window and roof space openings, and at junction between walls, floors and ceiling should be sealed. Draught seals should be fitted to operable parts of windows.

NOTE -
The contractor will be held to have examined the site and checked all dimensions, angles, drainage and levels before commencing construction work and ordering materials.
No assumption should be made without reference to shaw architecture
© Copyright. These drawings are the property of shaw architecture and should not be copied without written consent.

Client:-
Mr & Mrs Morrison,
10 Glen Rannoch Drive,
Chapelhall, ML6 8QU.

Job Description:-
Proposed Side Extension to Dwelling House
Scale:- As Shown
Date:- 09/21 Drg No:- BW01
Job No:- 139 Rev:- A

Drawing Description:-
Building Warrant Drawings

shaw architecture
1000
1500
2000
10000