



### Proposed Elevations


Scale 1:100

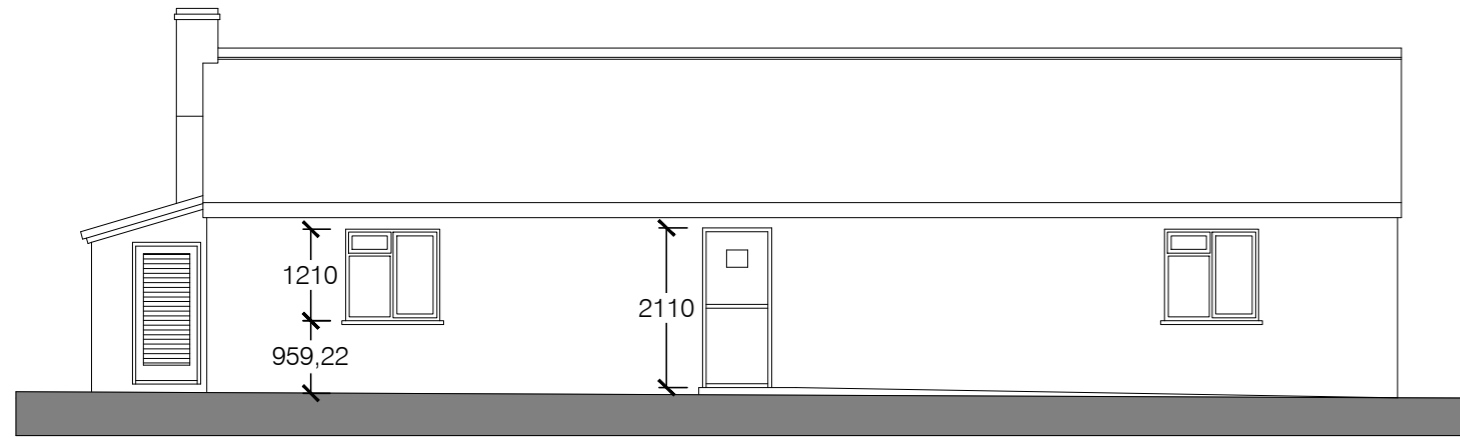


Principle Elevation  
(North)

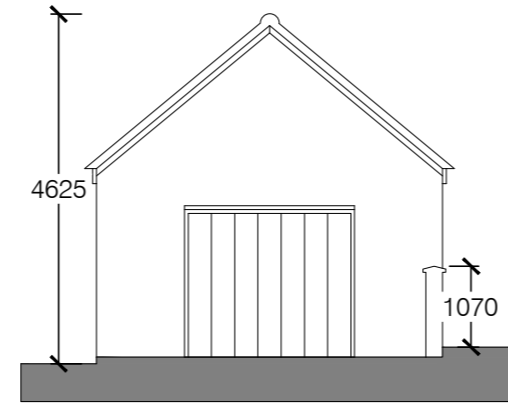


Side Elevation  
(West)

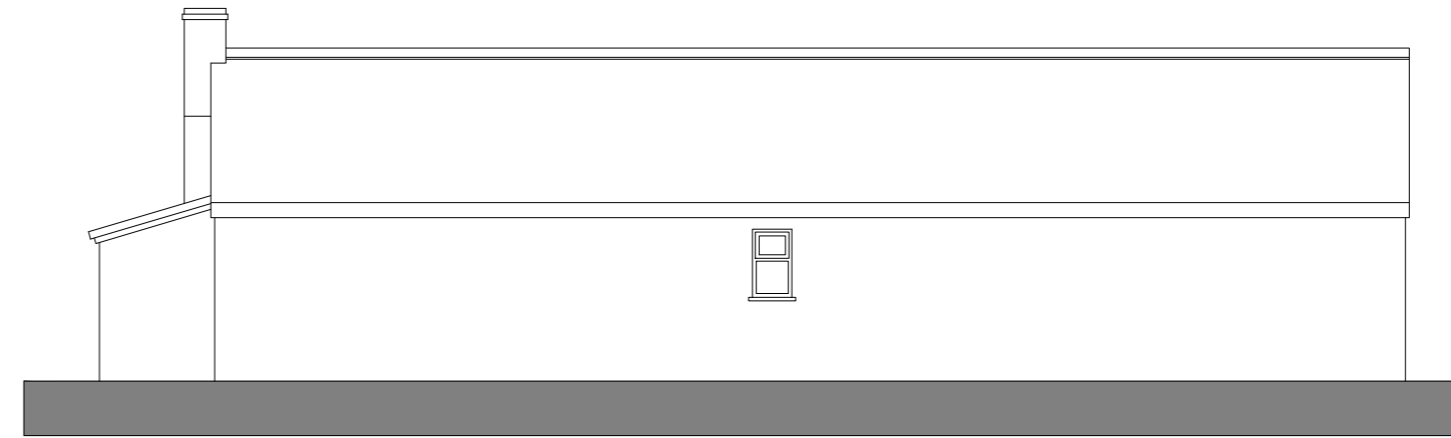

Rear Elevation  
(South)

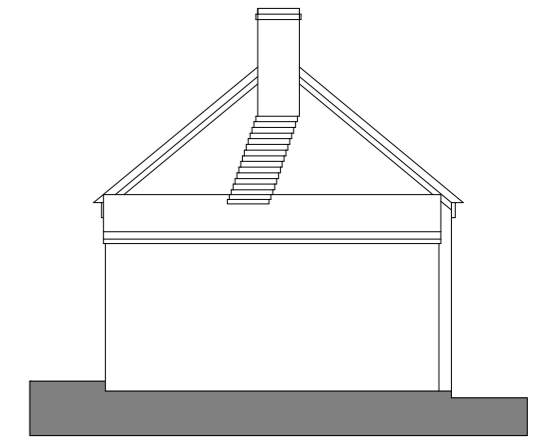

Side Elevation  
(East)

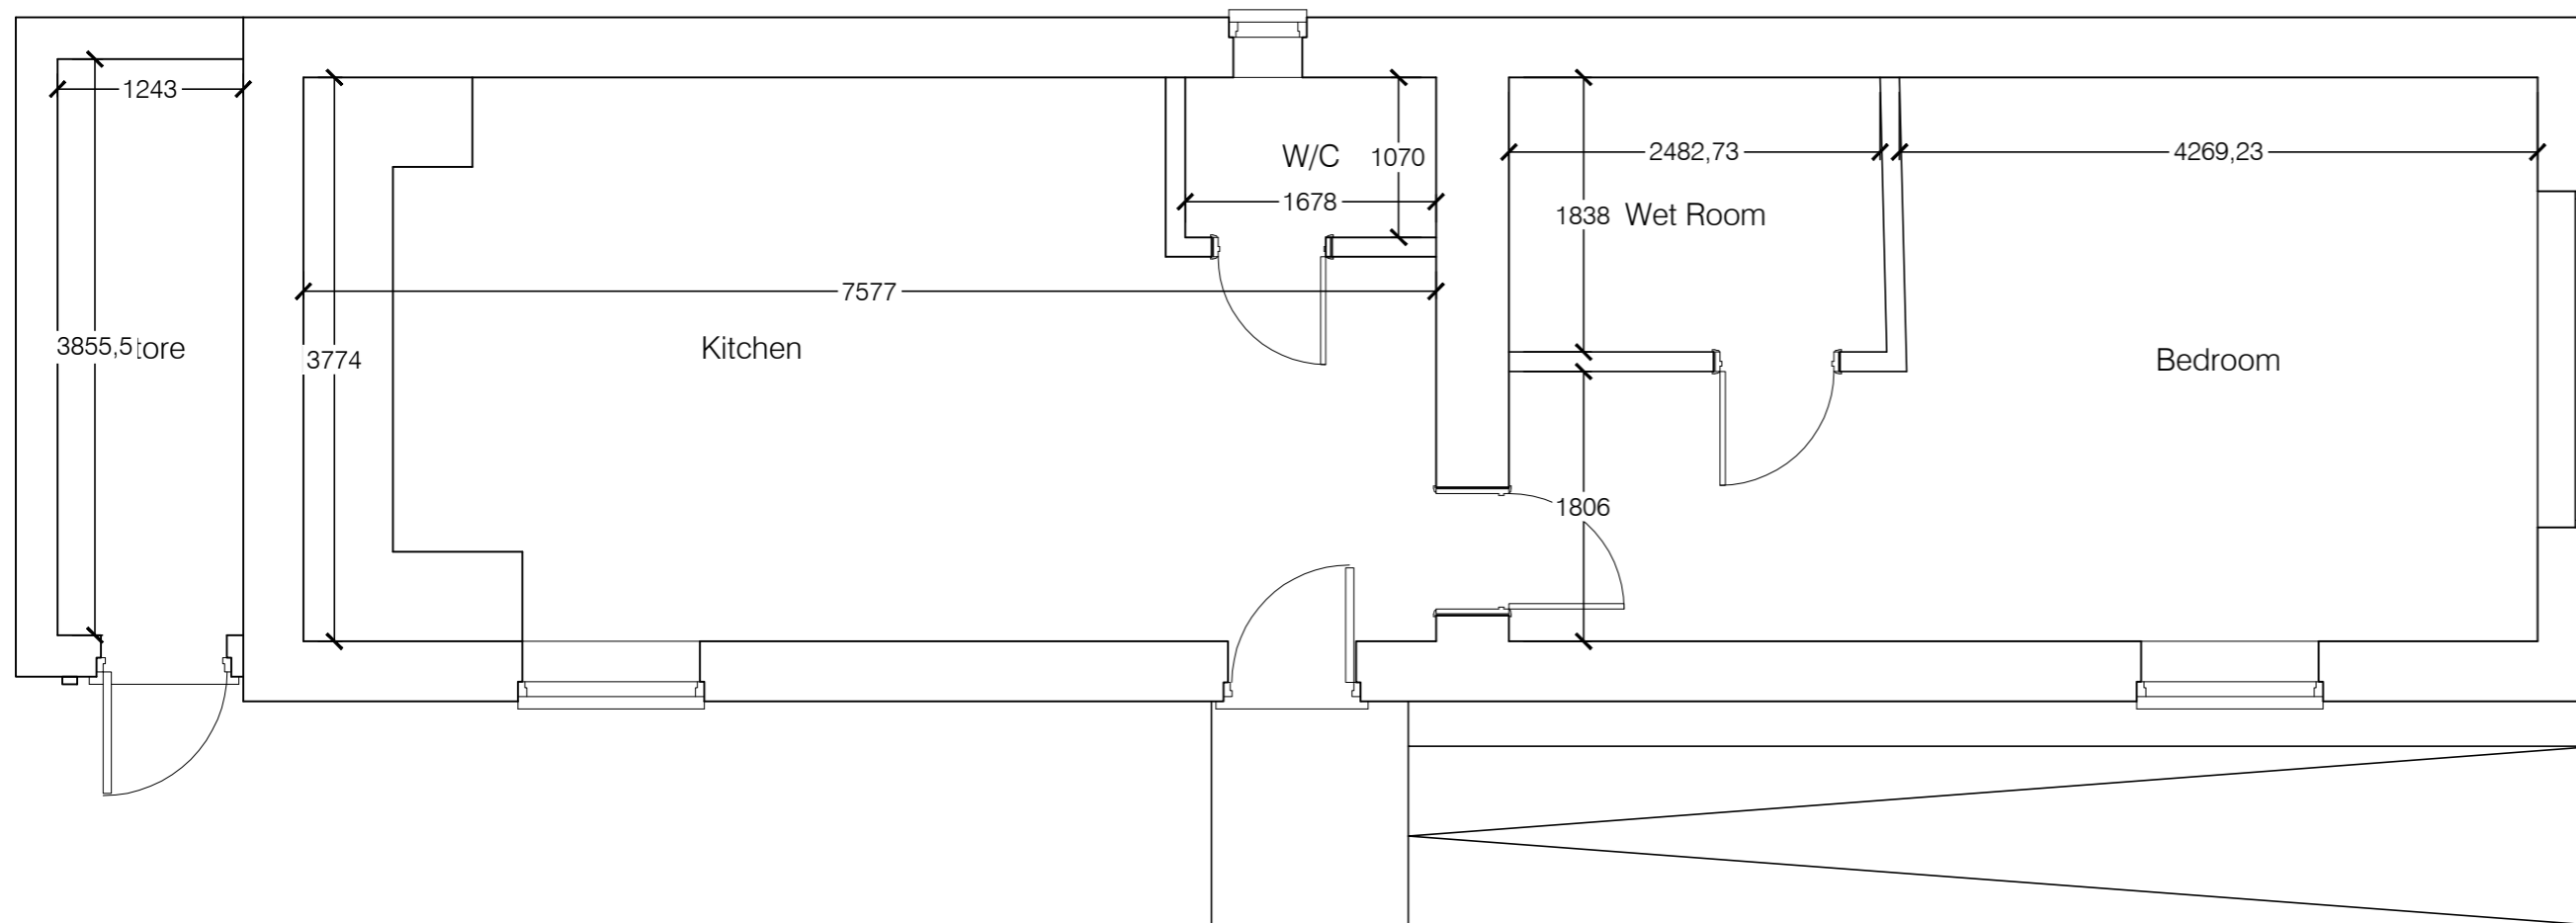


### Proposed Floor Plan

Scale 1:50



Location Plan  
Scale 1:1250

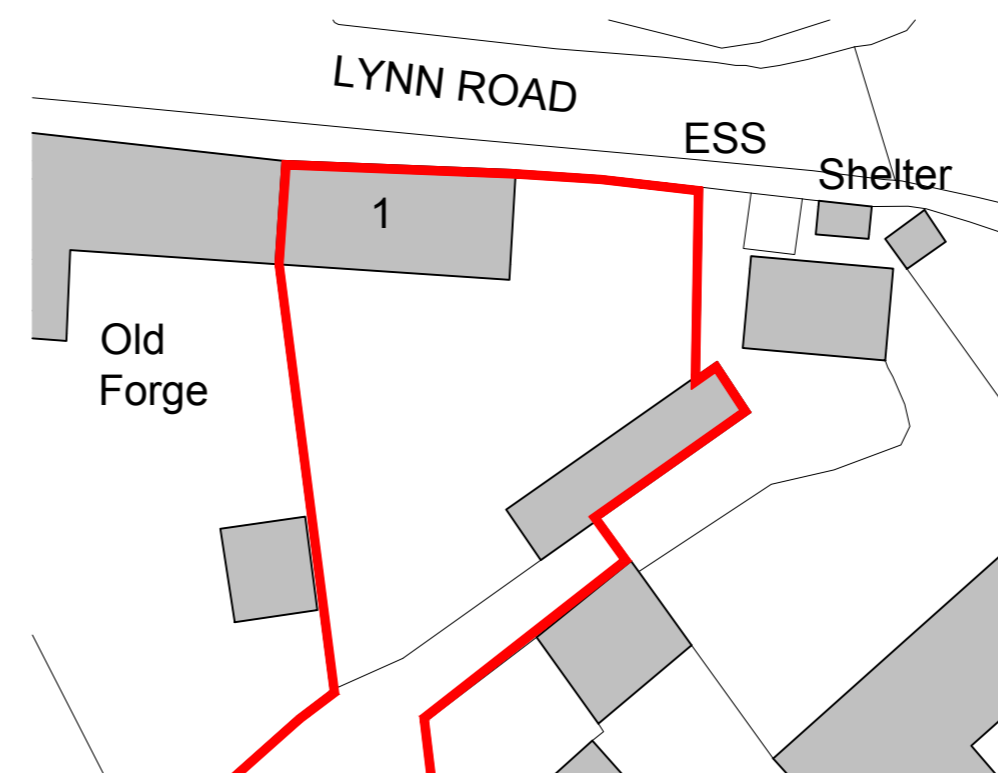

Site Plan  
Scale 1:500



Unit 12, Drove Orchards, Thornham Road,  
Holme-next-the-Sea, Norfolk. PE36 6LS  
Tel: 01328 738239 Web: www.strataarchitecture.com

Project:

1 Church Farm Barns  
Back Street, Gayton  
PE32 1QR  
Title:

Plan & Elevation as Built

Scale(s): As Shown @A2 Date: 30.09.2021

Drawn: BE Checked: JL

Drawing issued for: PLANNING

Drwg No. 557-01 Rev: -

Copyright of this drawing is retained by Strata Architecture.  
All dimensions must be checked on site by the Contractor.

