


TWYFORD





SITE LOCATION PLAN 1:1250

Scale 1:1250

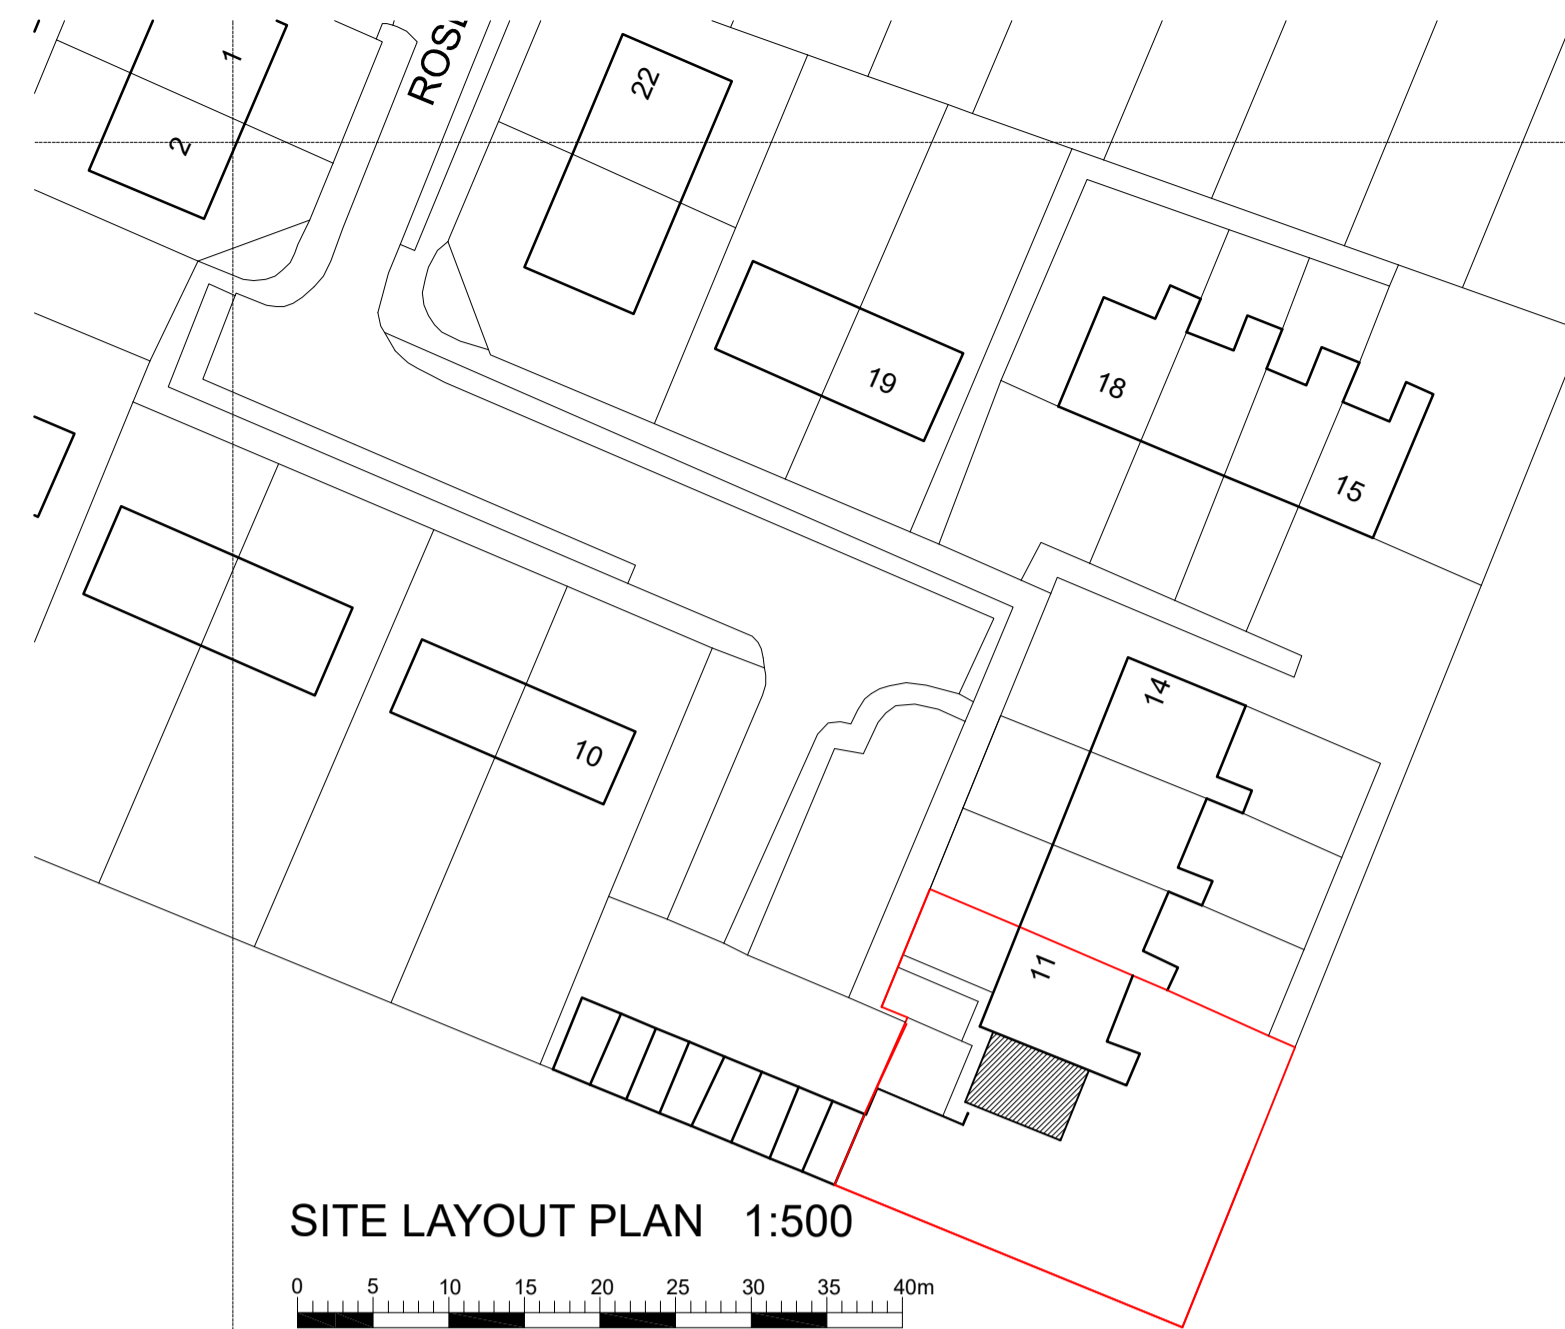

SITE LAYOUT PLAN 1:500


Scale 1:500

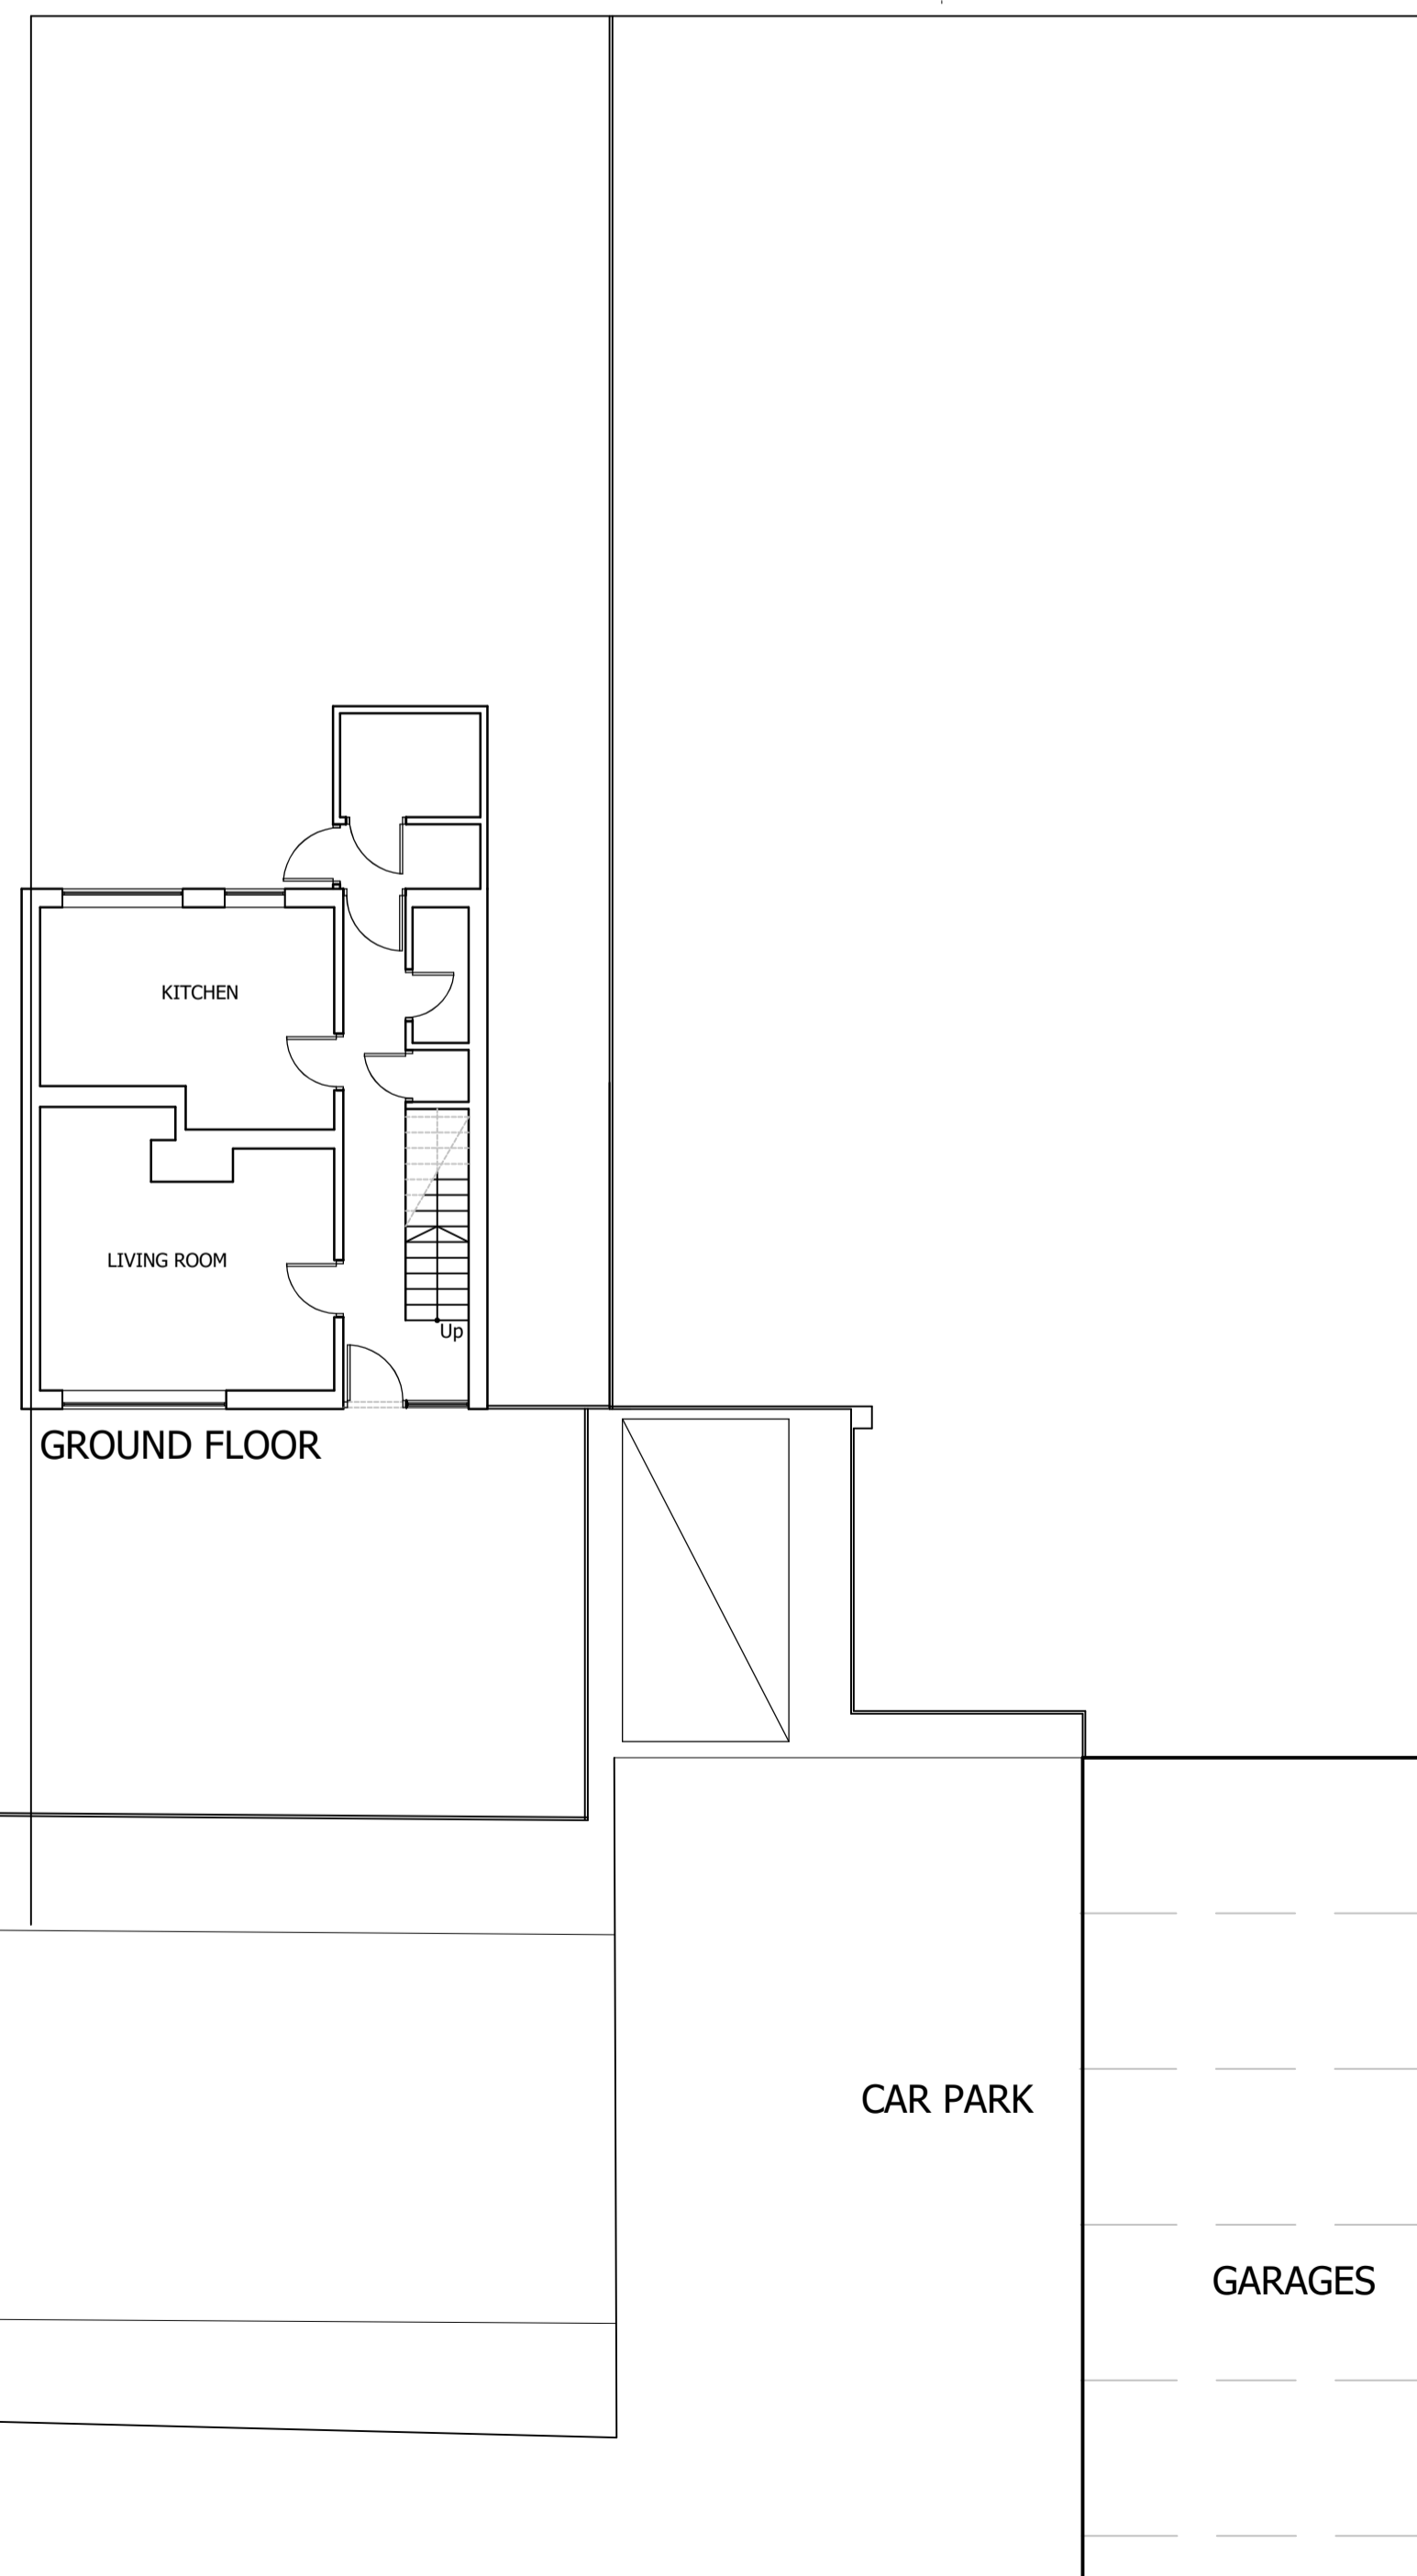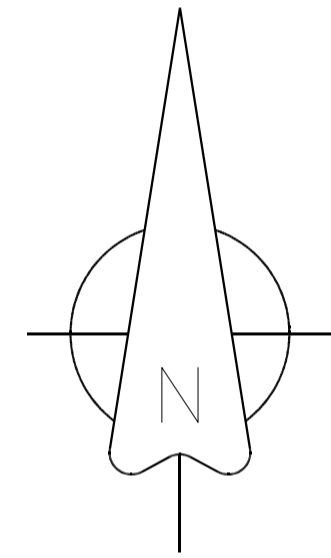

GROUND FLOOR

GROUND FLOOR PLAN 1:100

Scale 1:100

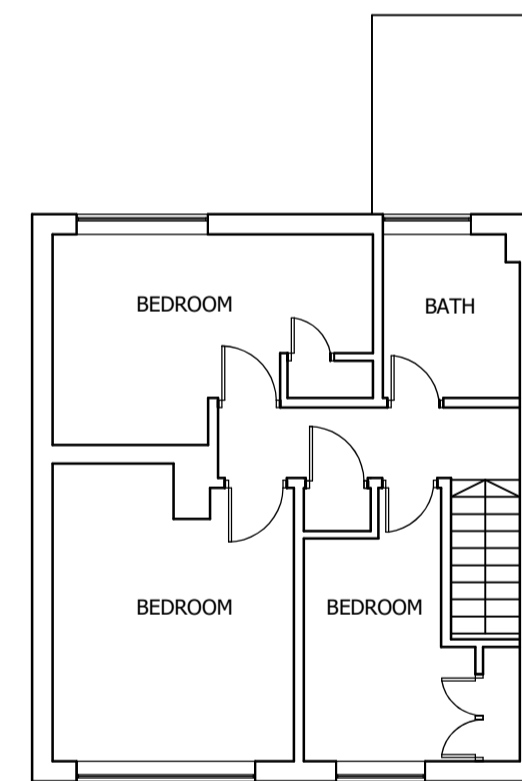


FIRST FLOOR




NORTH WEST ELEVATION 1:100

Scale 1:100

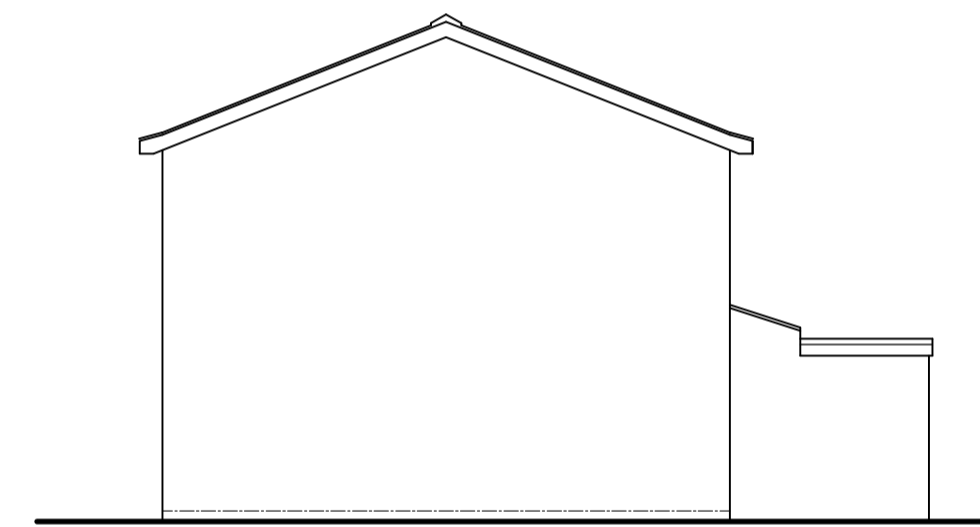

SOUTH WEST ELEVATION 1:100

Scale 1:100

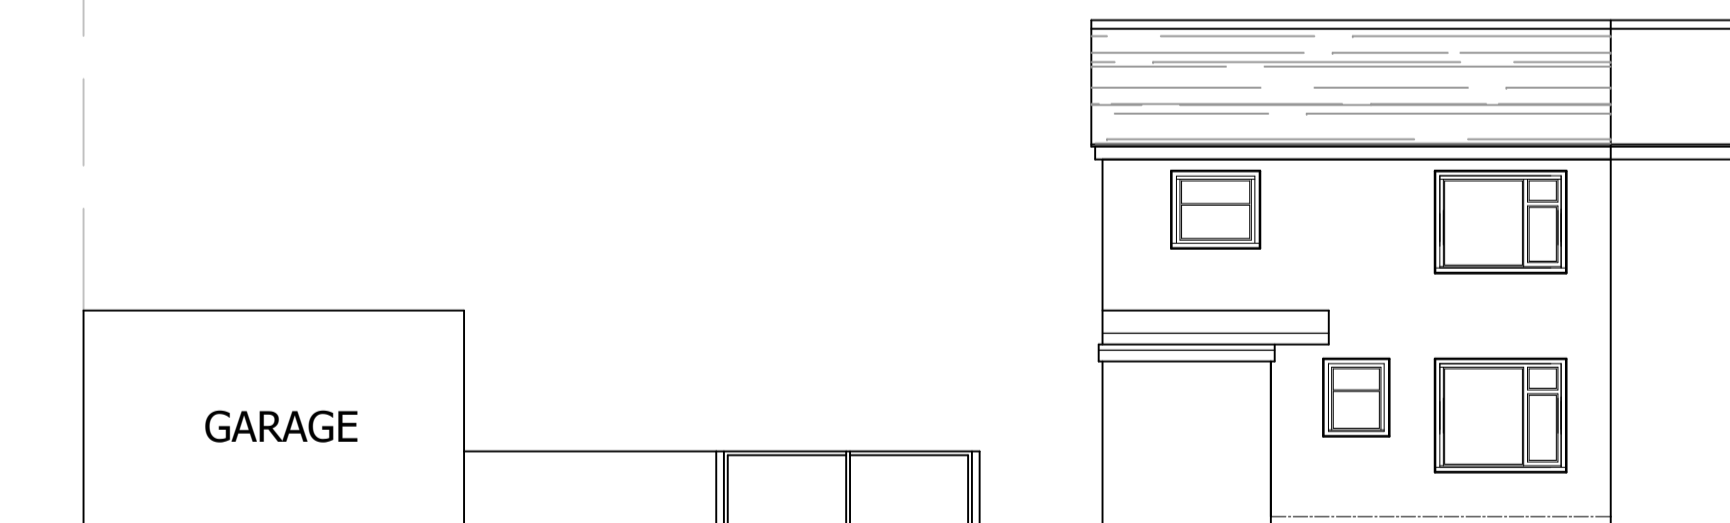

SOUTH EAST ELEVATION 1:100

Scale 1:100

NOTE:

1. This drawing is the property of Banks Design Architects and all designs hereon are covered by copyright. The drawing and information hereon may not be used for any other purposes other than for which it was originally intended.
2. All dimensions and descriptions on this drawing are to be checked. Any discrepancies are to be reported to the architect immediately.
3. NO dimensions to be scaled off this drawing.
4. ANY changes in materials must be approved by architects, building control and planning if applicable prior to order.
5. All drawings MUST be read in conjunction with structural drawings and calculations

RIBA Chartered Practice

date	description	revision

REVISIONS

**BANKS DESIGN ARCHITECTS**  
 No 2 The Granary Bignell Park Barns  
 Chesterton, Bicester, Oxon, OX26 1TD  
 Email: mail@banksdesignarchitects.co.uk  
 Tel: 01869 252308

project  
 11 ROSEHILL CRESCENT,  
 TWYFORD,  
 BUCKINGHAM  
 MK18 4EF

drawing title  
 RECORD DRAWINGS

scale 1/100, 1/1250, 1/500 date JUN 2018

drawing number 6226-01	drawing size A 1
---------------------------	---------------------