

London House 77 High Street Sevenoaks TN13 1LD t: 01732 450860

85 High Street t: 01892 335860

w: sheffords.co.uk Tunbridge Wells TN1 1XP e: office@sheffords.co.uk

SO/P/21/46 Our Ref: 4 October 2021 Date:

Mr R Devine Copperfield House Rushmore Hill Knockholt Kent **TN14 7NL**

Dear Mr Devine

RE: COPPERFIELD HOUSE, RUSHMORE HILL, KNOCKHOLT, KENT, TN14 7NL

I write to confirm that I undertook an inspection of the above property on 10 June 2021. I have inspected the property and reviewed historic mapping and google earth imagery available to me.


As far as can reasonably be determined I am of the opinion that the footprint of the property in 1948 was most likely the central section of the current building including the forward gable as denoted by the red line on the marked up floor plan.

Yours sincerely



Edward Treliving BEng MBA MRICS MFPWS Sheffords Chartered Surveyors



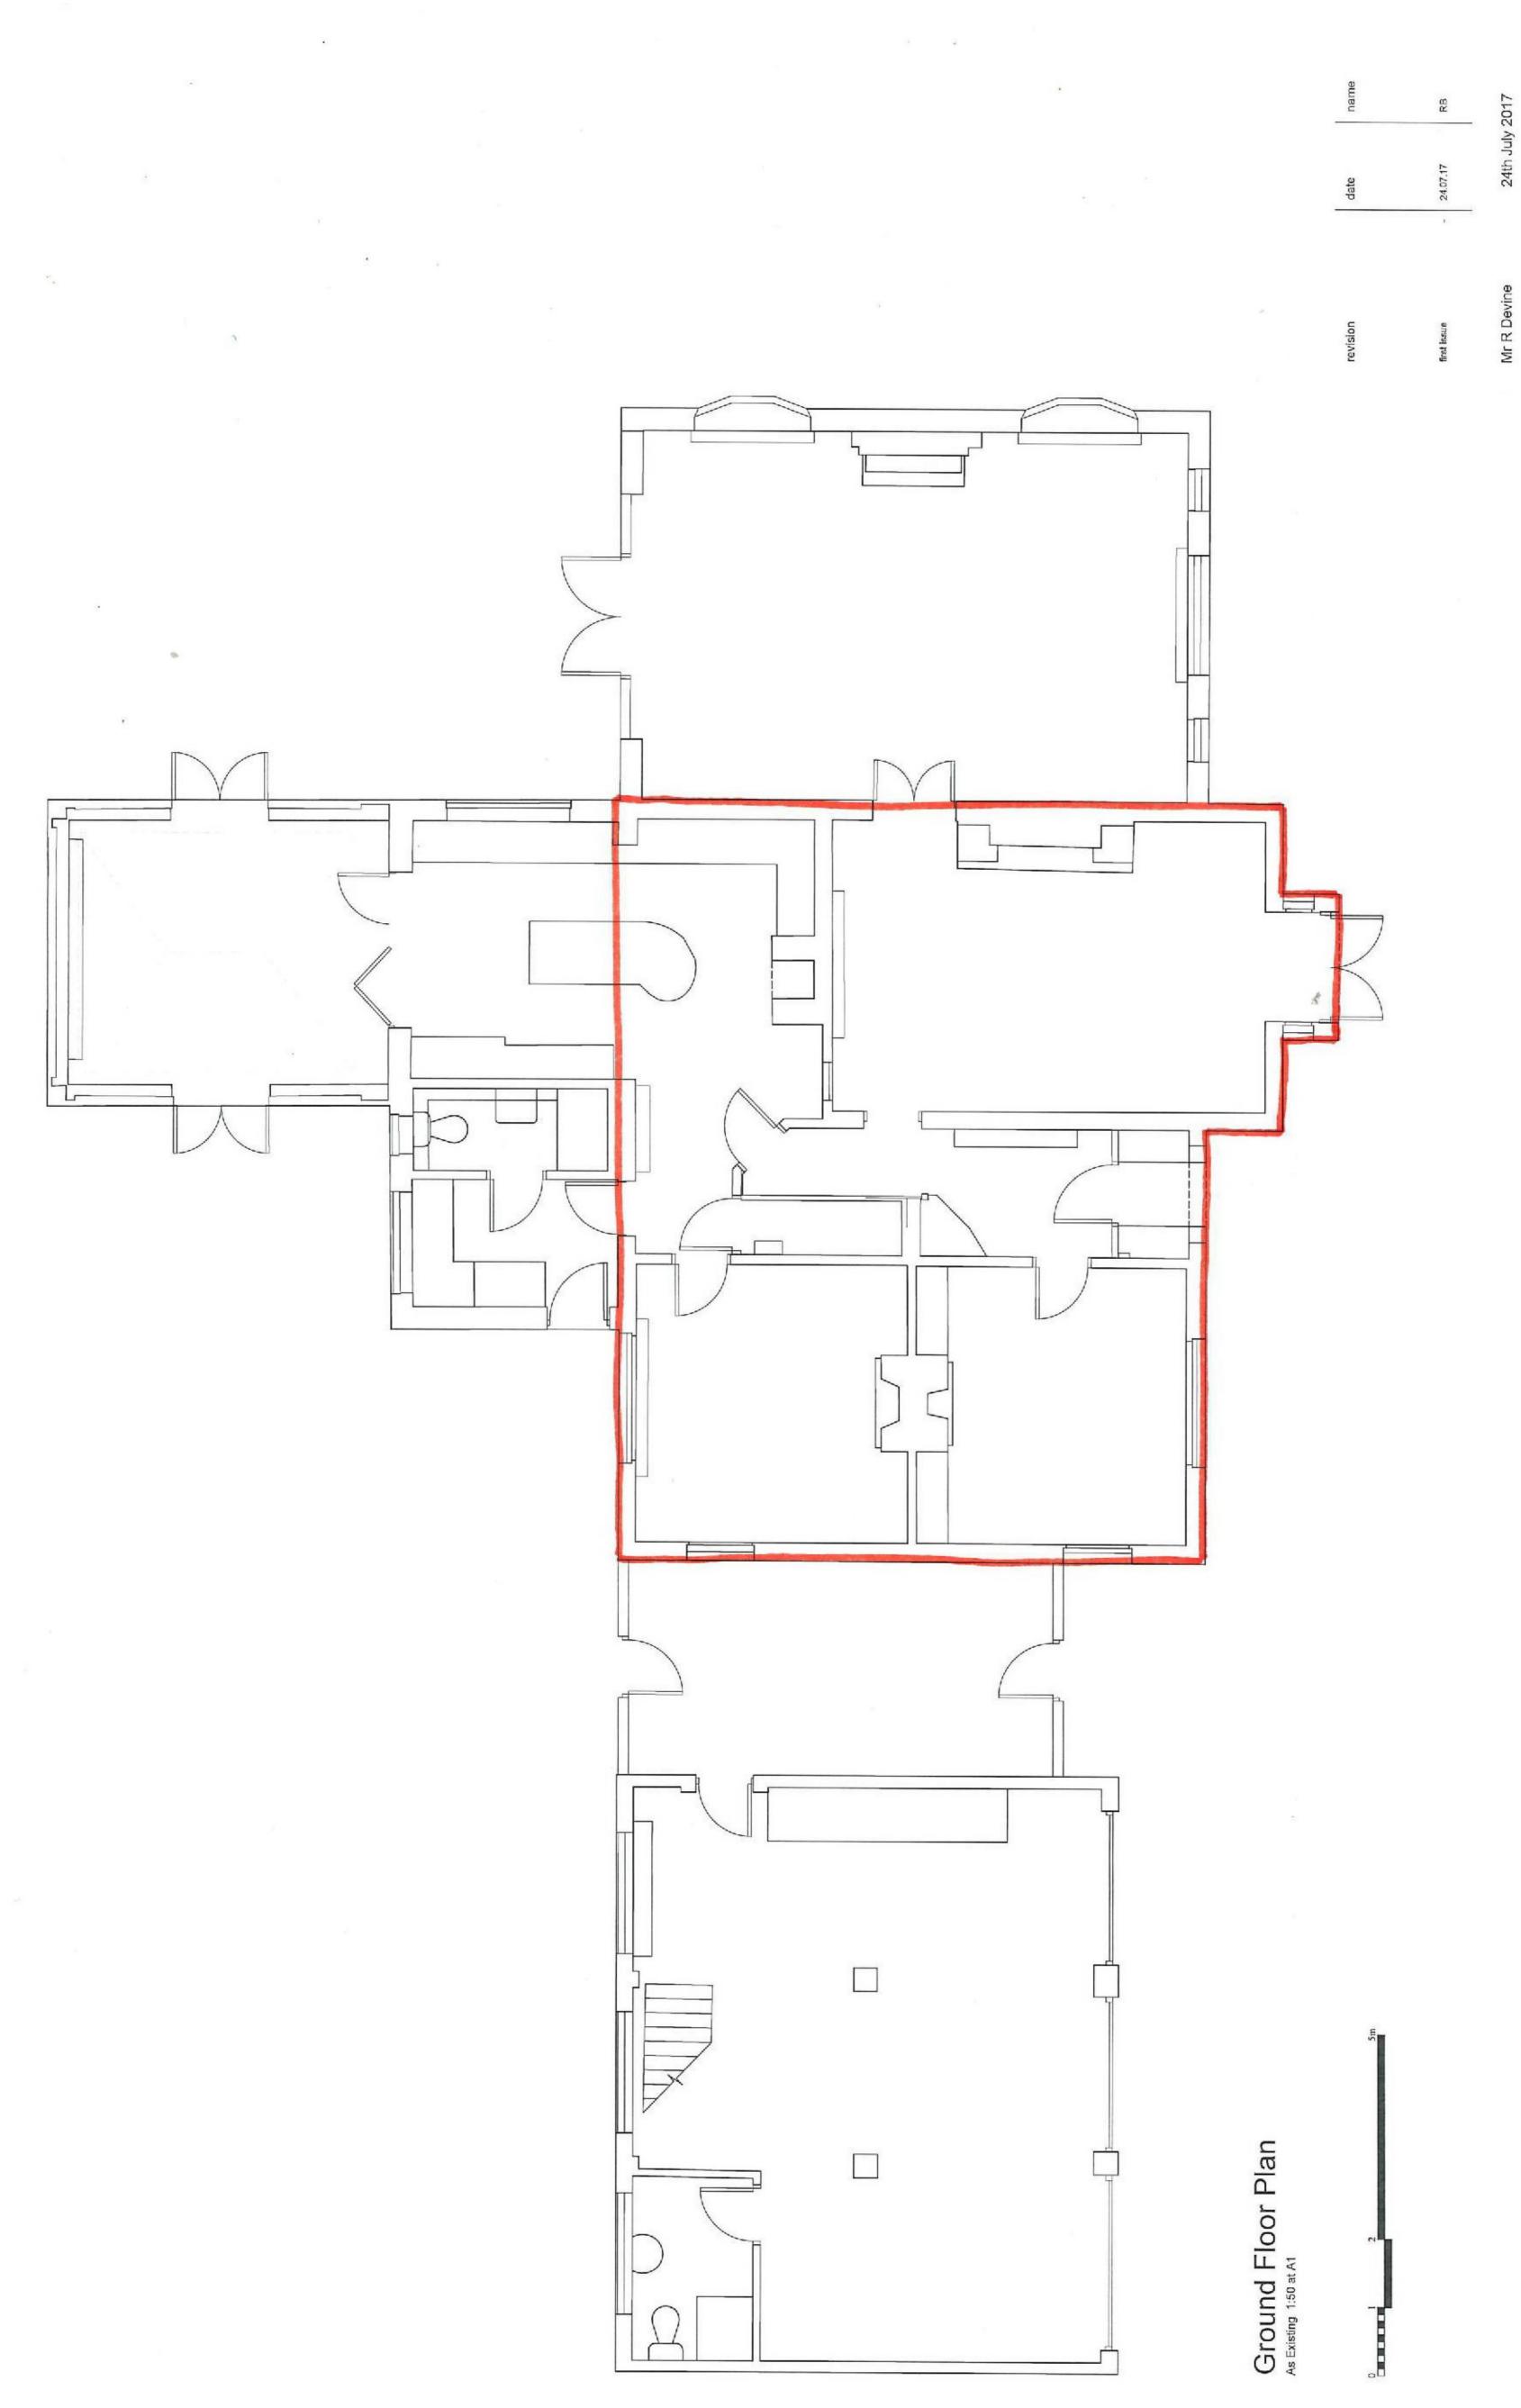

Copperfield House.
Rushmore Hill
Knockholt,
Sevenoaks, Kent.
TN14 7NL
Ground Floor Plan
As Existing

drawing number CH/001