








NOTES
 Do not scale from this Drawing.
 It is the Contractor's responsibility to check all governing dimensions with the Engineer and client and verify all dimensions on site before commencing any work or making any other drawings.
 This drawing to be read in conjunction with structural, mechanical and electrical drawings controlled by others and other relevant information and any discrepancies are to be reported to the Architect/Project Manager.
 Work and materials to be in accordance with the Building Regulations where appropriate and to comply with relevant British Standards. Materials to agree with Planning Conditions.
 This drawing is the copyright of Edwardson Associates Ltd and should not be reproduced in whole or in part without their written permission.

- NOTES**
1. Walls to be brick walls.
 2. All Brick columns to be topped with stone copings.

KEY

	ROAD & VEHICULAR ACCESS (TARMAC)
	BUILDINGS
	GRASS
	GRAVELLED AREA/HARDSTANDING
	EXISTING HEDGE PLANTING
	EXISTING TREE / PLANTING
	EXISTING POST AND RAIL TIMBER FENCE, 1.2m H
	EXISTING TIMBER FENCE, 1.8m H
	APPROVED DEVELOPMENT
	Sales Office (temporary)
	FPO Flag Pole 5.70m high
	Brick wall along Highway Access, 1.2m high along Highway
	Proposed Trees inside site
	NEW HEDGE PLANTING (indigenous species, including Hawthorn & Blackthorn)

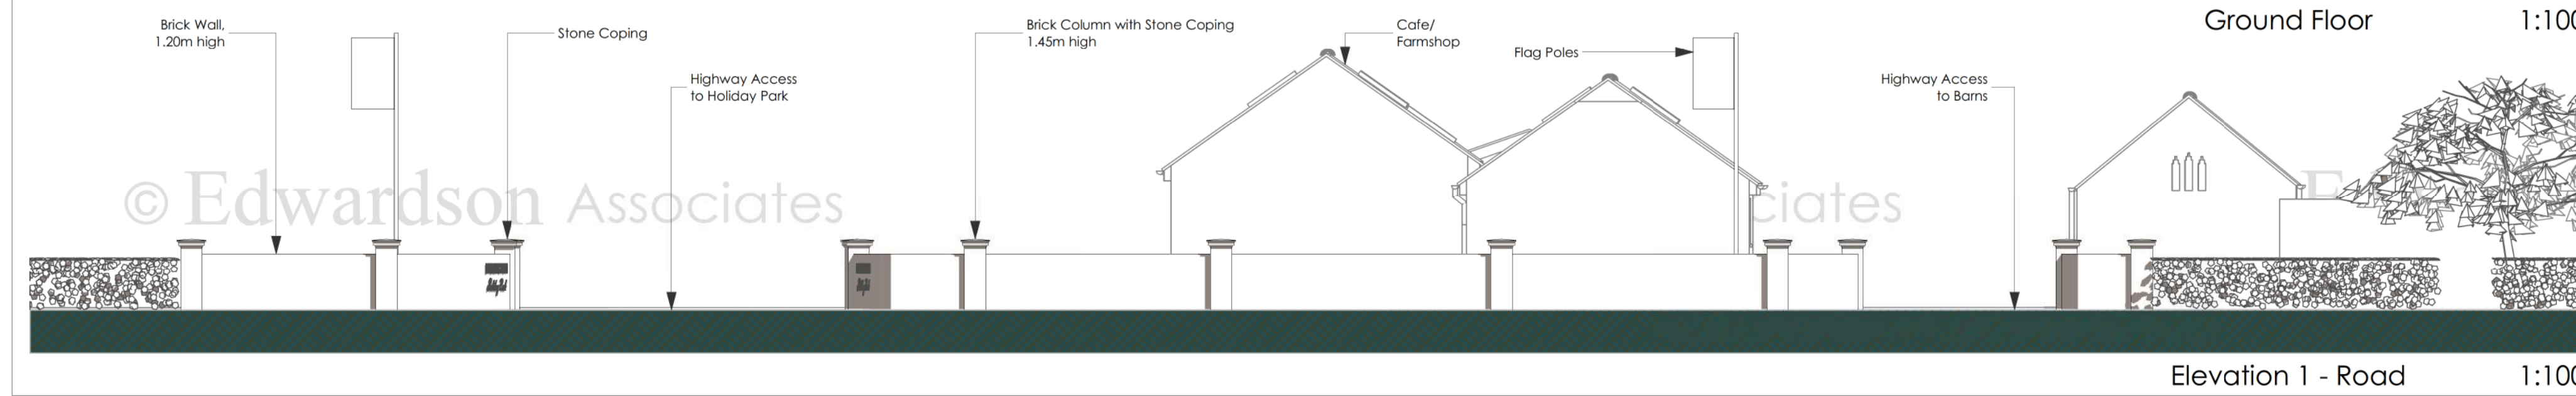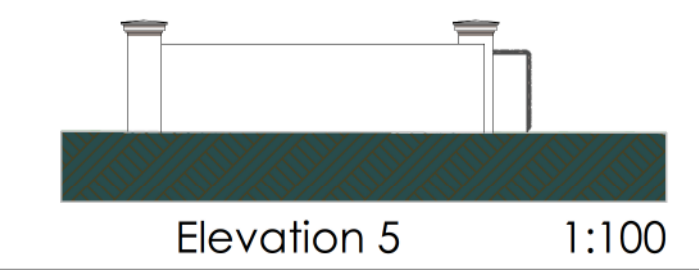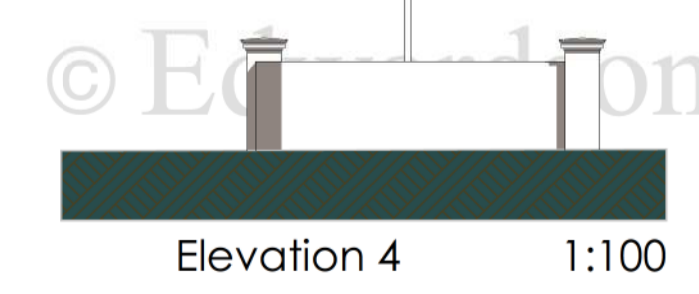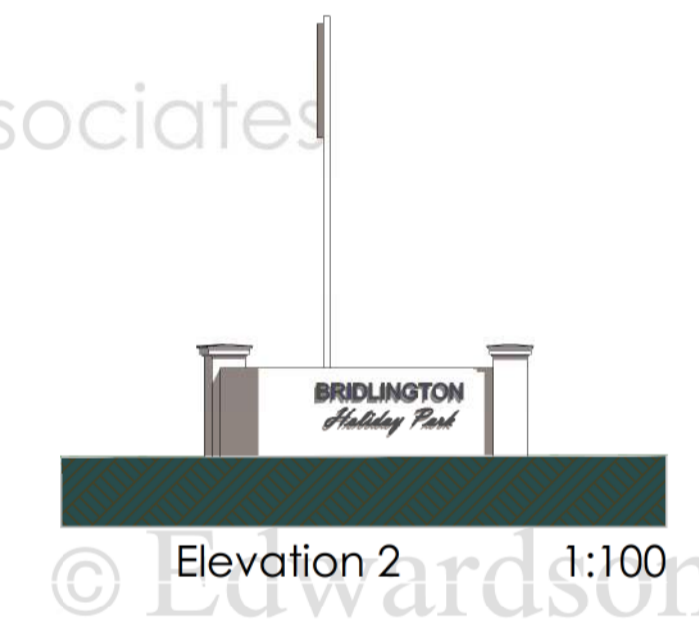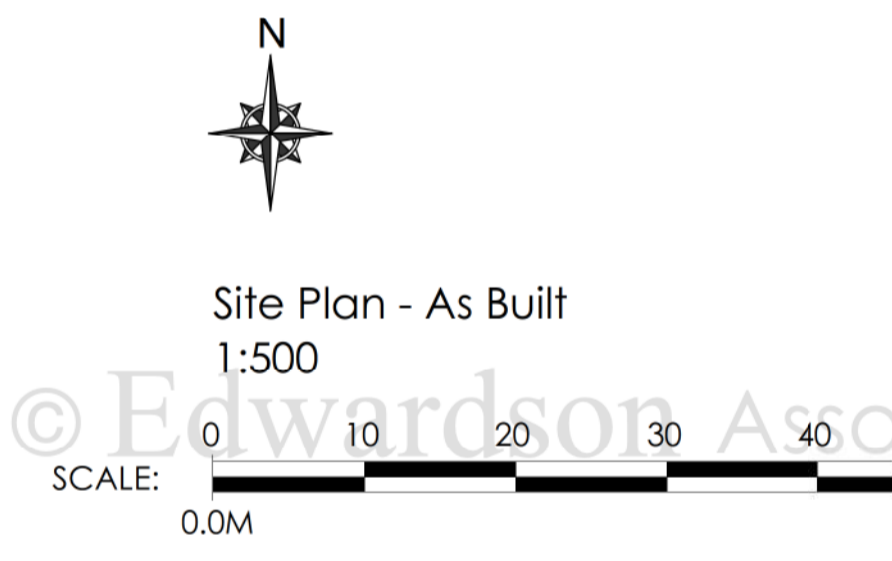

rev: notes: date: by:

© October 2021

EDWARDSON ASSOCIATES

project: Retention of existing entrance walls at Corner Farm, Moor Lane, Camaby, YO15 3QG

client: Mr. Edward Finney

drawing title: Site Plan, Floor Plan, Elevations - As Built

scale @ A1: 1:500, 1:100 date: October 2021

drawn: ABR checked:

job no: FIN.R.2021.10 drawing no: 002

issue status: Planning revision:

Padlock House, 10 Middle Street South
 Duffield, East Yorkshire, YO25 6PT
 tel: 01377 249720 fax: 01377 259052
 info@edwardsonassociates.com
 www.edwardsonassociates.com