



SITE PLAN - AS BUILT

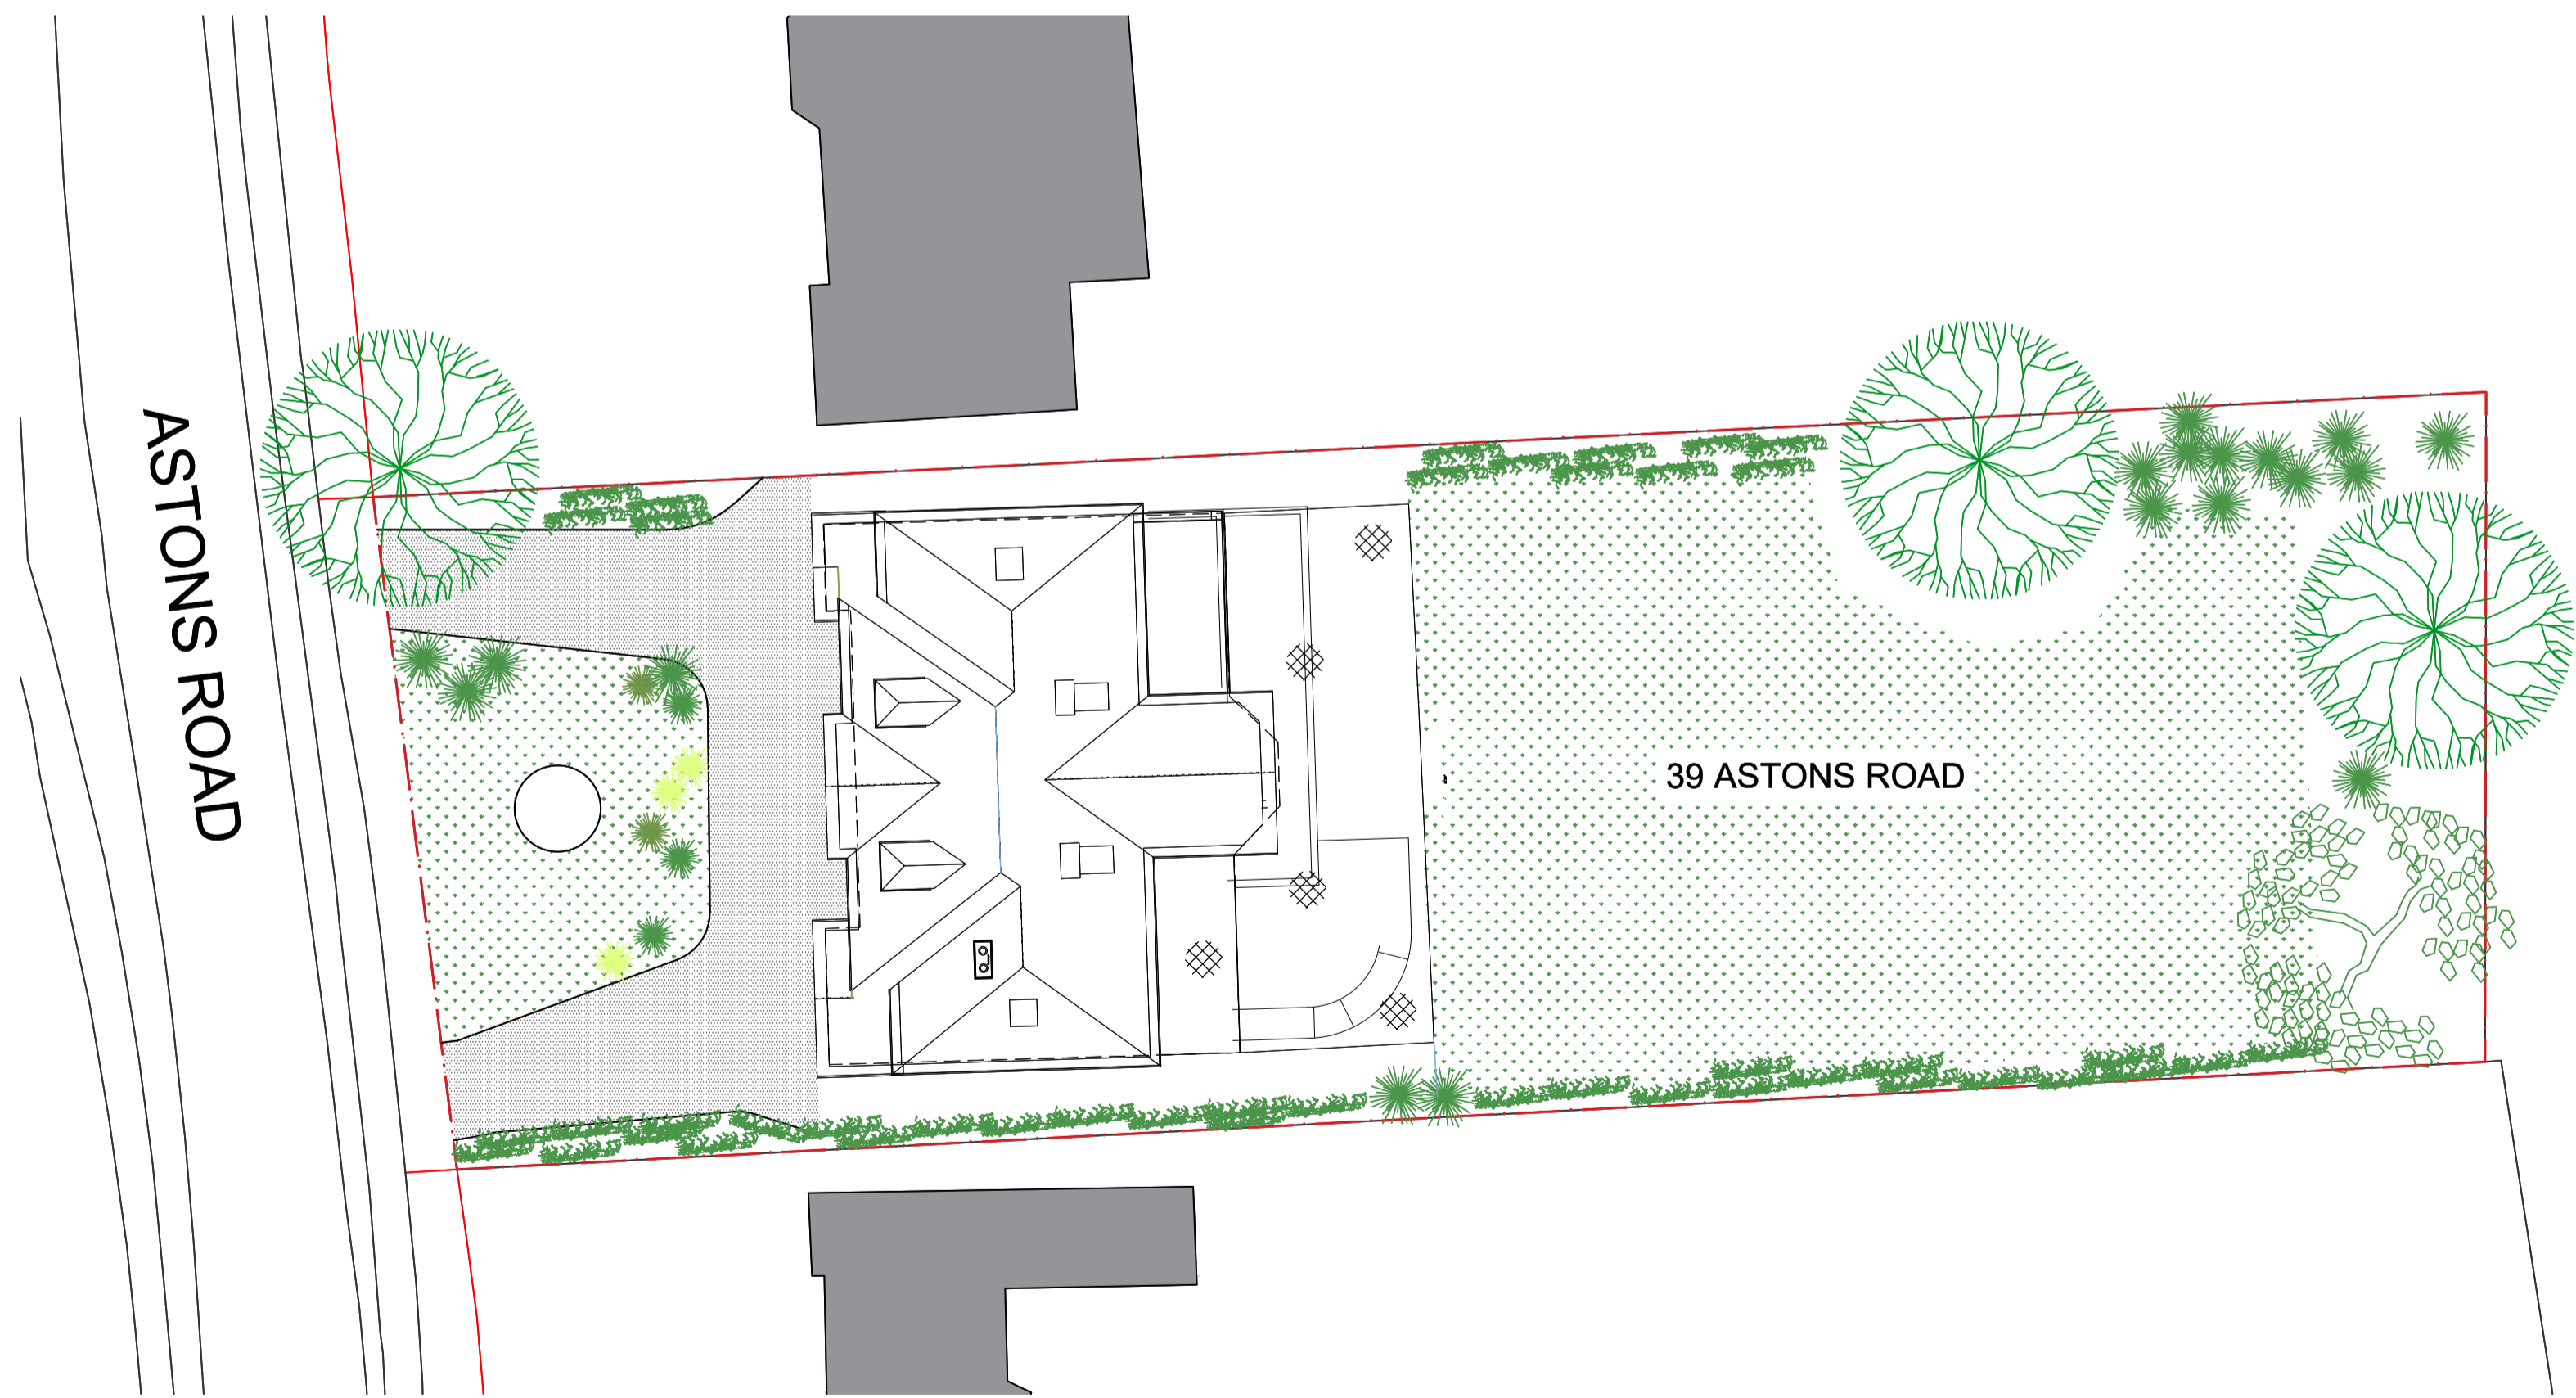

SITE PLAN - PRIOR TO BOLLARDS BEING INSTALLED

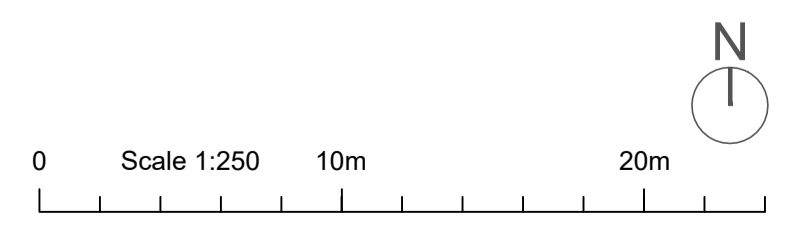

Amendments/Notes			
Rev.	Detail	By	Date
-	---	--	XX.XX.17

All dimensions and levels to be checked on site by contractor prior to preparation of shop drawings and commencement of work on site.
 This drawing and the copyrights and patents therein are the property of the Architect and may not be used or reproduced without consent.
 This drawing is to be read in conjunction with all relevant consultants and/or specialist's drawings/documents and any discrepancies or variations are to be notified to the Architect before the affected work commences.
 All works on site are to be carried out fully in accordance with current CDM regulations and recommendations, current Building Regulations, British Standards and Codes of Practice as appropriate.

Project
39 ASTONS ROAD
MOOR PARK, NORTHWOOD
HA6 2LB

Drawing
PROPOSED
SITE PLANS

SEABROOK
ARCHITECTS
 CHARTERED ARCHITECTS
 Link House, St Mary's Way, Chesham, Bucks HP5 1HR
 Tel: 01494 778918
 e-mail: gsp@gsparchitects.co.uk

Drawn By	MD	Date	Nov 2021
Checked By	Checked by	Date	Checked date
Approved By	Approved	Scale	As Shown@A1
Drawing No.	5473 PL309	Rev.	-