



GROUND FLOOR PLAN - 1:50

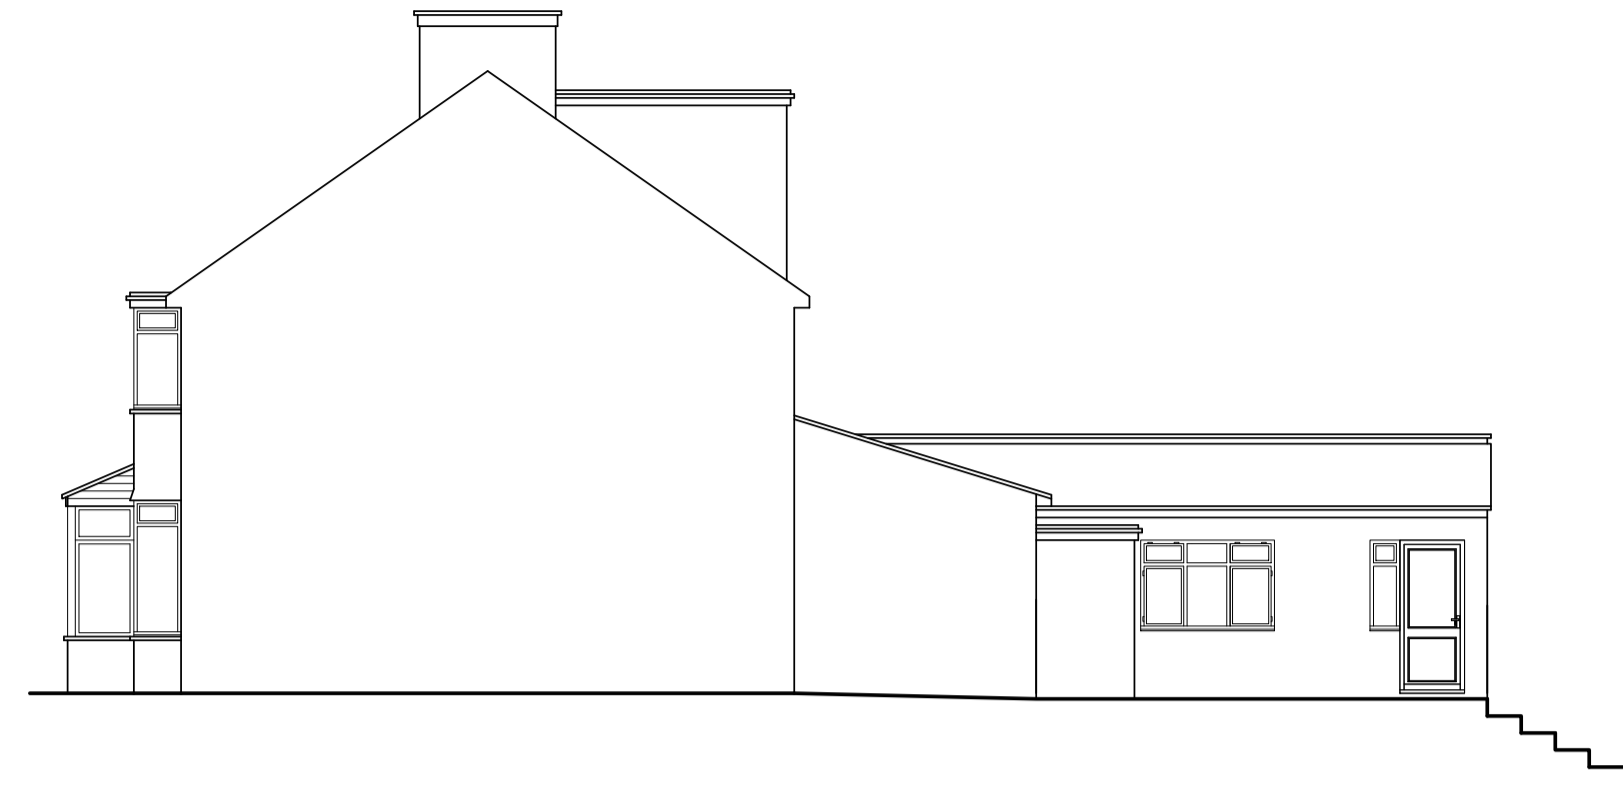


FLANK ELEVATION - 1:100

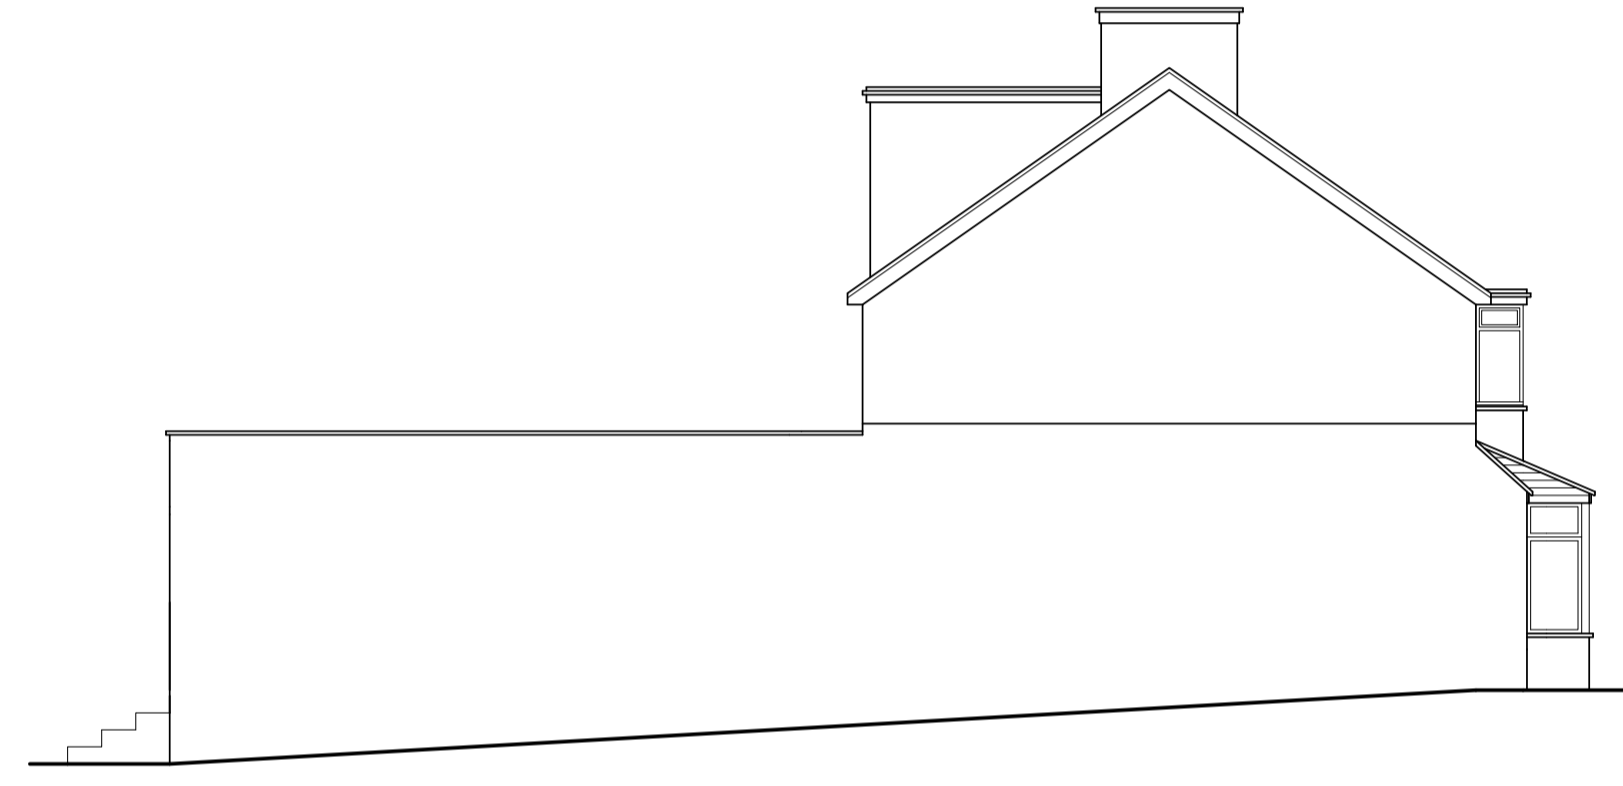



FLANK ELEVATION - 1:100



FRONT ELEVATION - 1:100

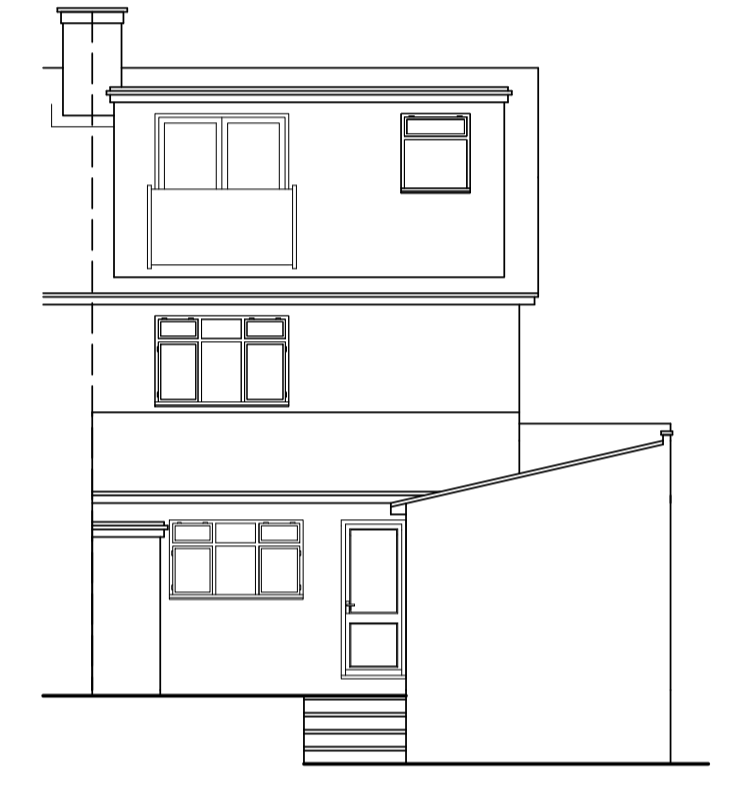

REAR ELEVATION - 1:100

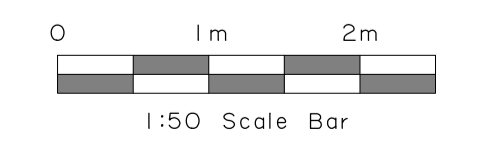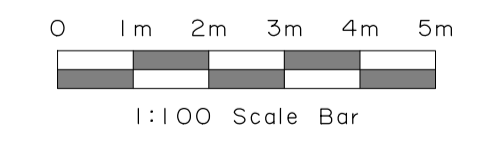

ALL DIMENSIONS & LEVELS ARE TO BE CHECKED ON SITE. ANY DISCREPANCIES ARE TO BE REPORTED IMMEDIATELY UPON DISCOVERY. THIS DRAWING IS FOR THE PURPOSE OF PLANNING PERMISSION & BUILDING REGULATIONS. AUTHORIZED DESIGNS LTD TAKES NO RESPONSIBILITY OR LIABILITY FOR ANY RELIANCE PLACED UPON OR USE MADE OF THIS DOCUMENT BY ANYONE FOR PURPOSES OTHER THAN FOR PLANNING AND BUILDING CONTROL APPROVAL. IT IS THE RESPONSIBILITY OF THE CLIENT TO RESOLVE ANY AND ALL MATTERS REGARDING THE PARTY WALL ACT 1992.

AUTHORIZED DESIGNS LTD CONFIRM THAT THESE PLANS HAVE BEEN PREPARED TAKING ACCOUNT OF THE CDM 2015 REGULATIONS AS FAR AS THEY RELATE TO THE DESIGNERS AND PRINCIPAL DESIGNERS DUTIES FOR THE PRE CONSTRUCTION PHASE FOR THE PURPOSE OF ACHIEVING PLANNING AND BUILDING REGULATION APPROVAL. THE CLIENT OR CLIENTS SUCCESSORS WILL BE REQUIRED TO COMPLY WITH THEIR OWN RESPONSIBILITIES AND DUTIES RELATING TO THE PRE CONSTRUCTION AND CONSTRUCTION PHASE SHOULD THE PROPOSALS PROGRESS FURTHER.

No.	Date	By	Contents
Revisions			

Drawing Title
As Built / Existing Floor Plans & Elevations

Project
 Retention of single storey front, side & rear extension with revisions (changes to the roof of the rear projection & boiler room)

Scale	Date	Drawn by
1:50 / 1:100	September 2020	SD

Client Details
 Mrs Shila Patel
 72 Cain Park Road
 London
 NW9 6HS

Dwg.No.	Rev.
CPR PA 01	A