


**THIS DRAWING IS COPYRIGHT:**  
 DIMENSIONS SHOULD NOT BE SCALED FROM THE  
 DRAWINGS FIGURED DIMENSIONS TO BE USED &  
 CHECKED ON SITE PRIOR TO START OF ANY WORK

REVISIONS	Date	Inl
<b>A</b>		
Update following survey	21/02/2021	NB
<b>B</b>		
Pool rooflight; side window	09/03/2021	NB
<b>C</b>		
Zinc spandrels + parapet	31/03/2021	NB
<b>D</b>		
Retain pool pump room + air source heat pump with new cladding; roof terrace	13/09/2021	NB
<b>E</b>		
Side window; rooflight to pitched roof	23/04/2022	NB

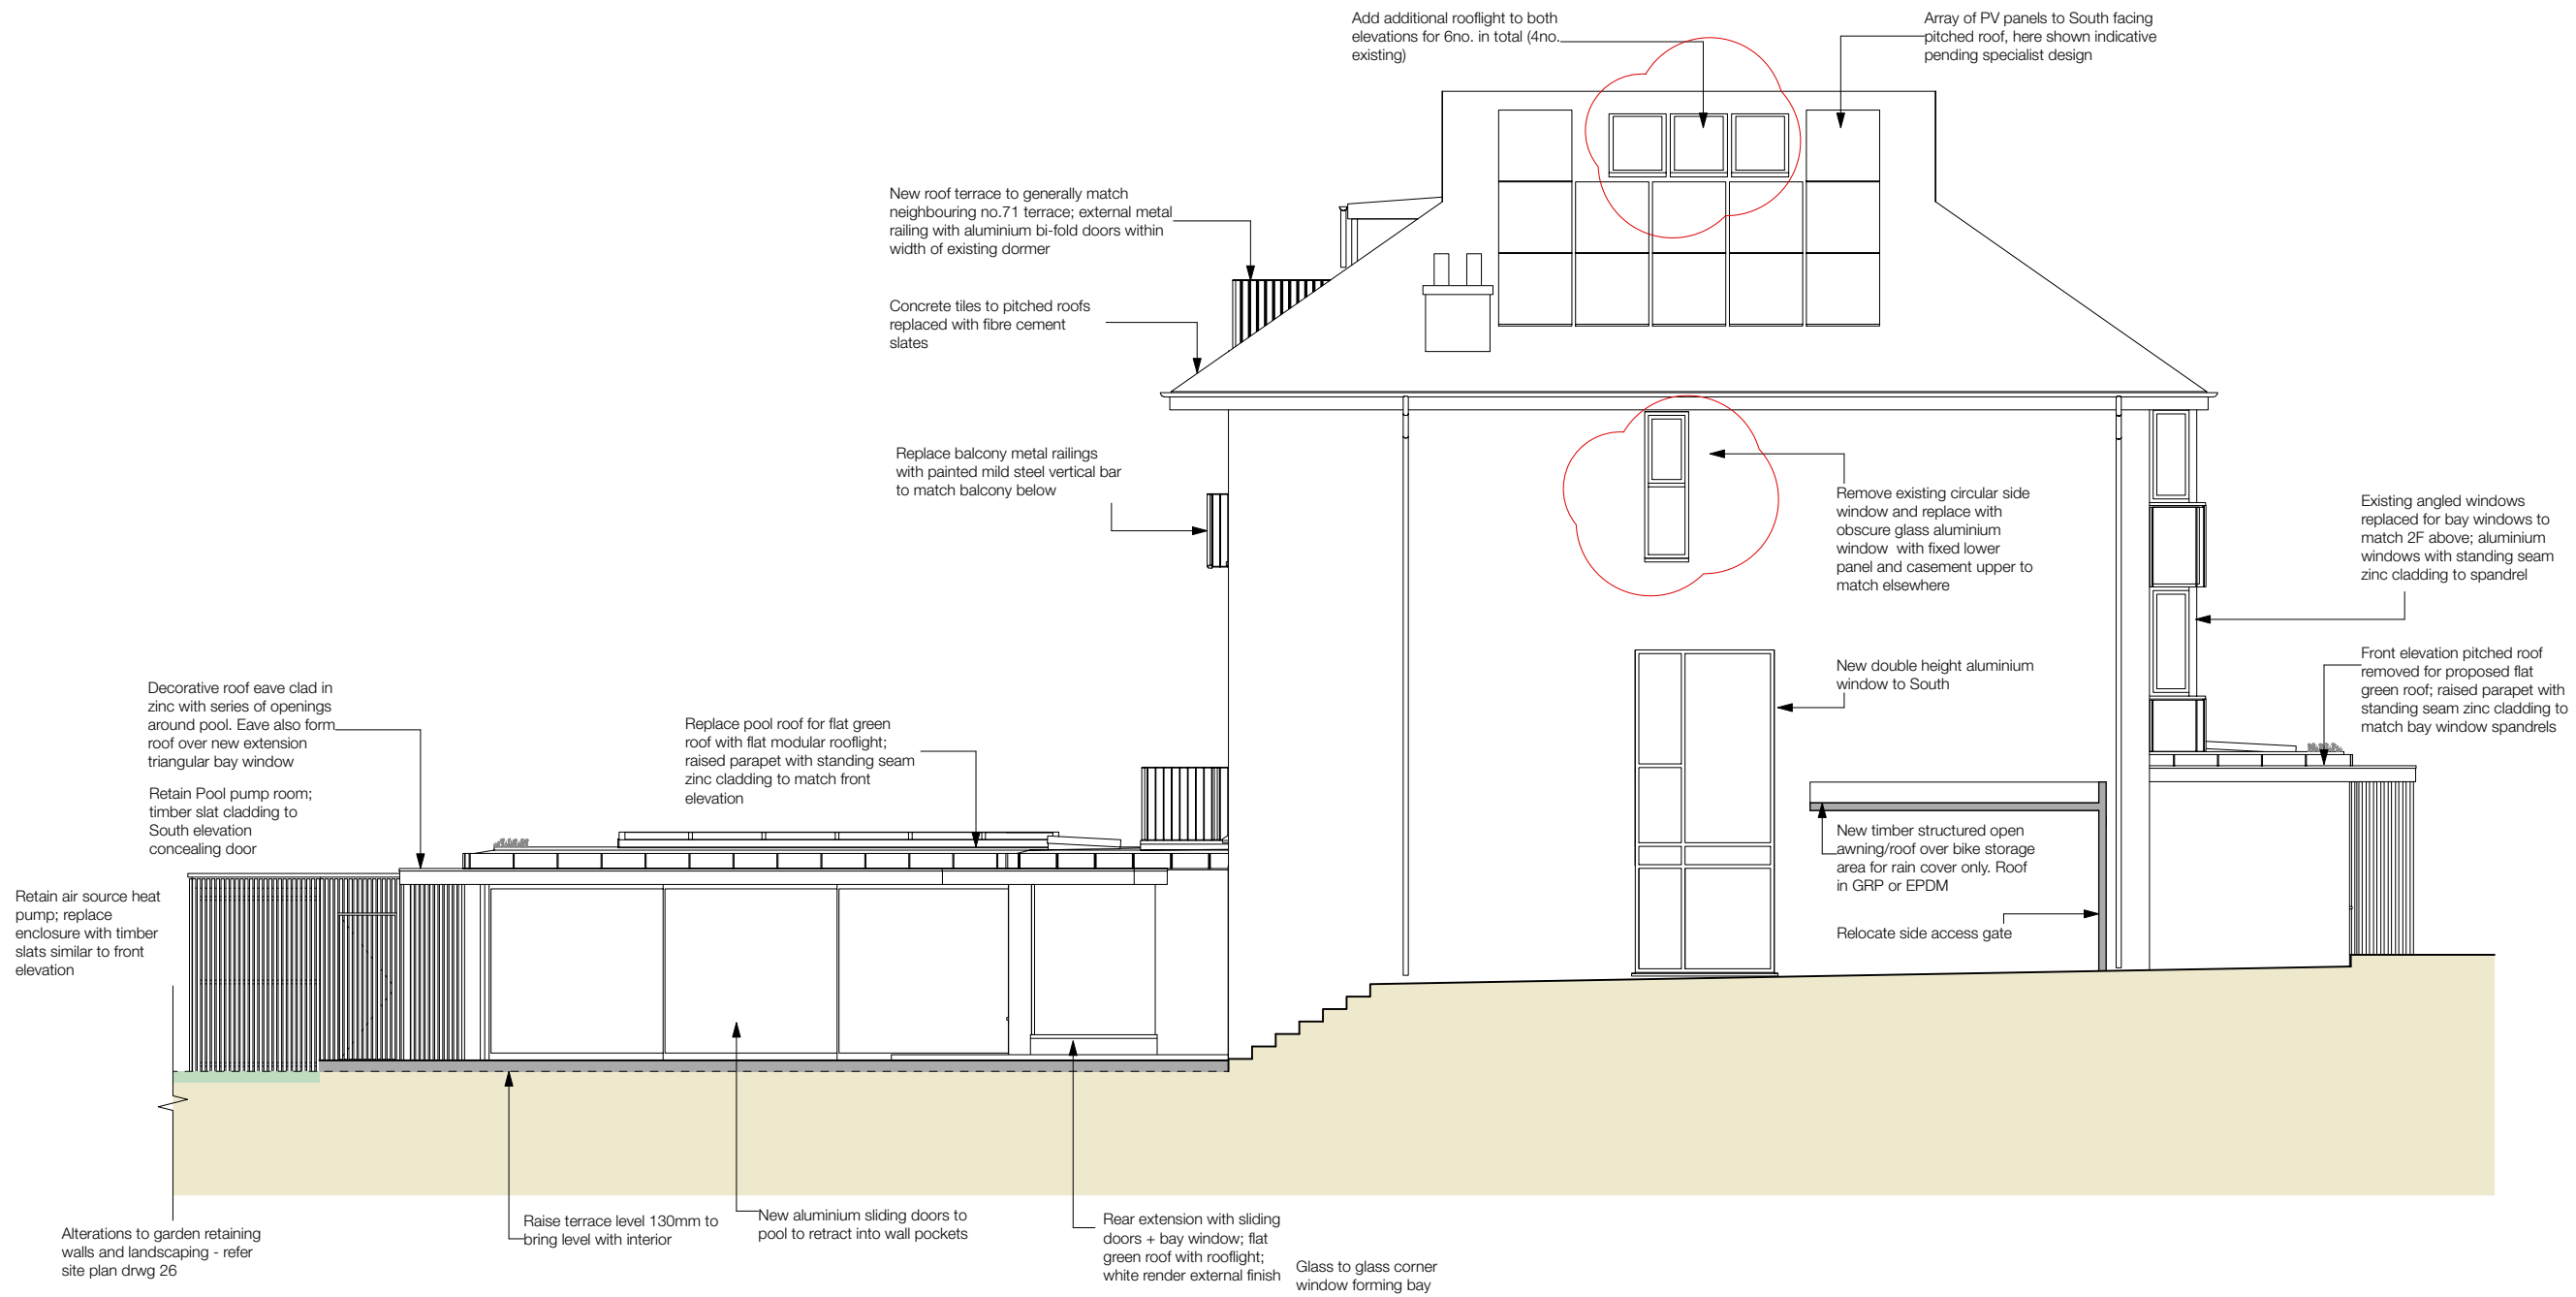

**SCHEME LEVEL**

Based on record drawings by others

**Job:** 69 West Heath Road, NW3 7TH  
**Client:** M. & N. Bowden  
**Title:** South Side Elevation : Proposed  
 Scale: 1:100  
 Drawing No: 2020-09-24  
 Rev: NB  
 Drawn by: NB  
 Date: 04/01/2021



**SOUTH SIDE ELEVATION : PROPOSED**

Scale 1:100

