


**THIS DRAWING IS COPYRIGHT:**  
DIMENSIONS SHOULD NOT BE SCALED FROM THE  
DRAWINGS FIGURED DIMENSIONS TO BE USED &  
CHECKED ON SITE PRIOR TO START OF ANY WORK

REVISIONS	Date	Inl
<b>A</b>		
Update following survey	20/02/2021	NB
<b>B</b>		
Pool rooflight	09/03/2021	NB
<b>C</b>		
Zinc spandrels	31/03/2021	NB
<b>D</b>		
Wardrobes	15/07/2021	NB
<b>E</b>		
Retain pool plant room + air source heat pump; En-suite; services	13/09/2021	NB
<b>F</b>		
Retain Bedm 2-1 + Kitchenette	21/09/2021	NB
<b>G</b>		
Side windows	23/04/2022	NB

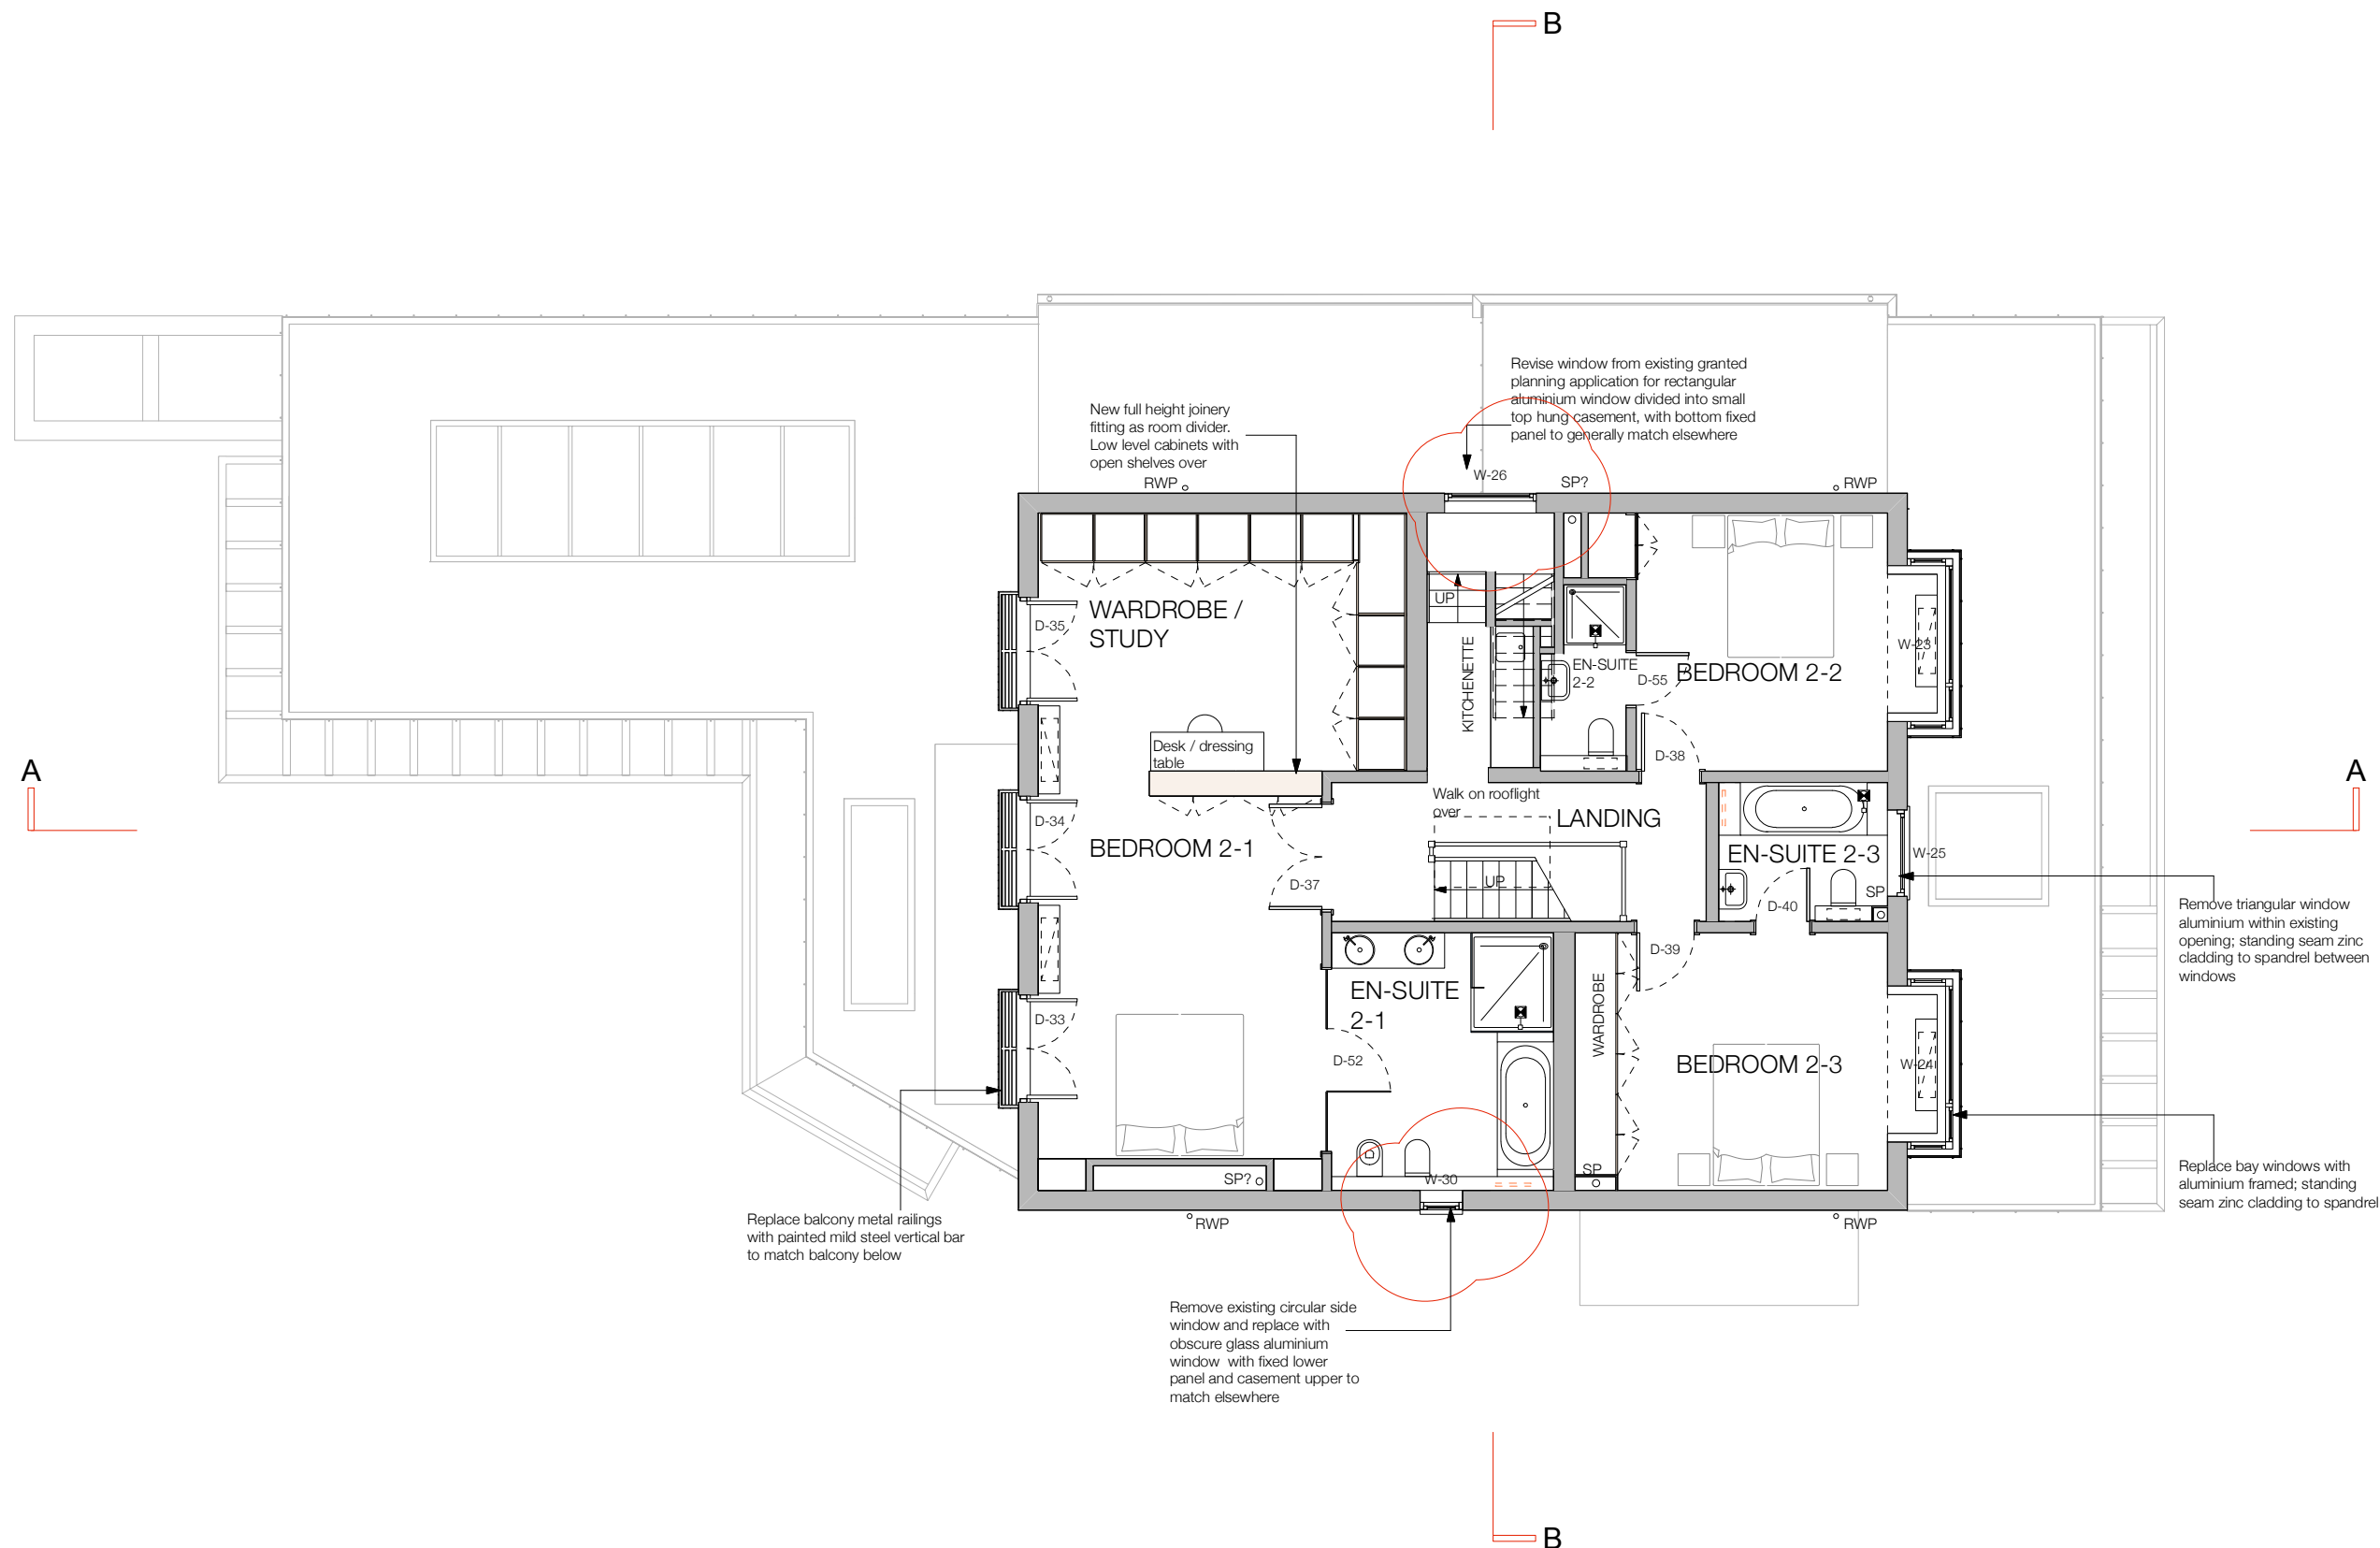

**SECOND FLOOR PLAN : PROPOSED**

Scale 1:100



**SCHEME LEVEL**

Based on record drawings by others

**Job:** 69 West Heath Road, NW3 7TH

**Client:** M. & N. Bowden

**Title:** Second Floor Plan : Proposed

Scale: 1:100

Drawing No: 2020-09-16

Rev: NB

Date: 04/01/2021

