


THIS DRAWING IS COPYRIGHT:
 DIMENSIONS SHOULD NOT BE SCALED FROM THE
 DRAWINGS FIGURED DIMENSIONS TO BE USED &
 CHECKED ON SITE PRIOR TO START OF ANY WORK

REVISIONS	Date	Inl
A		
Update following survey	21/02/2021	NB
B		
Pool rooflight	09/03/2021	NB
C		
Zinc spandrels + parapet	31/03/2021	NB
D		
Retain pool pump room + air source heat pump with new cladding; roof terrace	13/09/2021	NB
E		
Side window; rooflight to main pitched roof	23/04/2022	NB

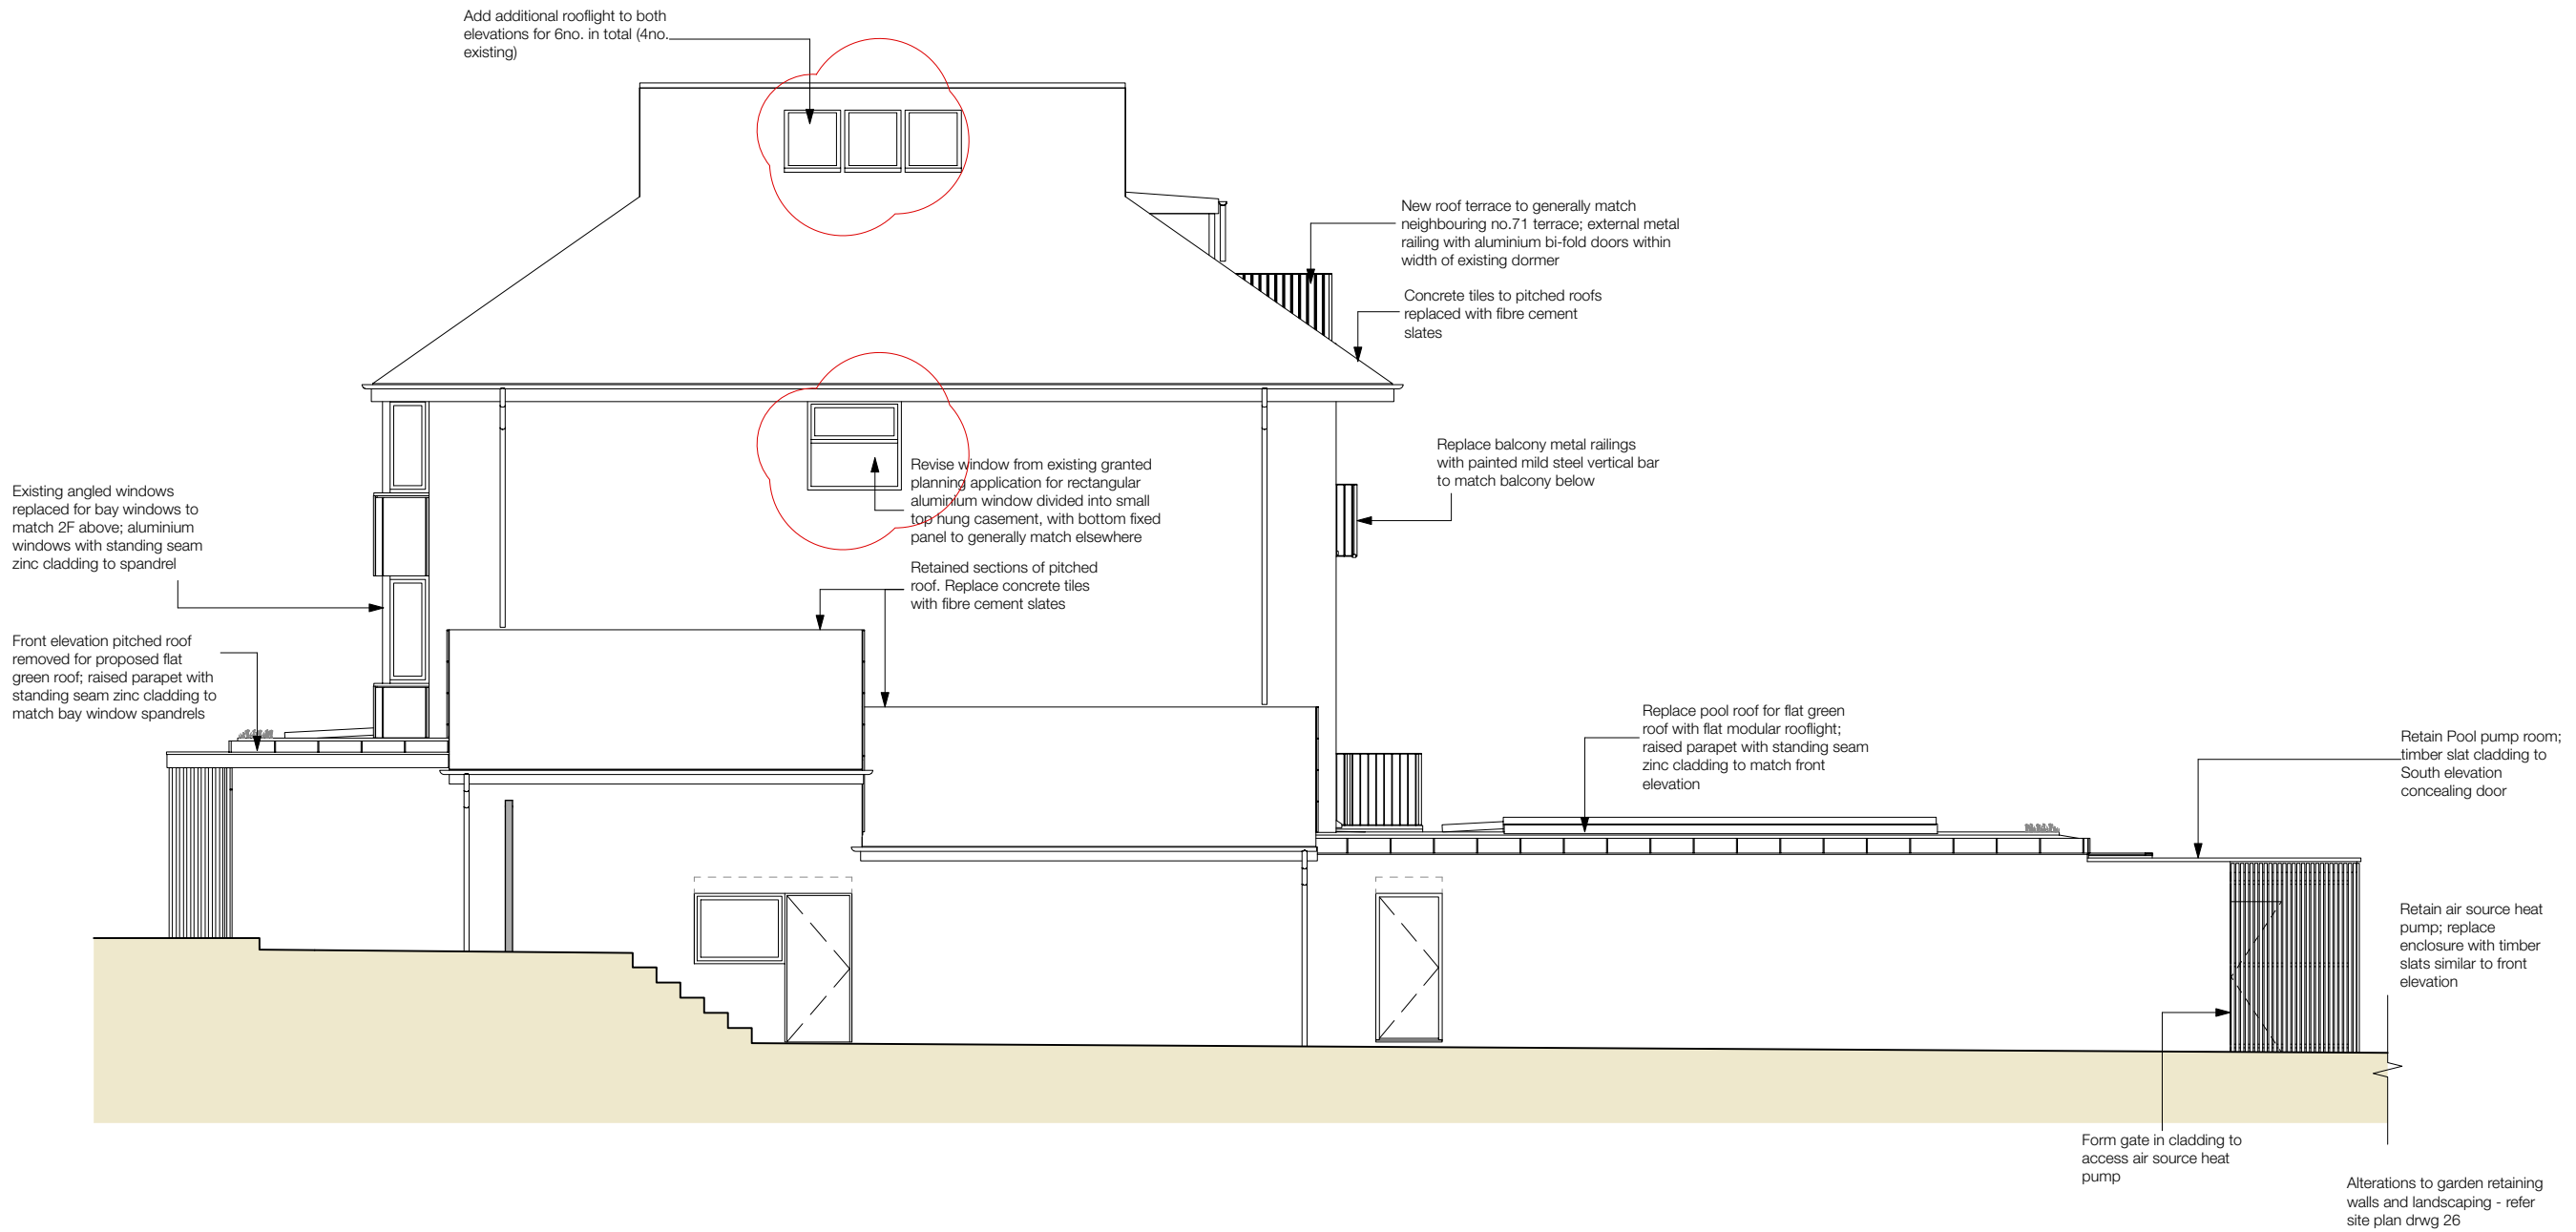

NORTH SIDE ELEVATION : PROPOSED

Scale 1:100



SCHEME LEVEL

Based on record drawings by others

Job: 69 West Heath Road, NW3 7TH

Client: M. & N. Bowden

Title: North Side Elevation : Proposed

Scale: 1:100

Drawing No: 2020-09-23

Rev: E

Drawn by: NB

Date: 04/01/2021

