modece architects


4 The Old Fox Yard, Ipswich Street, Stowmarket, IP14 4AB t.01284 830085 e.studio@modece.com www.modece.com

client ALEX & ALEXANDRA BLACK


 scale
 drawn
 date
 project no
 dwg no
 rev


 1:100 @ A1
 SR
 11/03/2022
 2070
 200

Note : All interventions have been indicated in RED

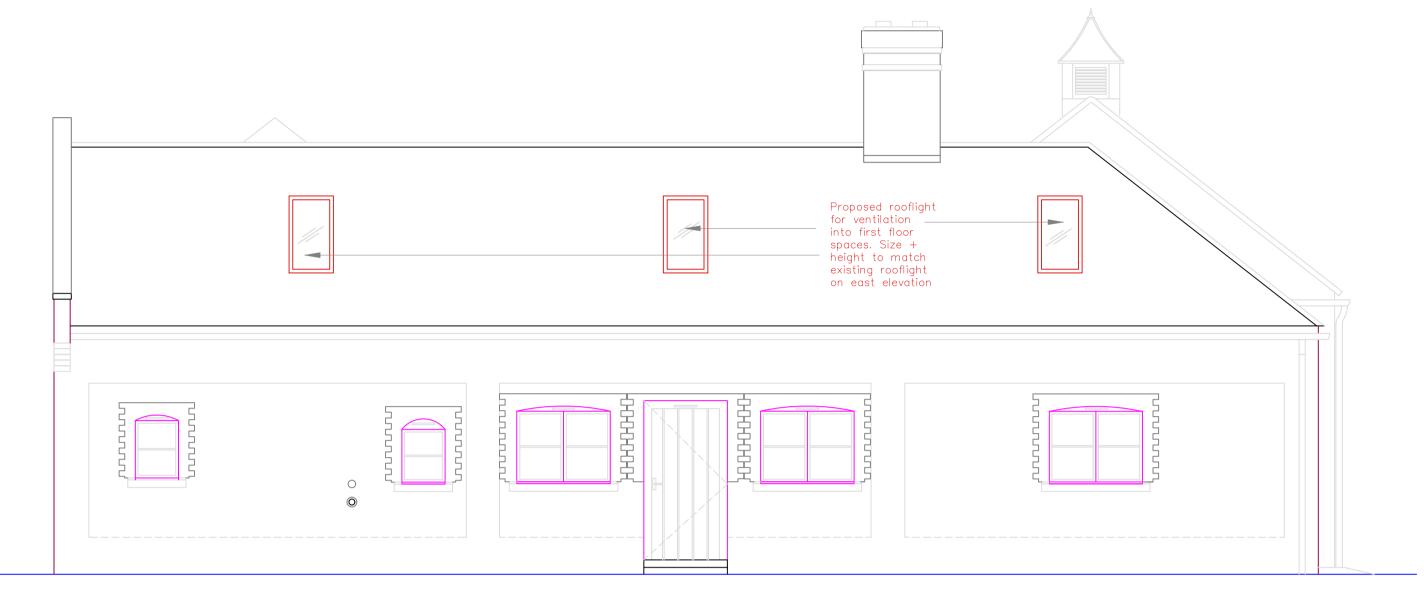


North Elevation [Proposed]

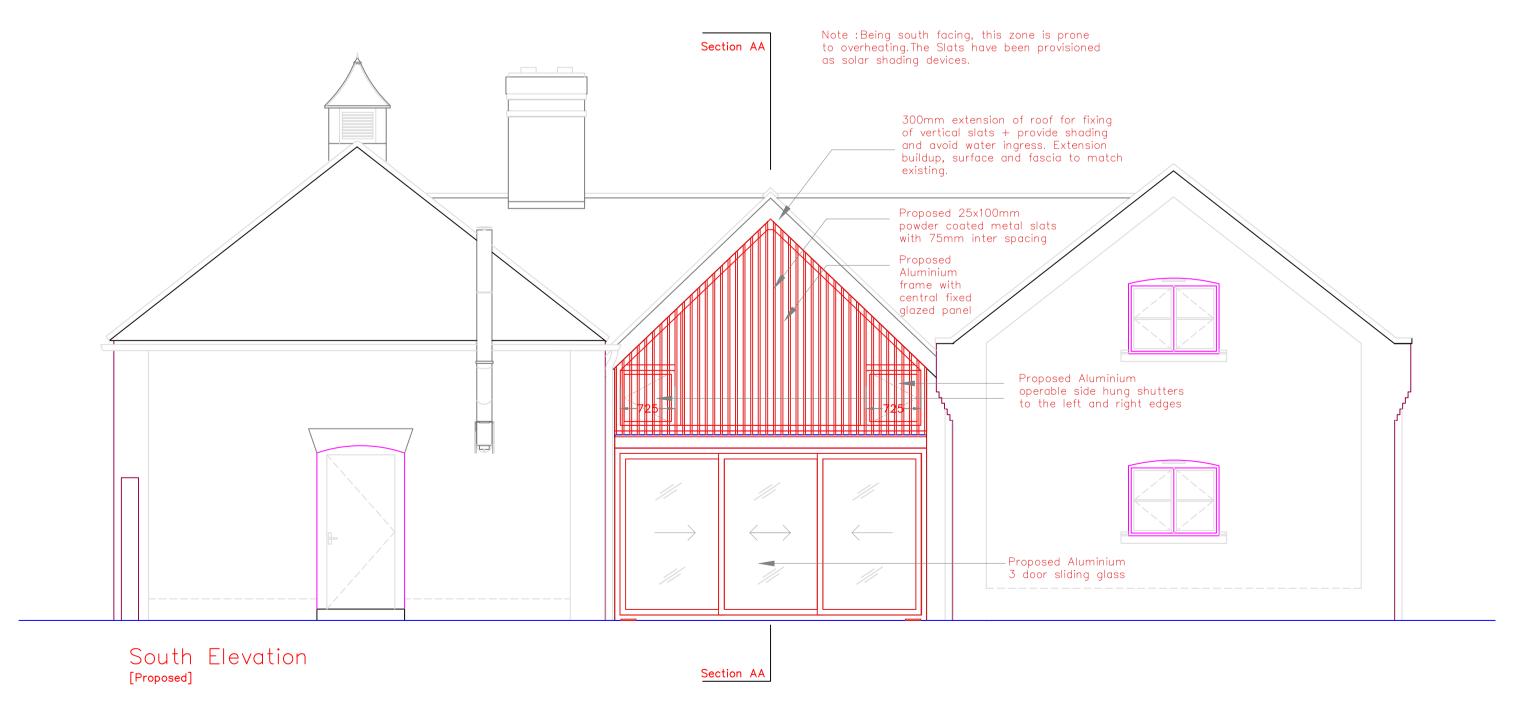

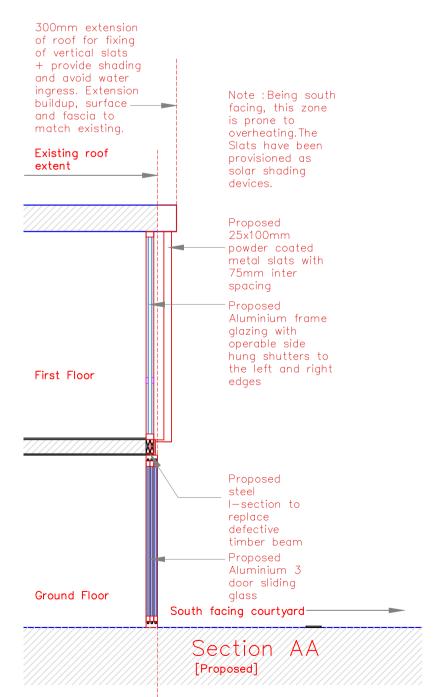




South Elevation [Existing]

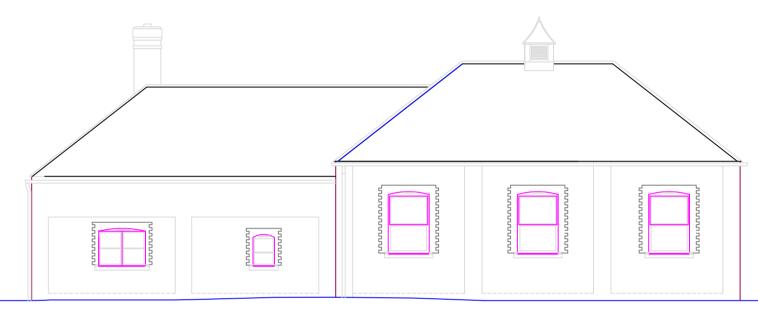

West Elevation
[Existing]

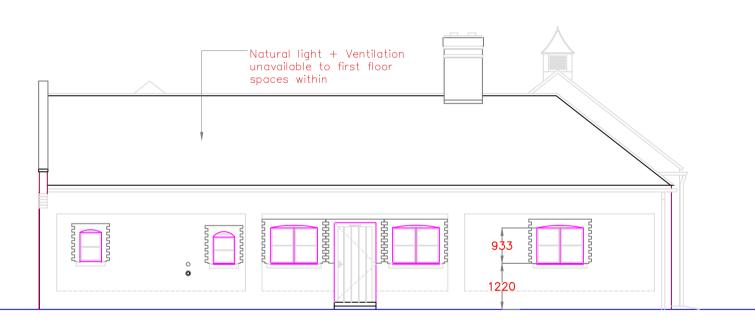

North Elevation [Existing]



East Elevation [Existing]