


General Notes


In all cases figured dimensions shall be taken in preference to scaled dimensions. All relevant dimensions shall be checked on site before any prefabricated work is put in hand. This drawing is copyright and shall not be reproduced without written permission.




South East Elevation (Section a-a)

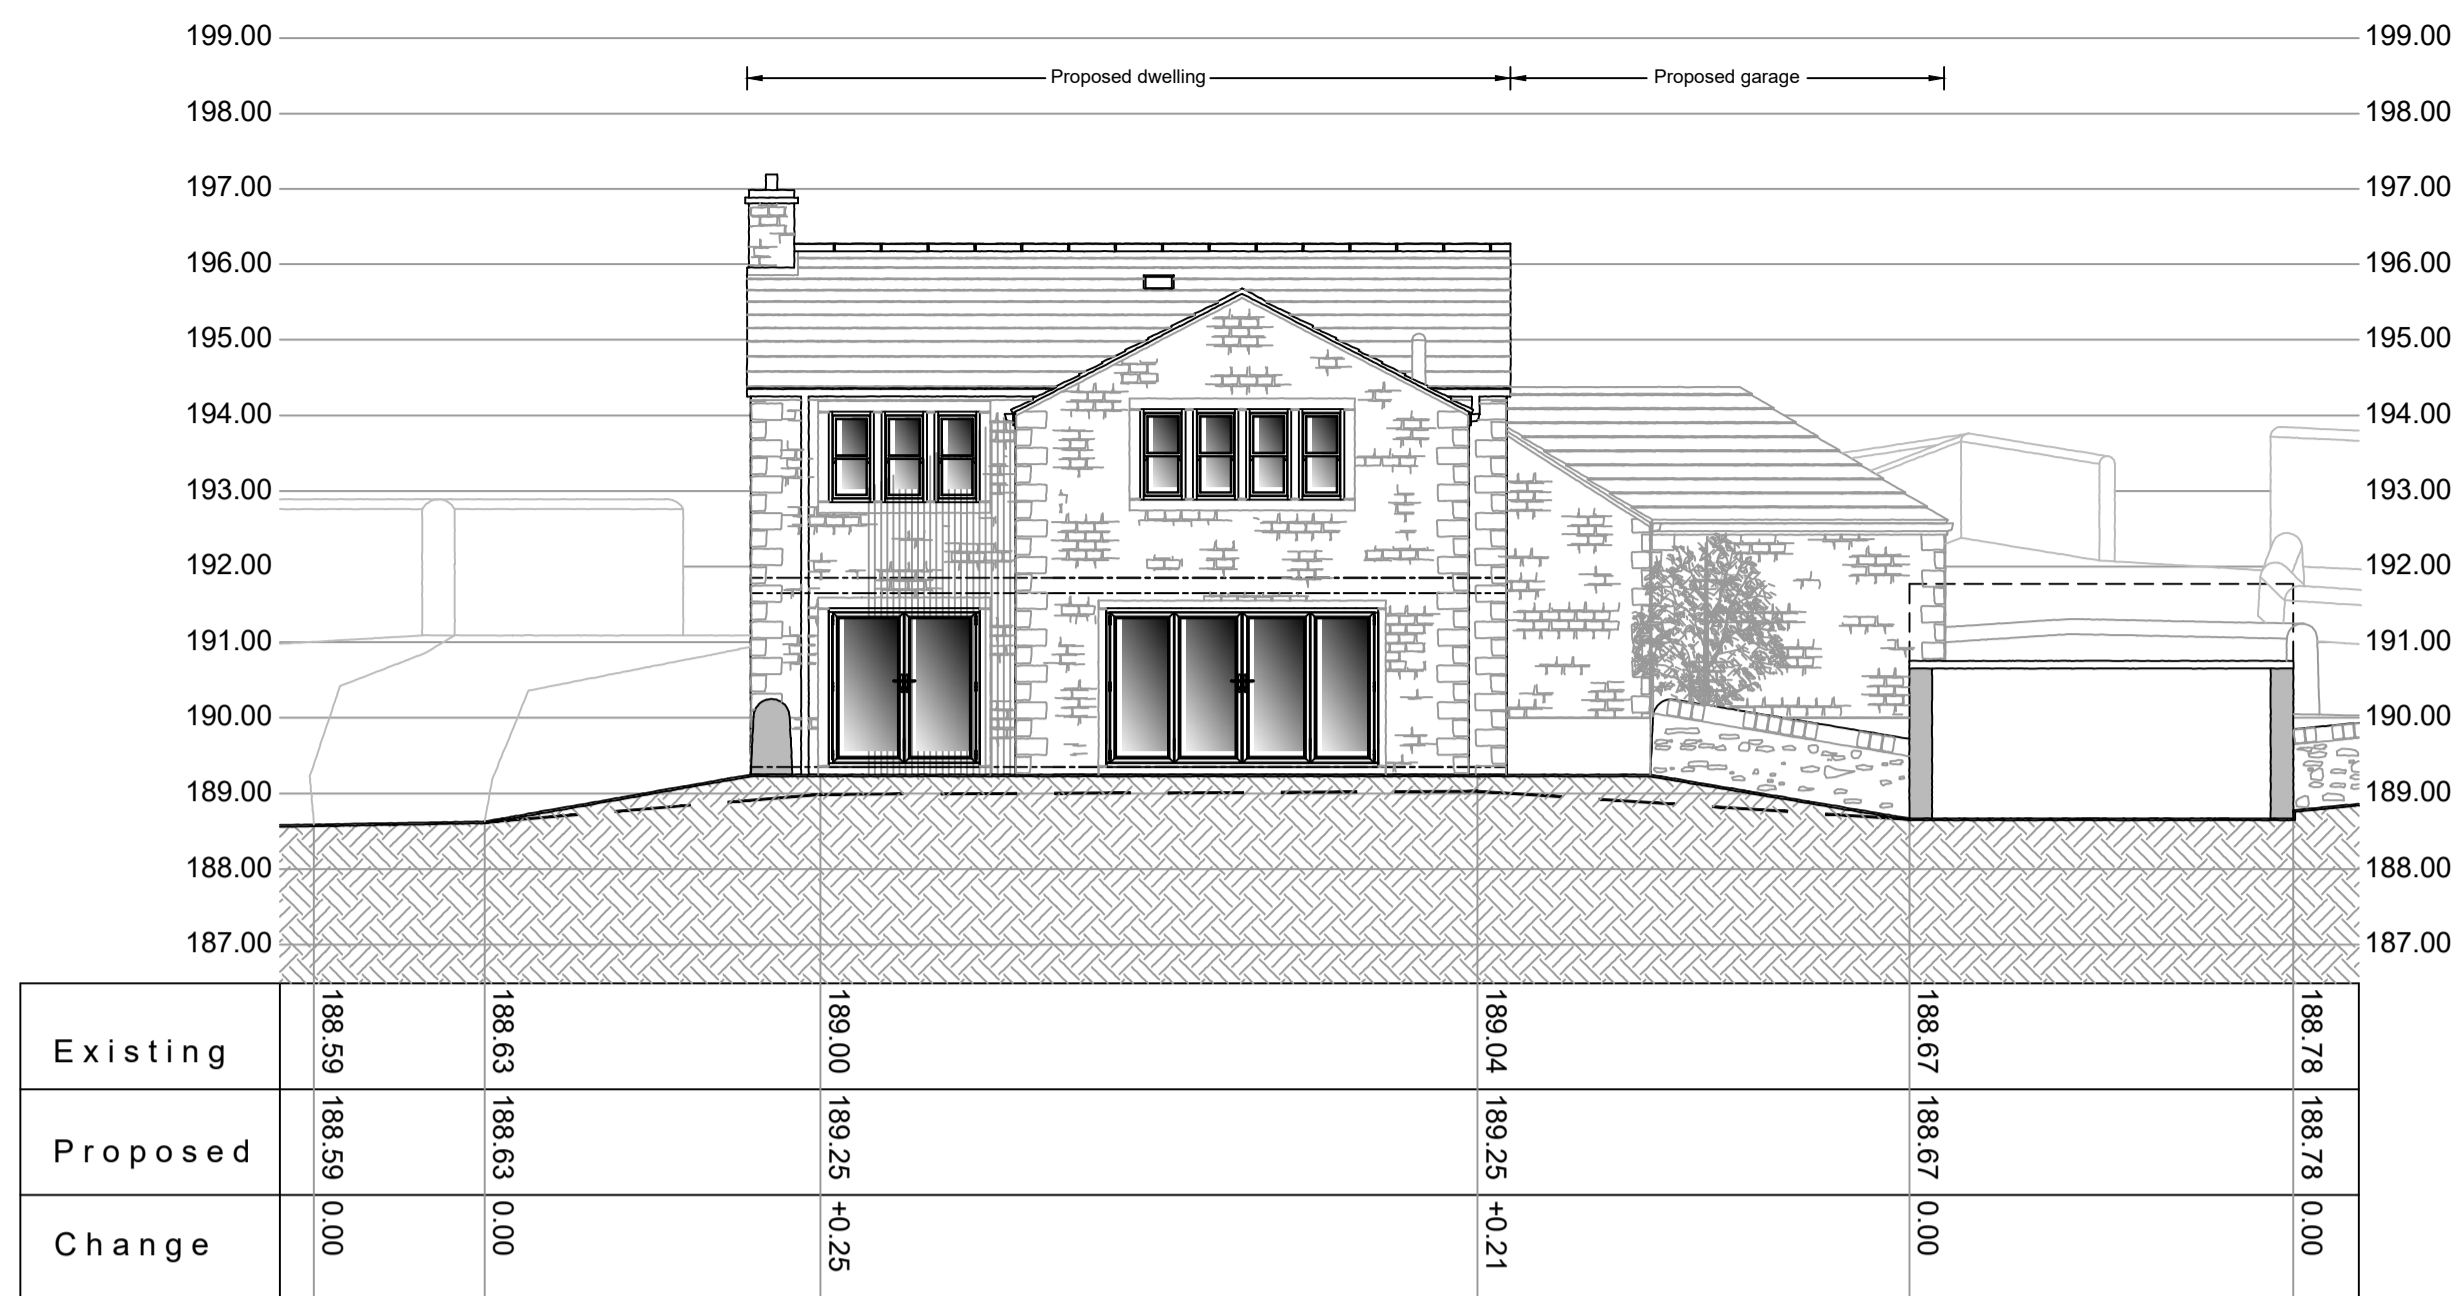

North West Elevation (Section b-b)

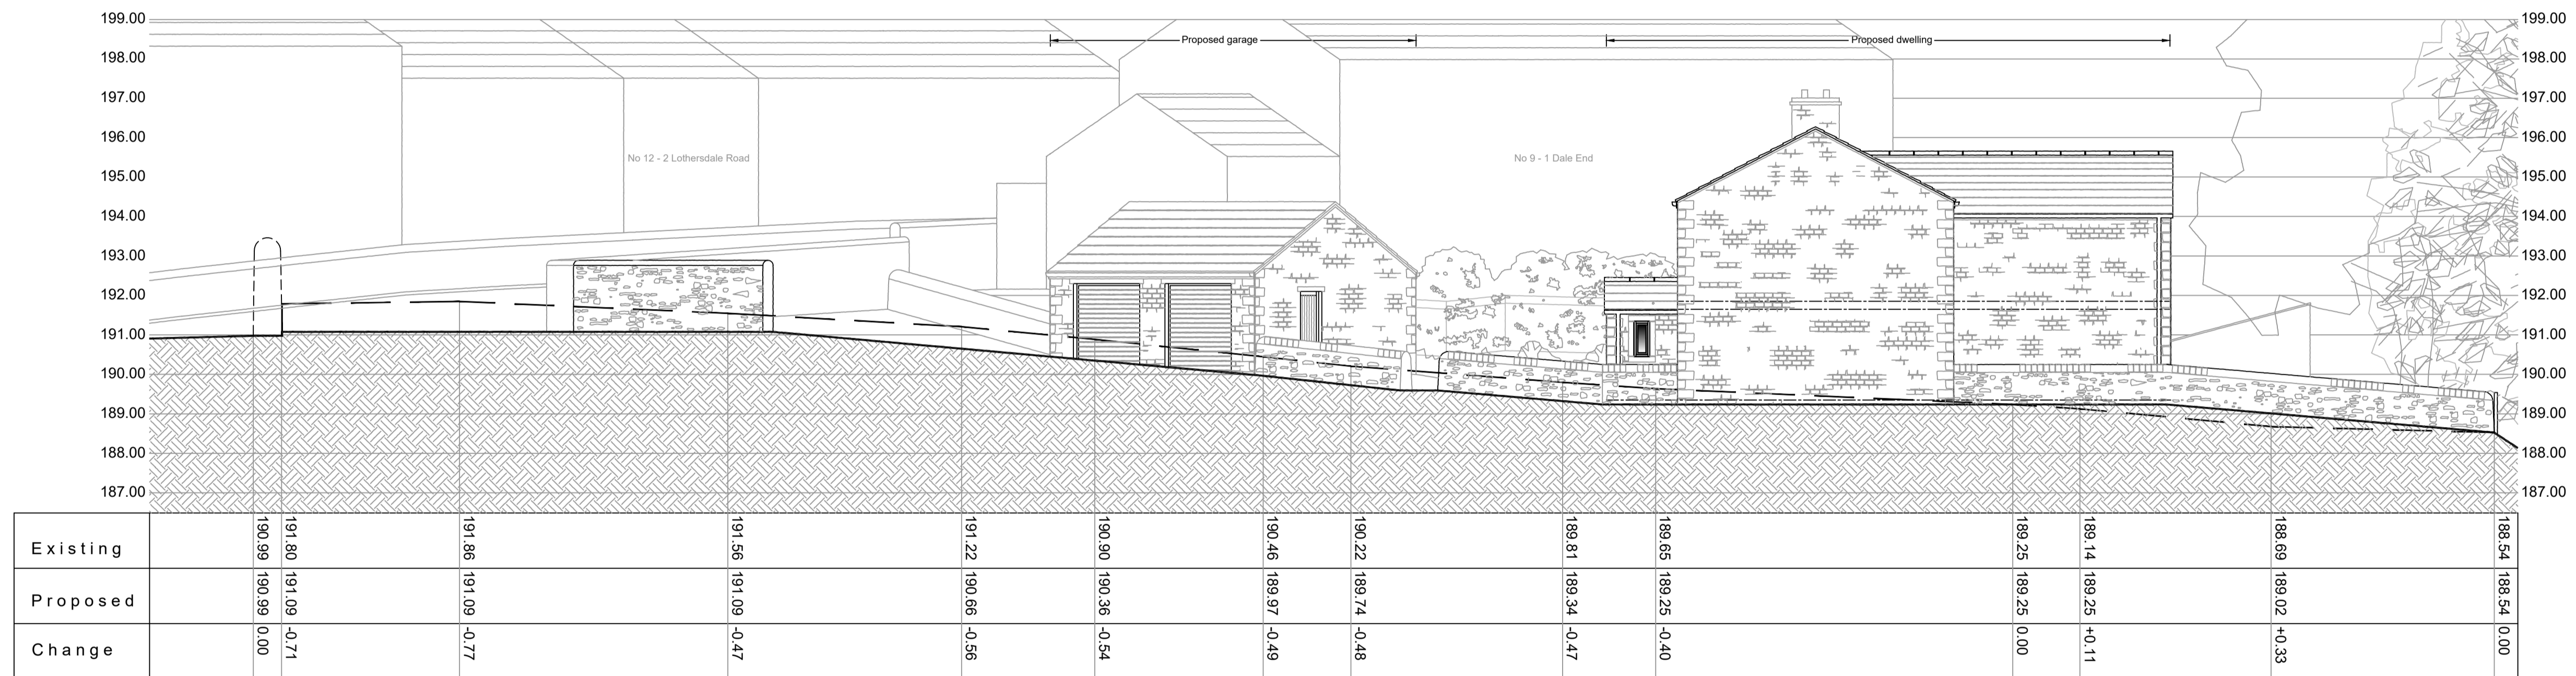

South West Elevation (Section c-c)

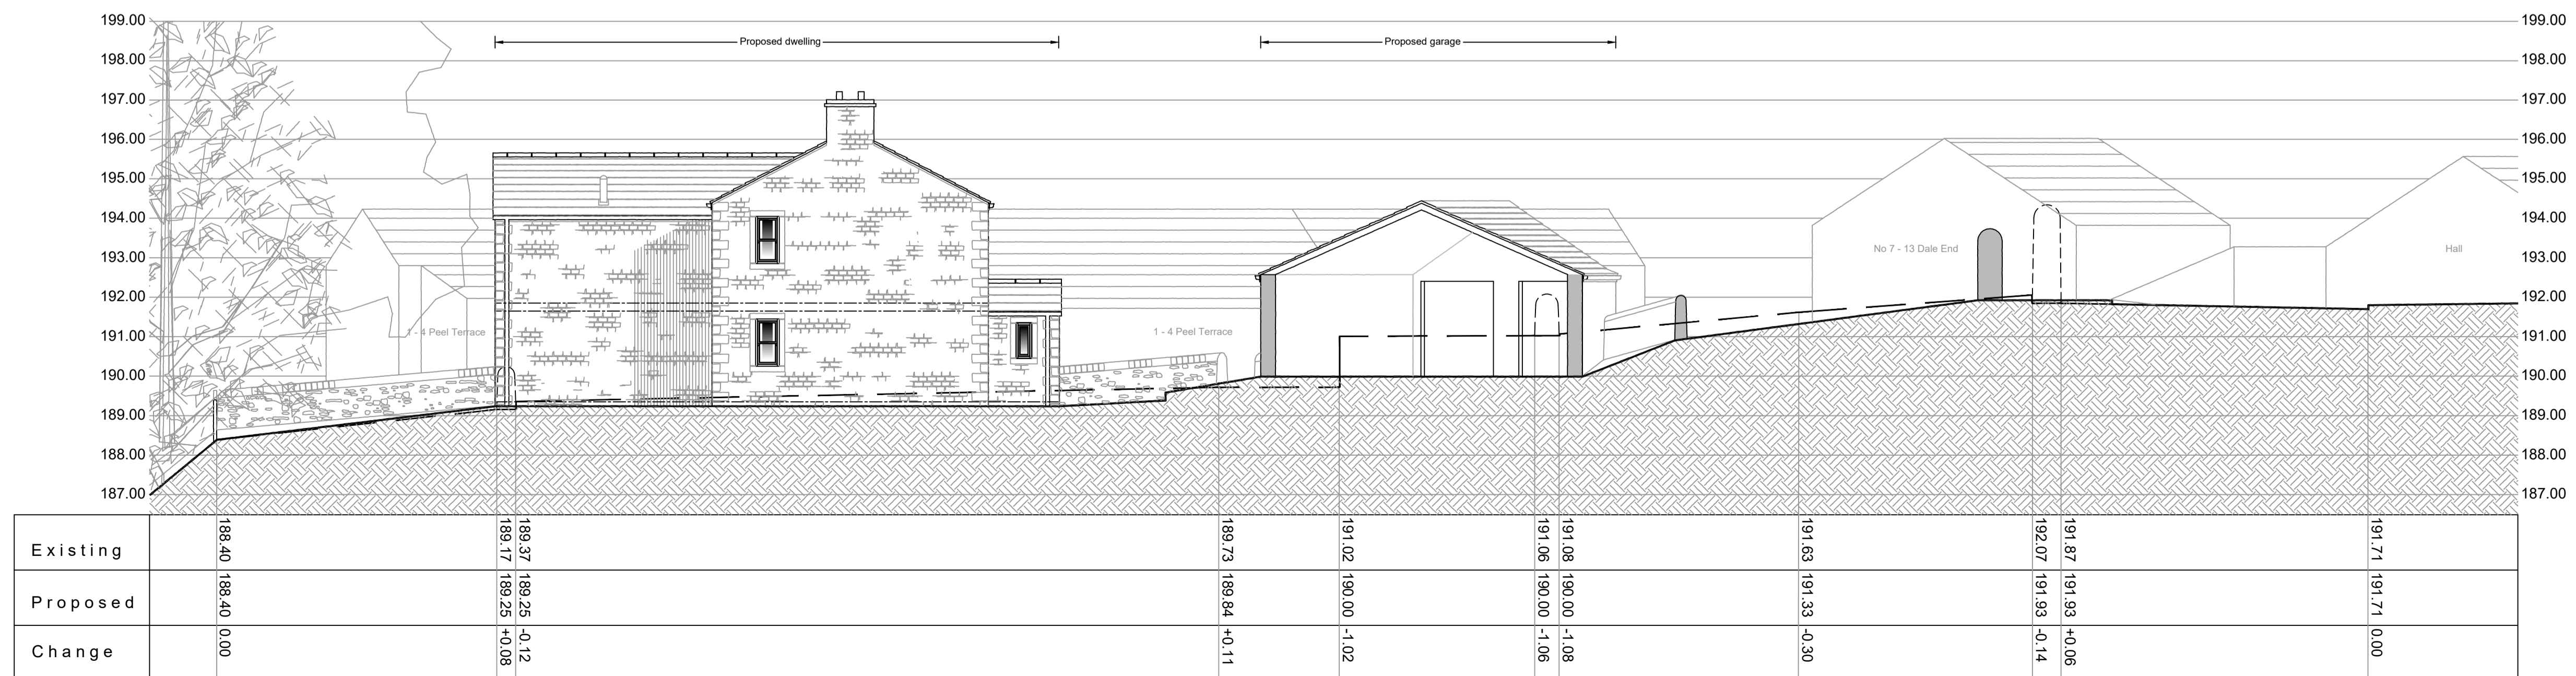

North East Elevation (Section d-d)

DAVID HILL
 Chartered Surveyors • Chartered Town Planners
 Estate Agents
 The New Ship • Mill Bridge
 Skipton • North Yorkshire • BD23 1NJ
 T:01756 795621 F:01756 795622
 @:info@david-hill.co.uk www.david-hill.co.uk

Client Name and Address
 Mr M Pickard
 2 Peel Terrace
 Lothersdale
 Keighley
 BD20 8EP

Project Name and Address
 Sections as Proposed
 Proposed new dwelling
 land of
 Rook Street / Lothersdale Road
 Lothersdale
 Keighley
 BD20 8EP

Scale	A1@1:100	Date	Apr 2022	Drawn by	PLM
Drawing No	P1822/001b				
P1822/001a	Proposed dwelling moved to north west to avoid tree canopy				14/11/2017
P1822/001b	Position as built				19/04/2022
No	Revisions / Issues			Date	