



Ground Floor

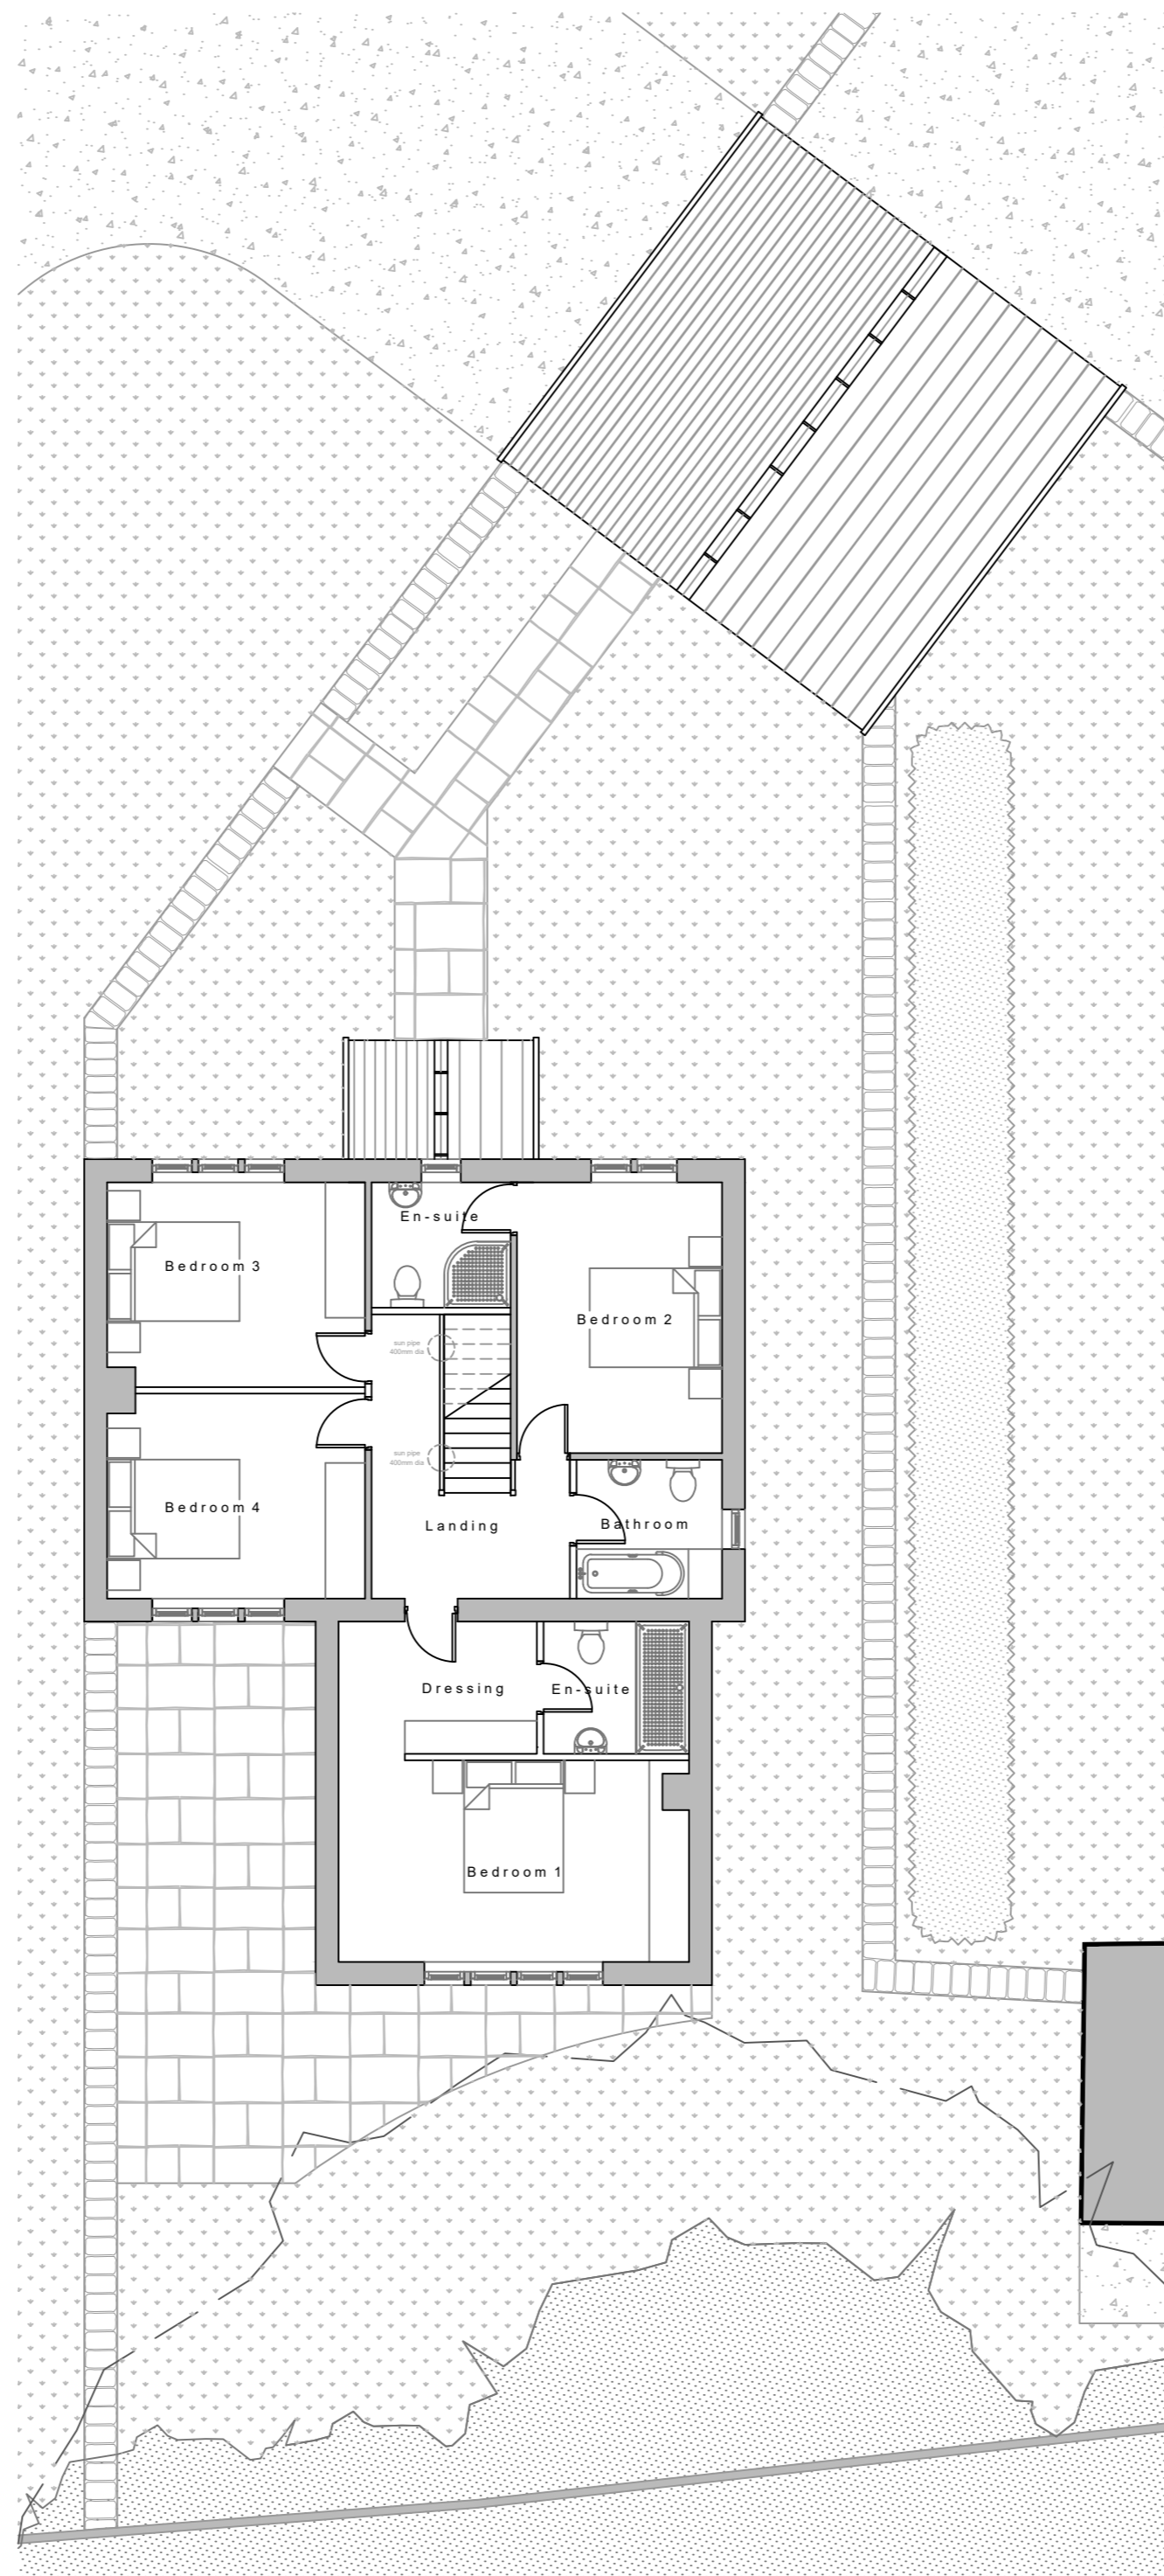

First Floor

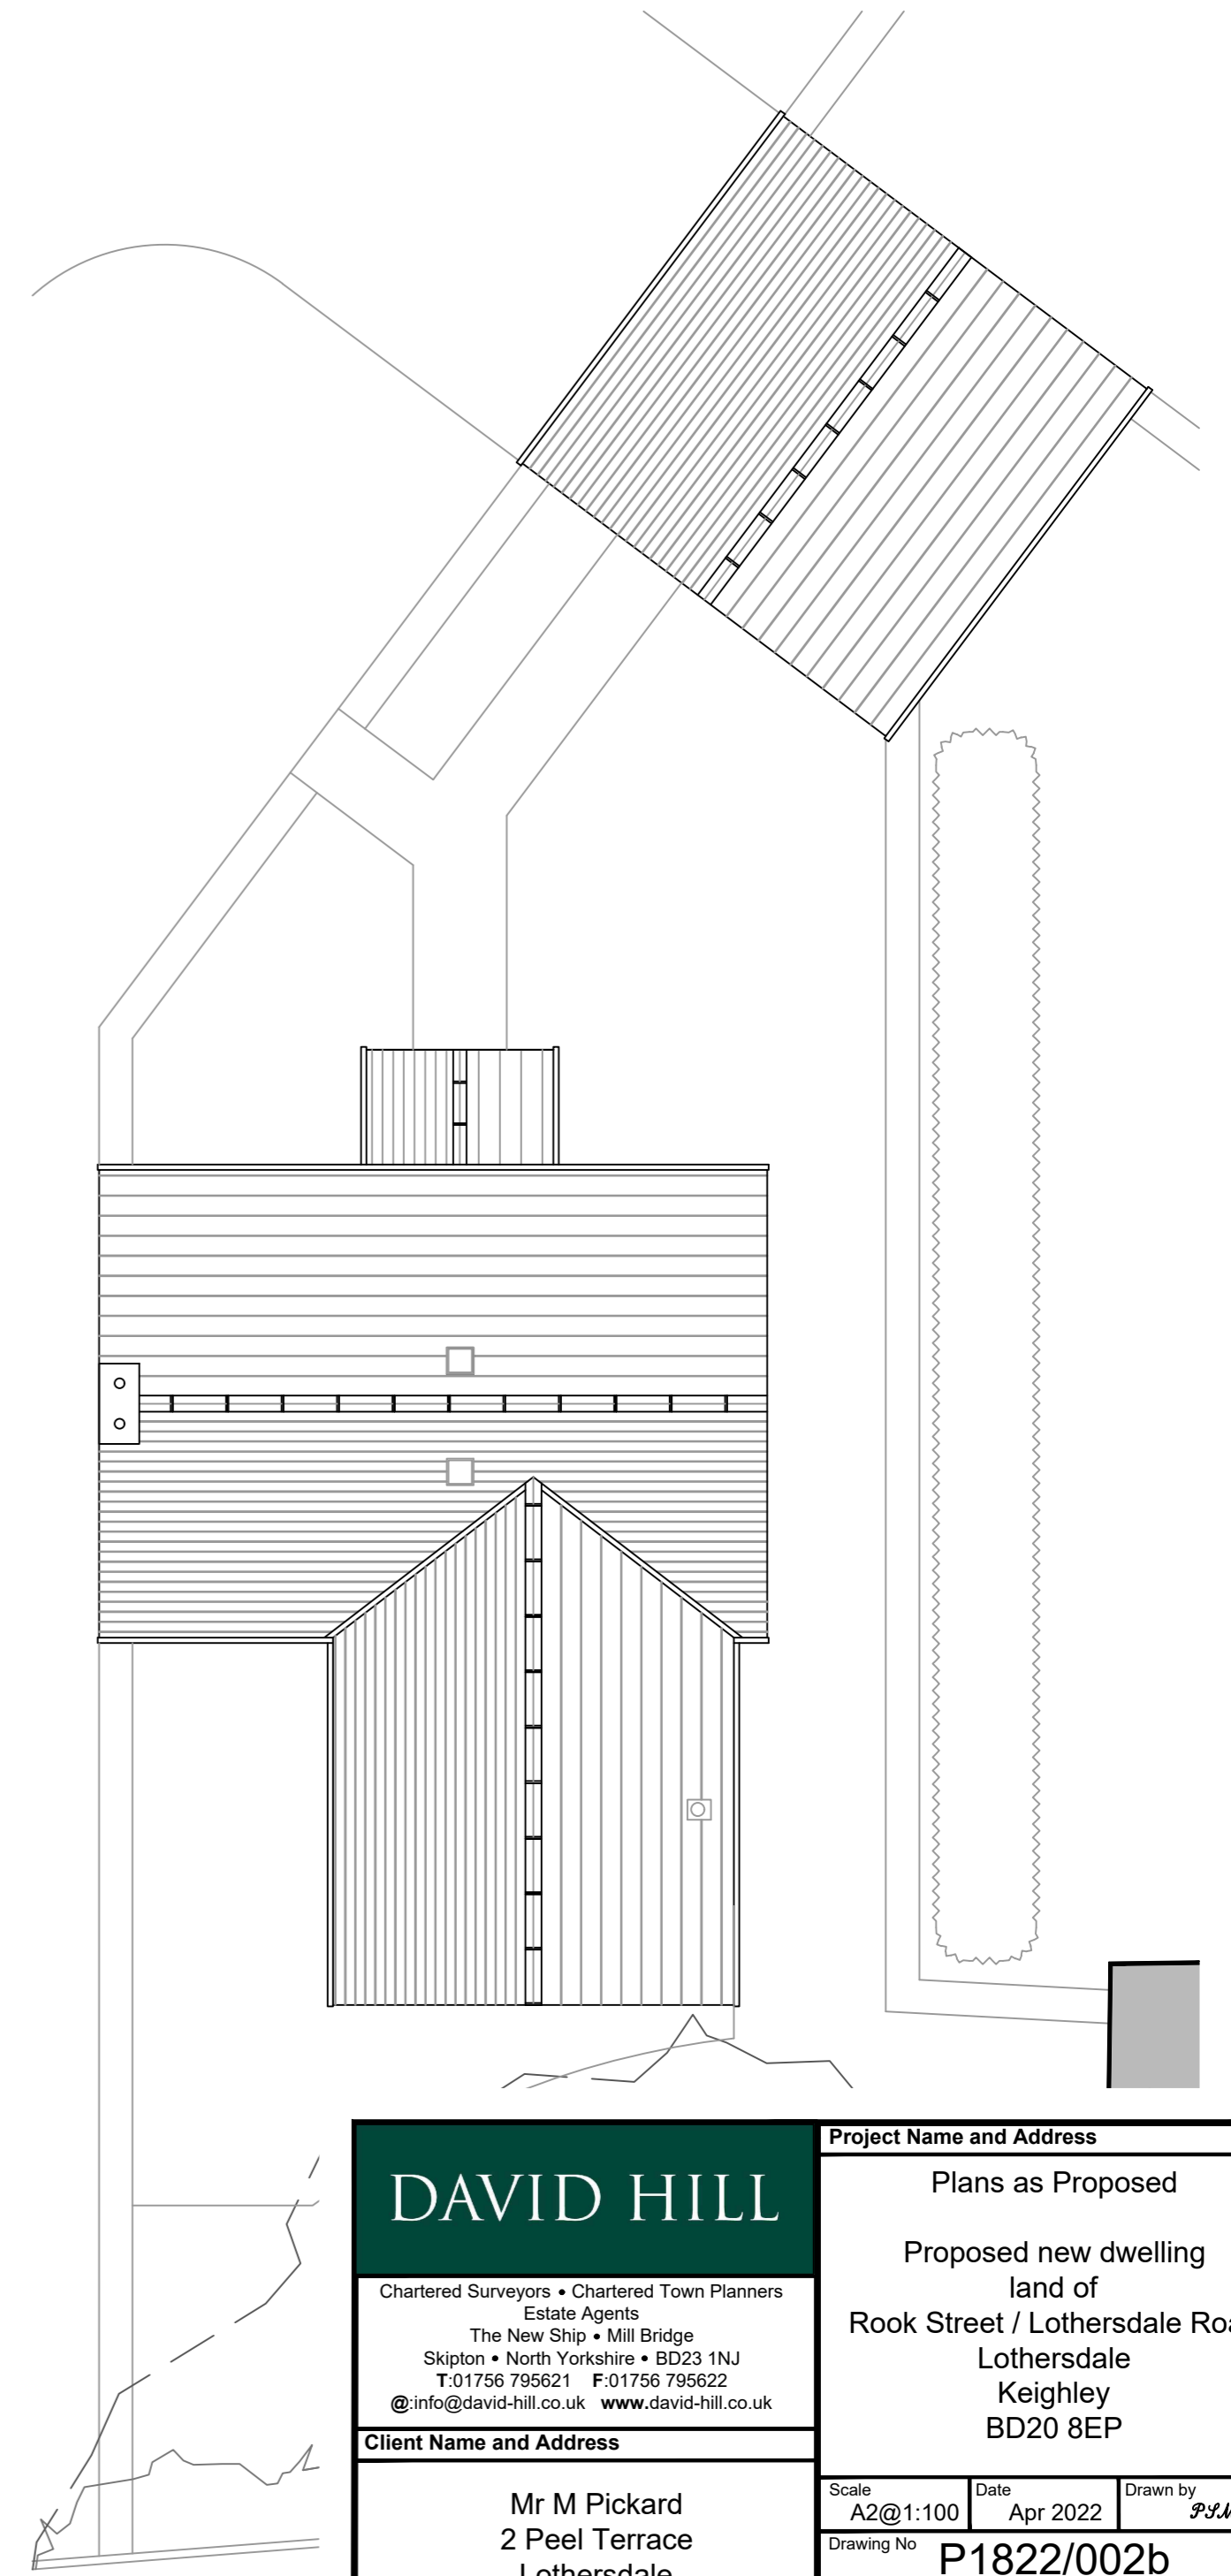

Roof Plan

DAVID HILL Chartered Surveyors • Chartered Town Planners Estate Agents The New Ship • Mill Bridge Skipton • North Yorkshire • BD23 1NJ T:01756 795621 F:01756 795622 @info@david-hill.co.uk www.david-hill.co.uk			Project Name and Address Plans as Proposed Proposed new dwelling land of Rook Street / Lothersdale Road Lothersdale Keighley BD20 8EP		
			Scale A2@1:100	Date Apr 2022	Drawn by P.M.
Client Name and Address Mr M Pickard 2 Peel Terrace Lothersdale Keighley BD20 8EP			Drawing No P1822/002b		
P1822/002a Proposed dwelling moved to north west to avoid tree canopy P1822/002b Position as built			14/11/2017 19/04/2022		
No			Revisions / Issues		Date