


GROUND FLOOR: FLOOR PLAN
SCALE 1:100@A1




EXISTING ROOF PLAN: PLAN VIEW
SCALE 1:100@A1

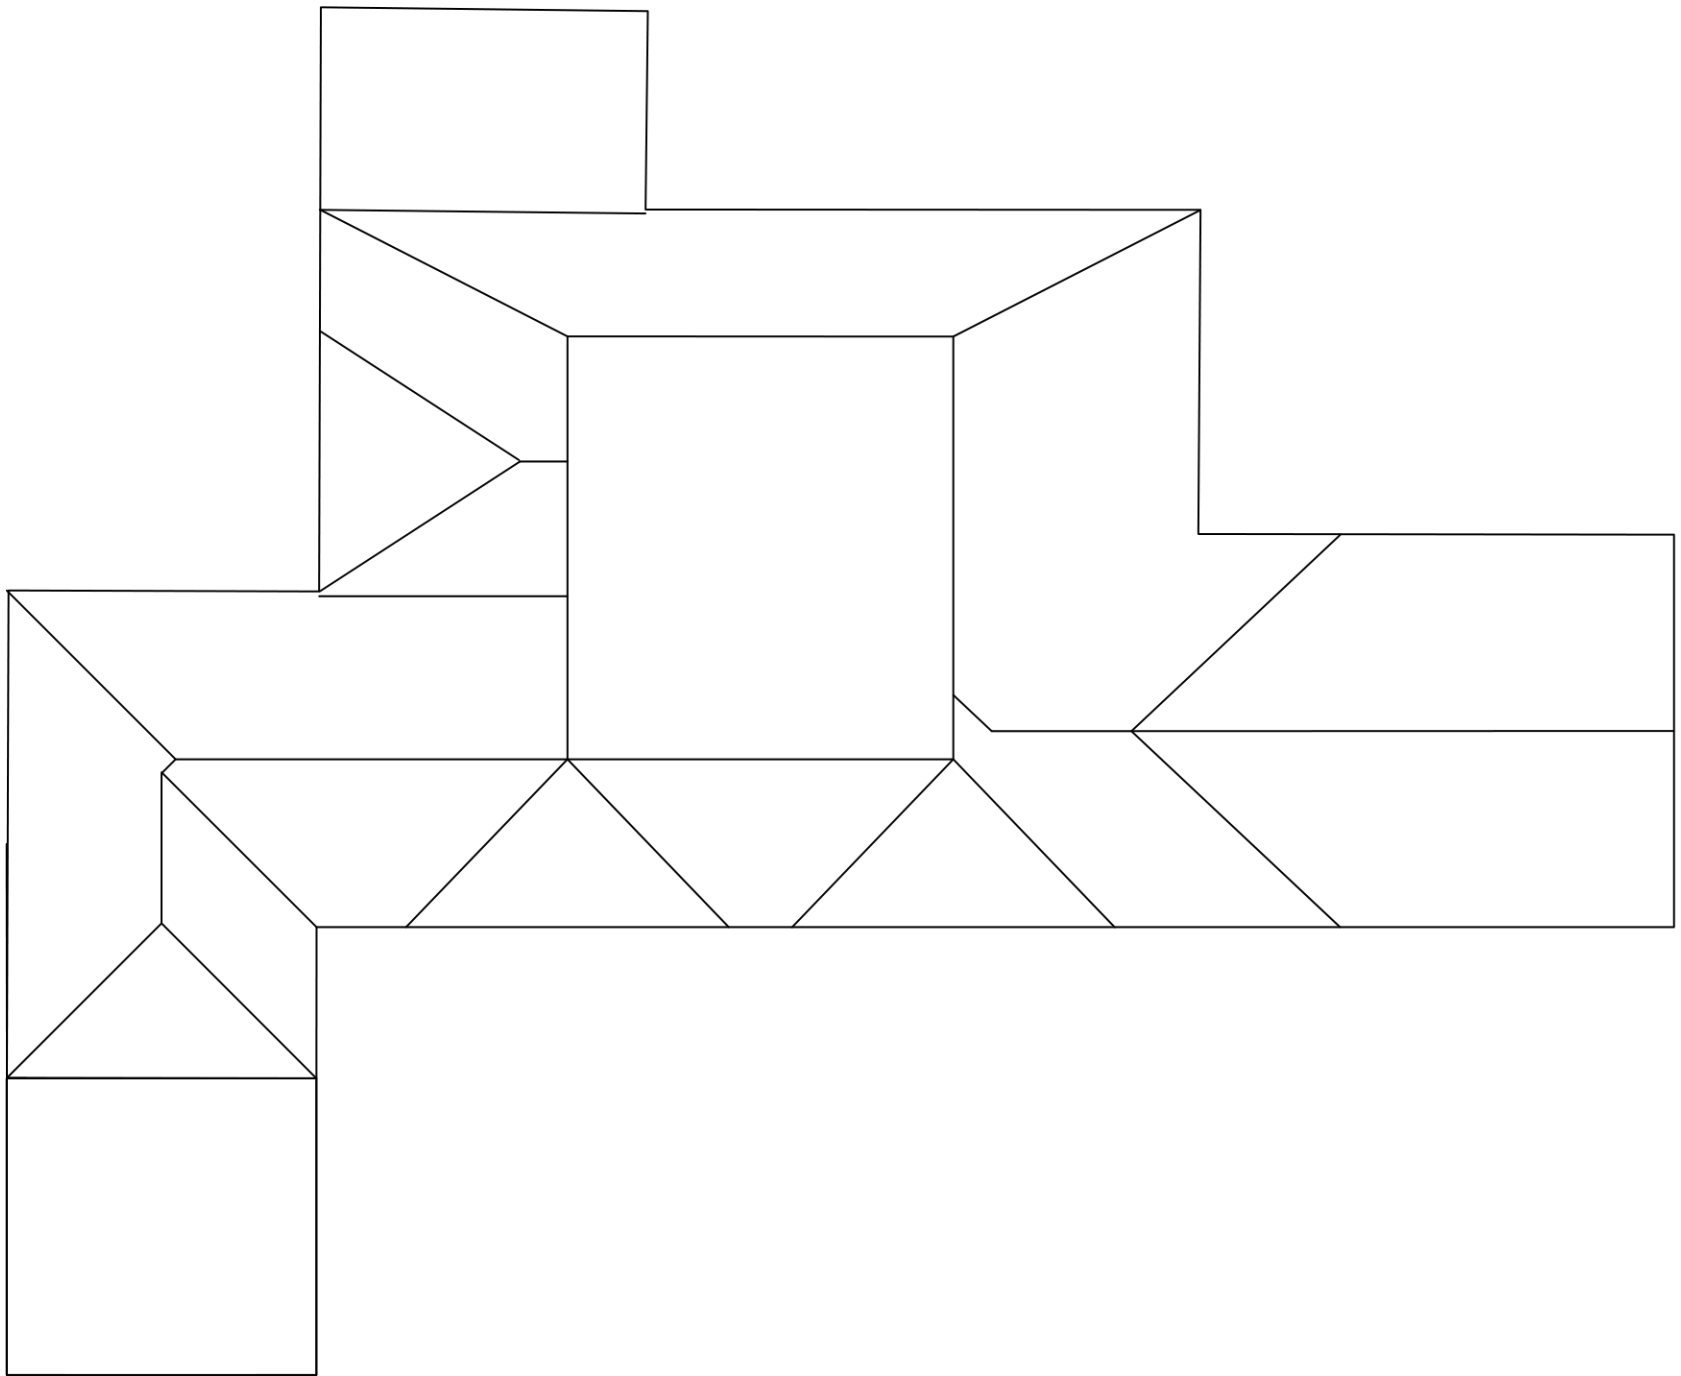


ELEVATION A: FRONT ELEVATION
SCALE 1:100@A1



ELEVATION A1: GARAGE DETAIL
SCALE 1:50@A1

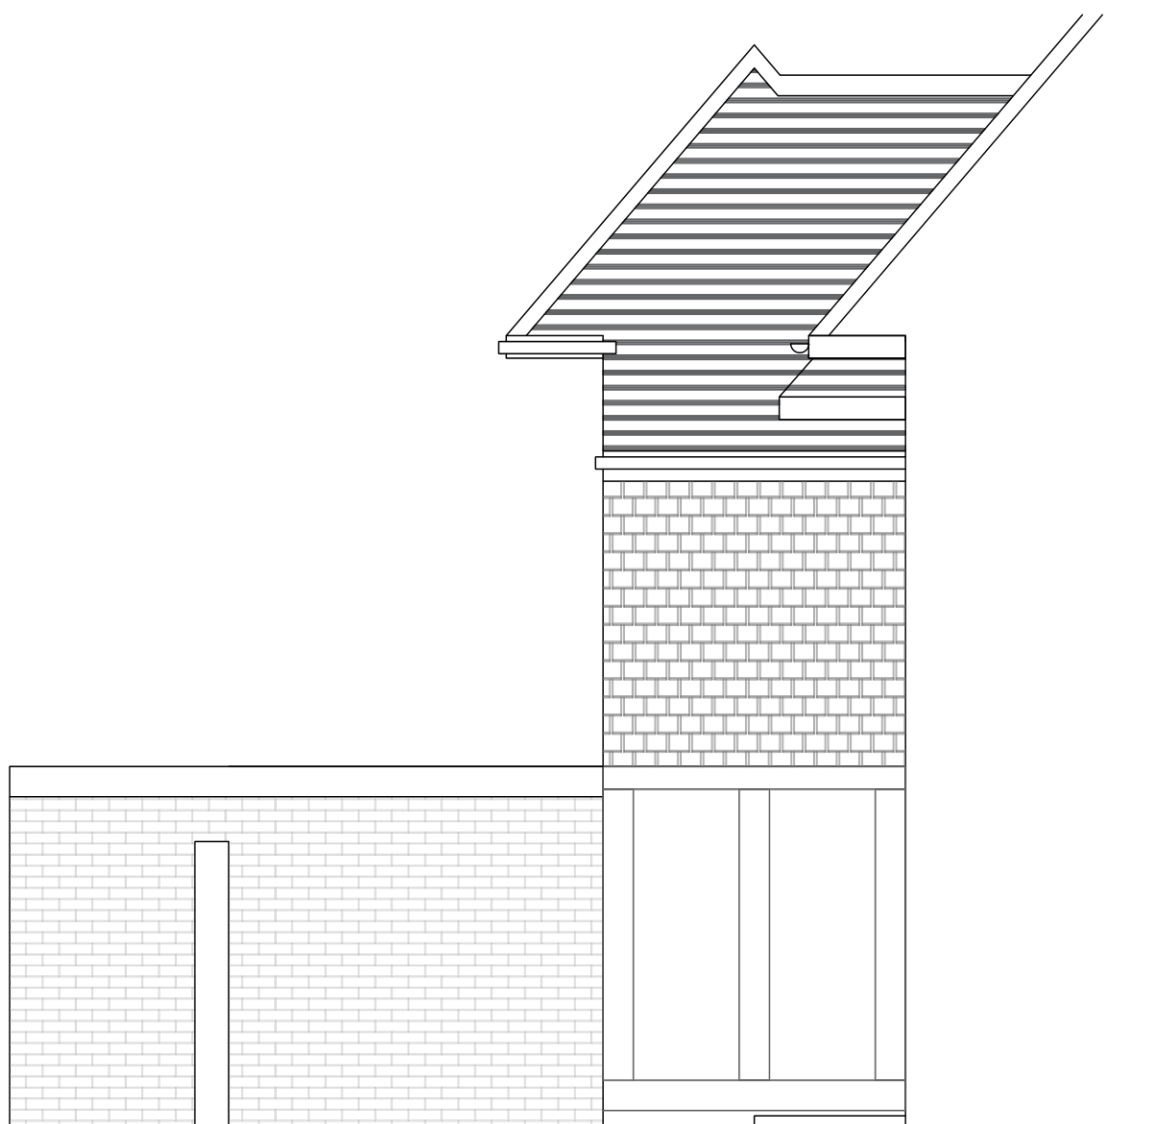


ELEVATION B: GARAGE DETAIL
SCALE 1:50@A1

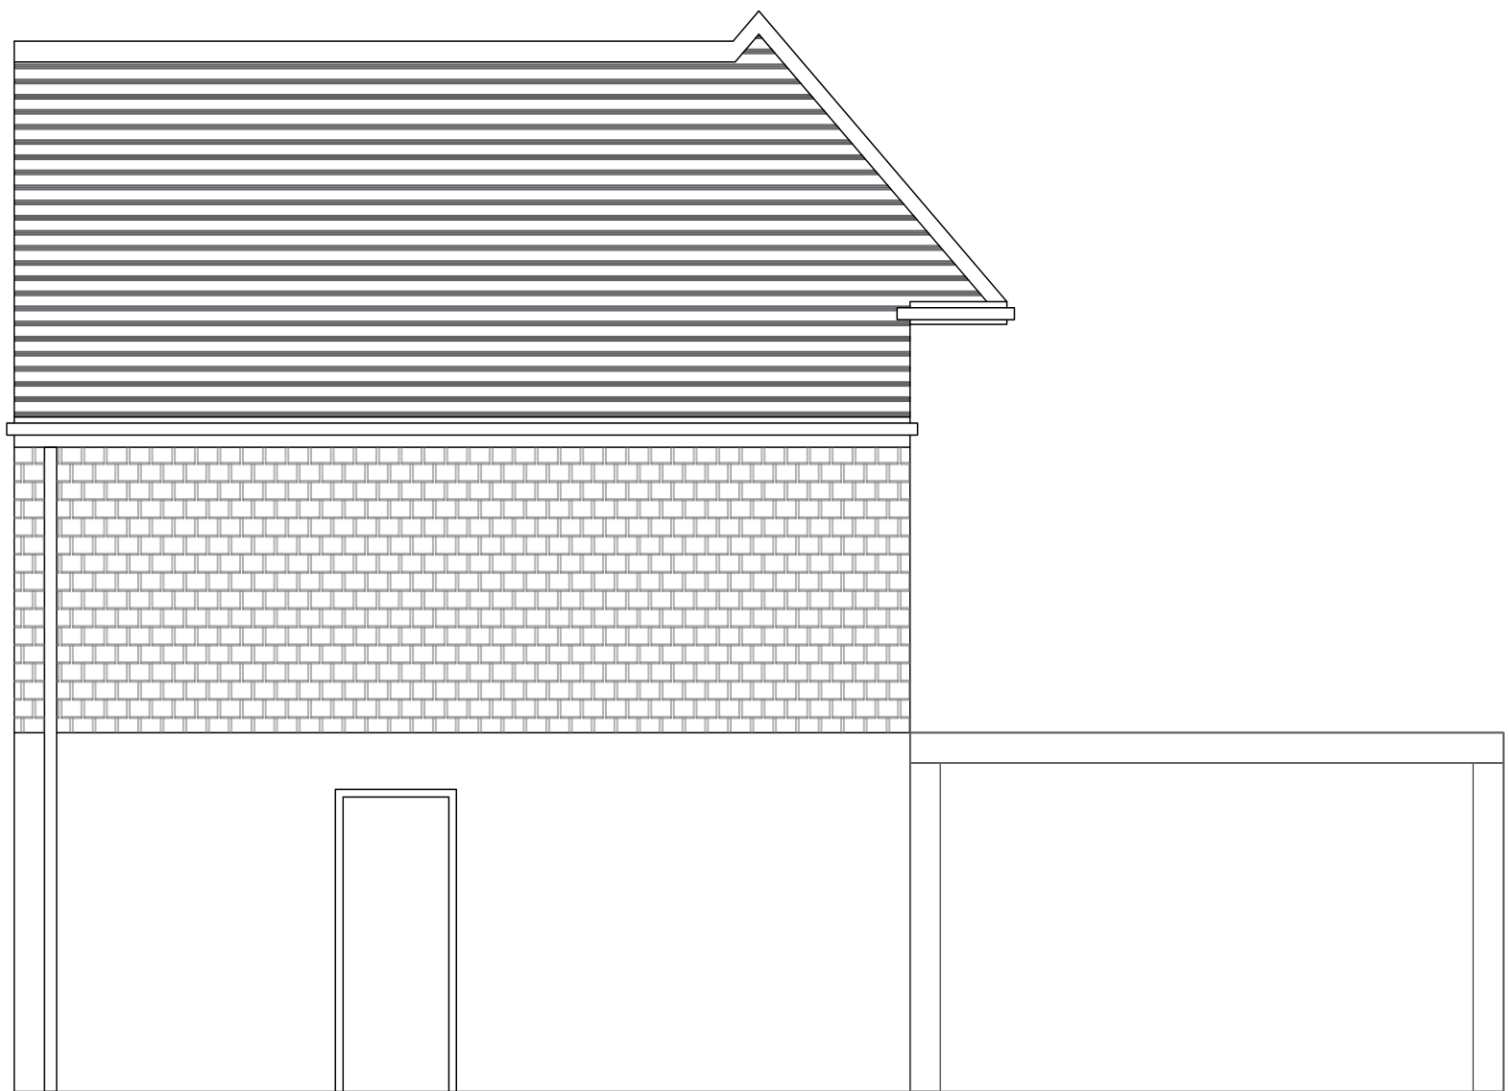

ELEVATION C: GARAGE DETAIL
SCALE 1:50@A1

- GENERAL NOTES:
- ALL WORKS WITHIN THIS DOCUMENT TO BE INSTALLED/CARRIED OUT IN COMPLIANCE WITH THE LATEST BUILDING REGULATIONS AND BRITISH STANDARDS. DISCREPANCIES TO BE REPORTED TO THE DESIGNER PRIOR TO WORK COMMENCING OR MATERIALS ORDERED.
 - DRAWINGS TO BE READ IN CONJUNCTION WITH APPROVED PLANNING DRAWINGS AND APPROVED STRUCTURAL CALCULATIONS. NO WORK IS TO COMMENCE ON SITE UNTIL ALL PLANNING CONDITIONS ARE APPROVED.
 - CONTRACTOR TO CONFIRM ALL ON SITE DIMENSIONS PRIOR TO MANUFACTURE /INSTALLATION AND MUST REPORT ANY DISCREPANCIES BACK TO DESIGNER.
 - THIS DRAWING MUST NOT BE SCALED, WORK TO DIMENSIONS ONLY.
 - ANY CONSTRUCTION/MANUFACTURE DRAWINGS IN THIS DOCUMENT ARE INDICATIVE. IT IS THE RESPONSIBILITY OF THE CONTRACTOR TO ENSURE THEY ARE FIT FOR PURPOSE, AND MAKE AMENDMENTS WHERE NECESSARY.
 - THE CONTENTS OF THIS DOCUMENT ARE THE PROPERTY OF BEVERLEY ANN DESIGN LTD AND MUST NOT BE COPIED OR DISTRIBUTED IN WHOLE OR PART WITHOUT FORMAL CONSENT.

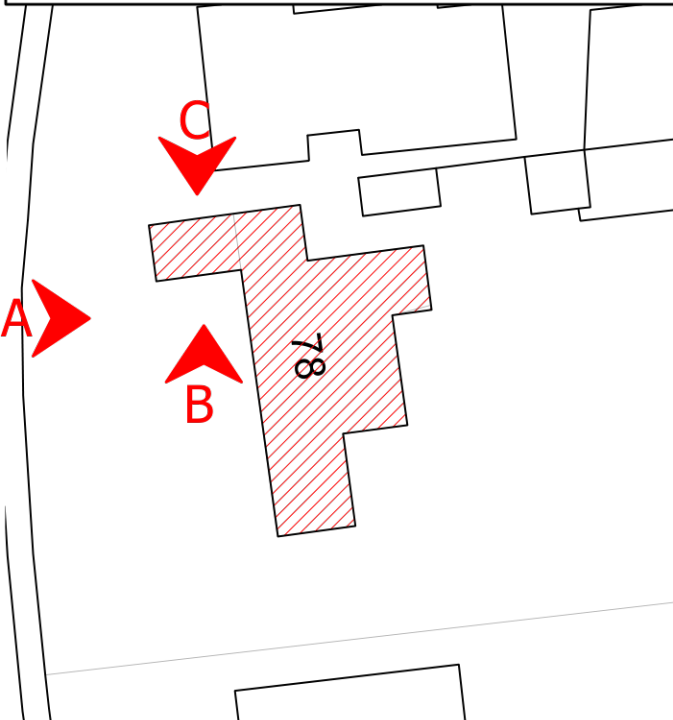

SITE PLAN
SCALE 1:500@A1

REV	DATE	DESCRIPTION
00	16.04.2022	EXISTING DETAILS PRODUCED
PROJECT: GARAGE ROOF		
PROJECT NUMBER: 9000_0010		
PROJECT ADDRESS: 78 THIRD AVENUE FRINTON ON SEA ESSEX CO13 9EE		
DRAWING NAME: EXISTING INFORMATION		
PURPOSE: PLANNING APPLICATION		
DRAWING NUMBER: 0010-A-100		REVISION: 00
SCALE: AS SHOWN		DRAWING STATUS: AS BUILT
DATE: 16.04.2022	DRAWN: B.Ann	ISSUED: B.Ann
 BEVERLEY ANN DESIGN LTD PLANNING & ARCHITECTURAL DESIGN • RESIDENTIAL • COMMERCIAL • RETAIL • MEASURED SURVEYS BEVERLEY ANN DESIGN LTD 20-22 WENLOCK ROAD, LONDON, N1 7GU		