


LEGIONNESE HOUSE BOUNDARY WITH WILLOW HALL

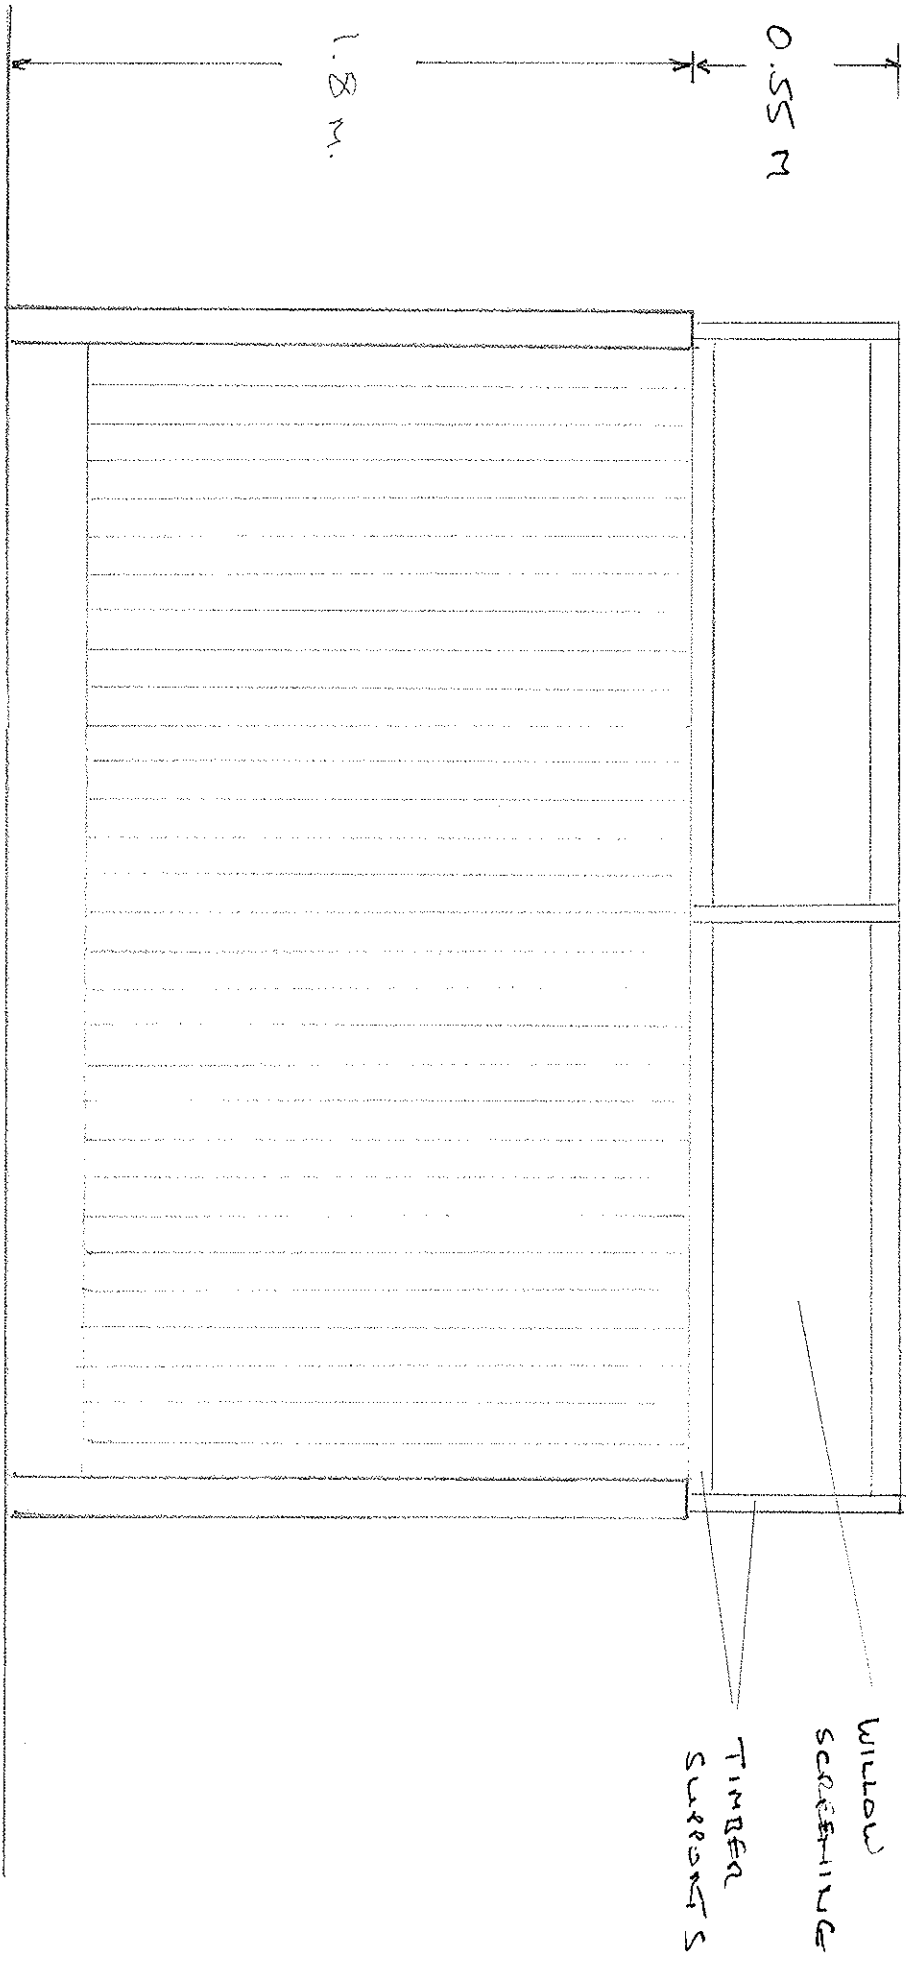


PROPOSED WILLOW SCREEN EXTENSION TO

EXISTING FENCE

AS BUILT

SCALE 1:20

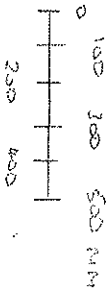

13.5.2022