

MATERIALS:

Roof:
- Harlow Slate roofing


Walls:
- Anglian Red Rustic facing bricks
- Forticrete polished concrete blockwork

Windows:
- white upvc casements


Doors:
- stained timber pedestrian and stable effect doors

Rainwater goods
- brown upvc gutters and downpipes


Dormer cheeks:
- lead

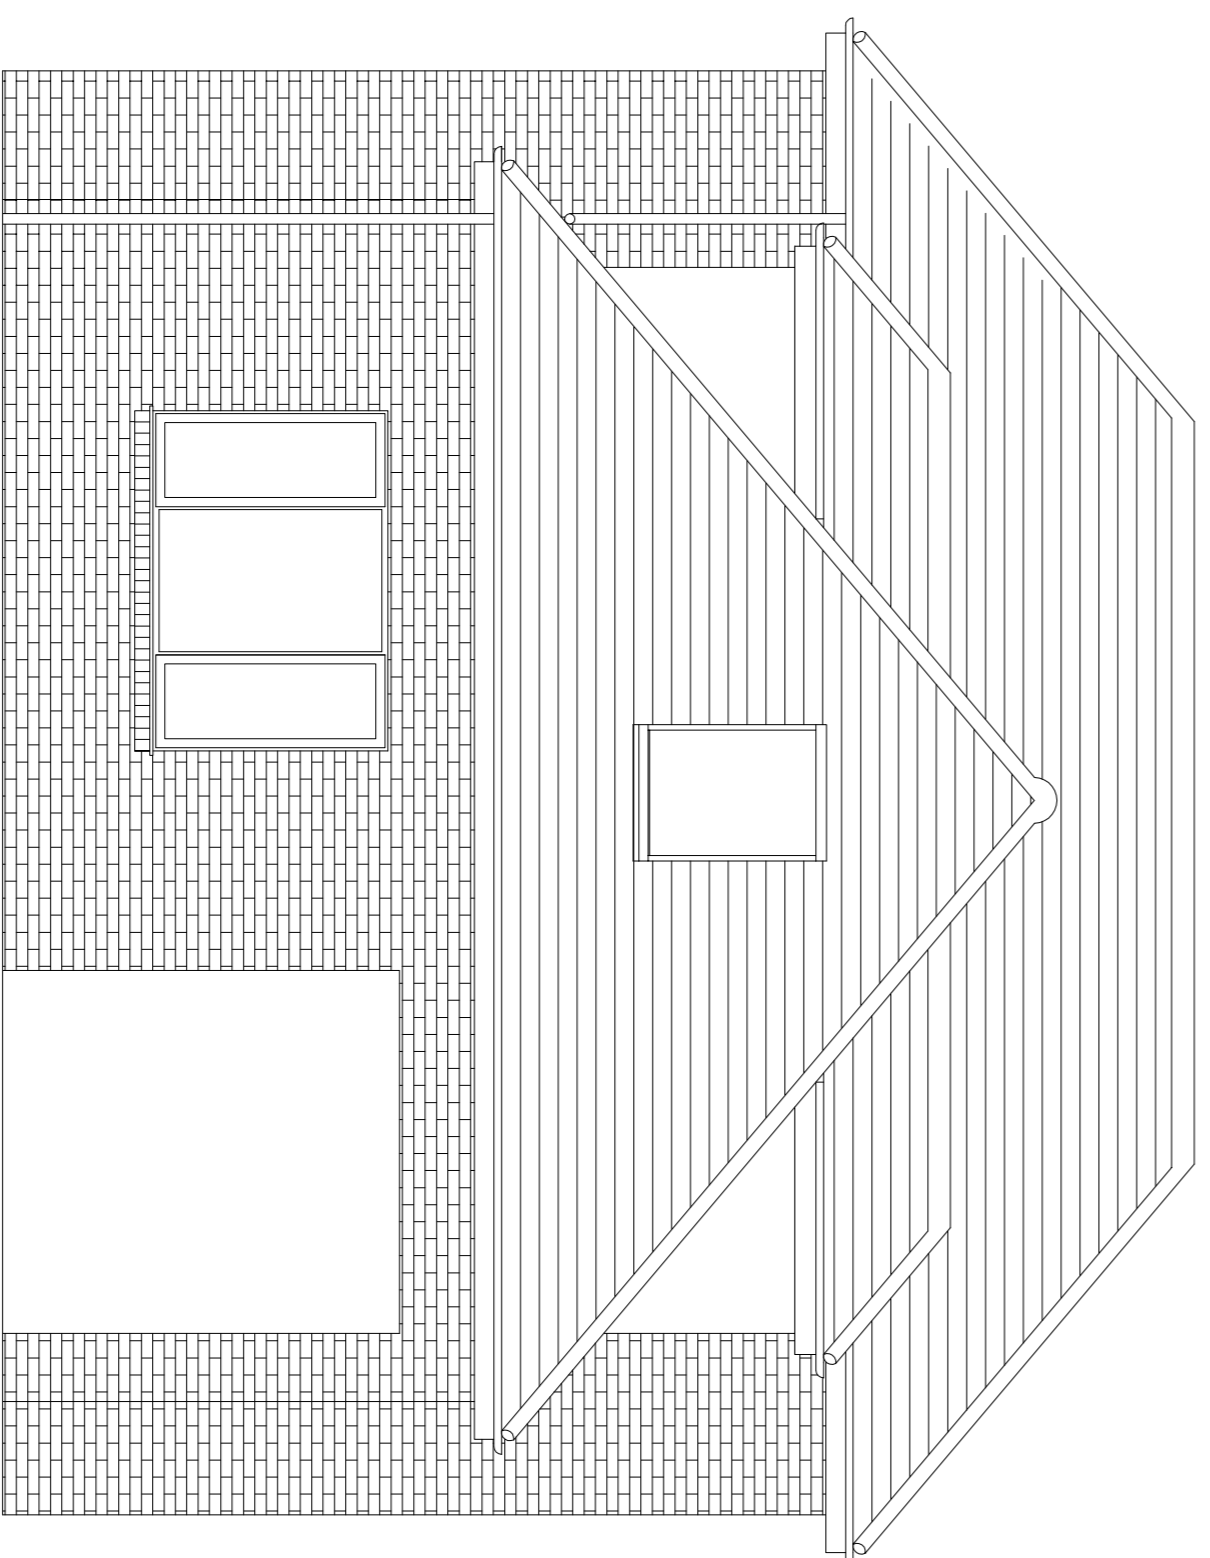

AS-BUILT END (SOUTH ELEVATION)

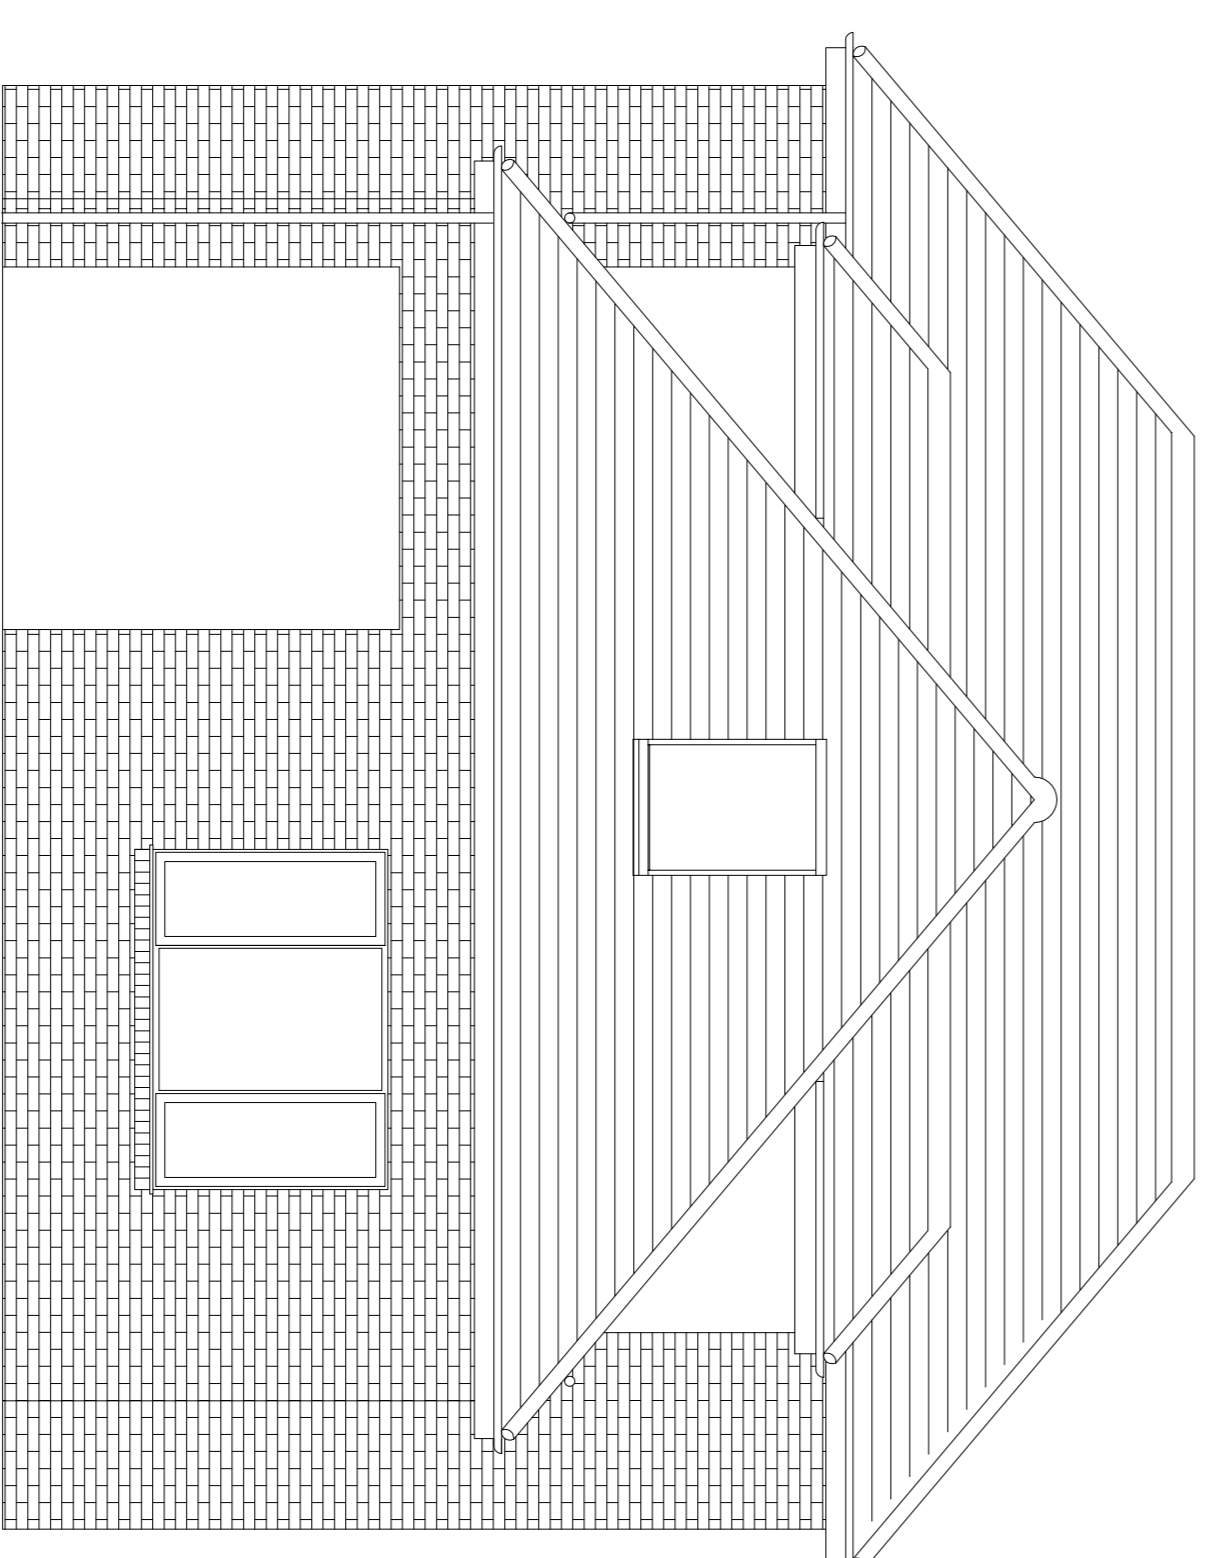

AS BUILT (NORTH ELEVATION)

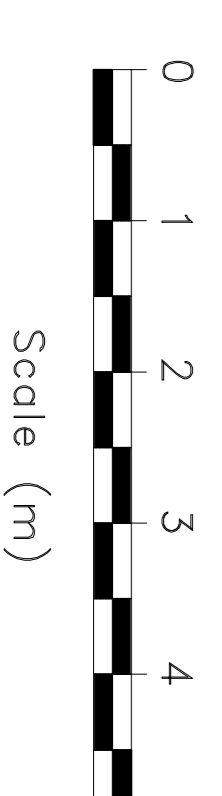

Scale (m)

Rev:

PROJECT	79 ECTON LANE, SYWELL, NN6 4Z8
CLIENT	DAVID BLETSO-BROWN
DE CONTRACTS	Kenada, Corner Street, Corner, Norfolk, NG27 9UA T: 01930 840000 E: info@kenada.co.uk
DRAWING TITLE	ELEVATIONS (2 OF 2)

CHECKED	SCALE	DATE
DAF	1:50 (A1)	OCT 20
JOB NO.	DRAWING NO.	REVISION
0428	03	