
Notes

This document and its design content is copyright ©. It shall be read in conjunction with all other associal project information including models, specifications, schedules and related consultants documents. Do n scale from documents. All dimensions to be checked on site. Immediately report any discrepancies, erro or omissions on this document to the Oriolinator. If in doubl ASK.

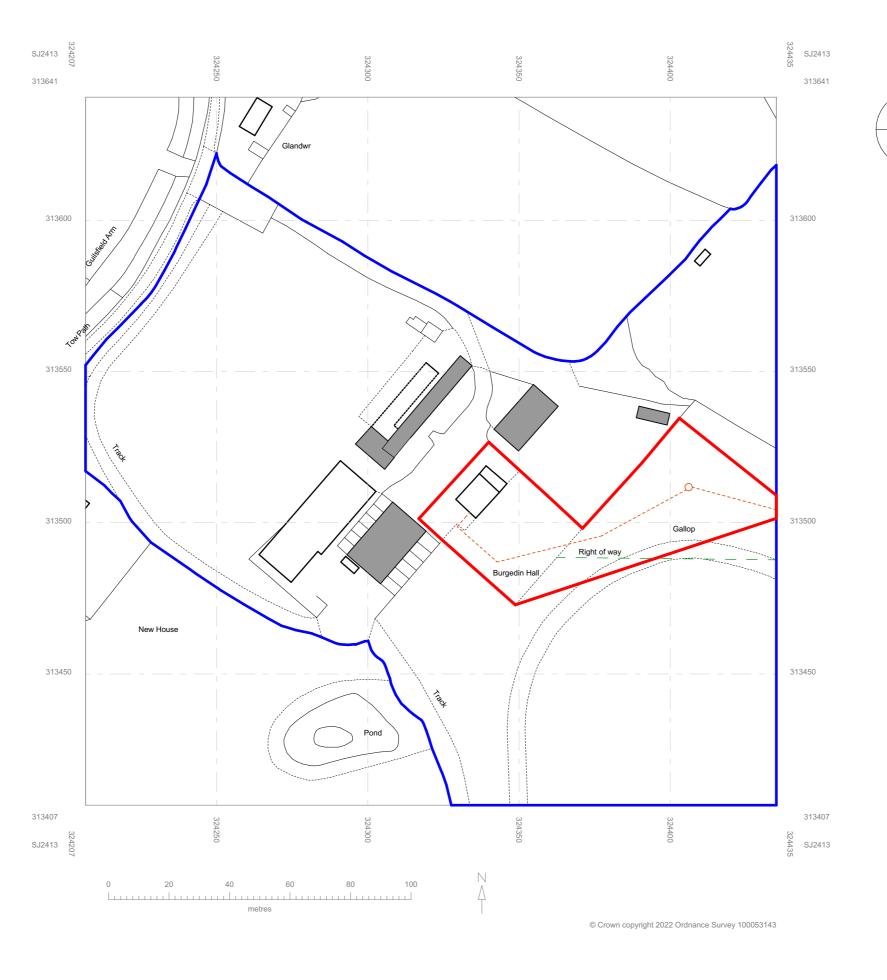

Α	10.06.22	Red line boundary revised along with additional of existing public			
		of way following comments from Powys planning team			

							or way following continents from Fowys planning team
Purpose of Issue	status Scales @ A3	Project No.	Originator	Project	Client	Layout Title	Drawing Number
PLANNING	1:1250	BURG01	SHINGLER GROUP	Burgedin Hall Pool Quay Welshpool	Mr & Mrs Lewis	Location Plan	project originator volume level type role number rev  BUR - AT <a> BURG01 PL-001A A  G01</a>