





DATUM_165.00m_A.O.D.
SUNNYSIDE
FRONT/SOUTH-EAST ELEVATION




DATUM_165.00m_A.O.D.
SUNNYSIDE
SIDE/NORTH-EAST ELEVATION

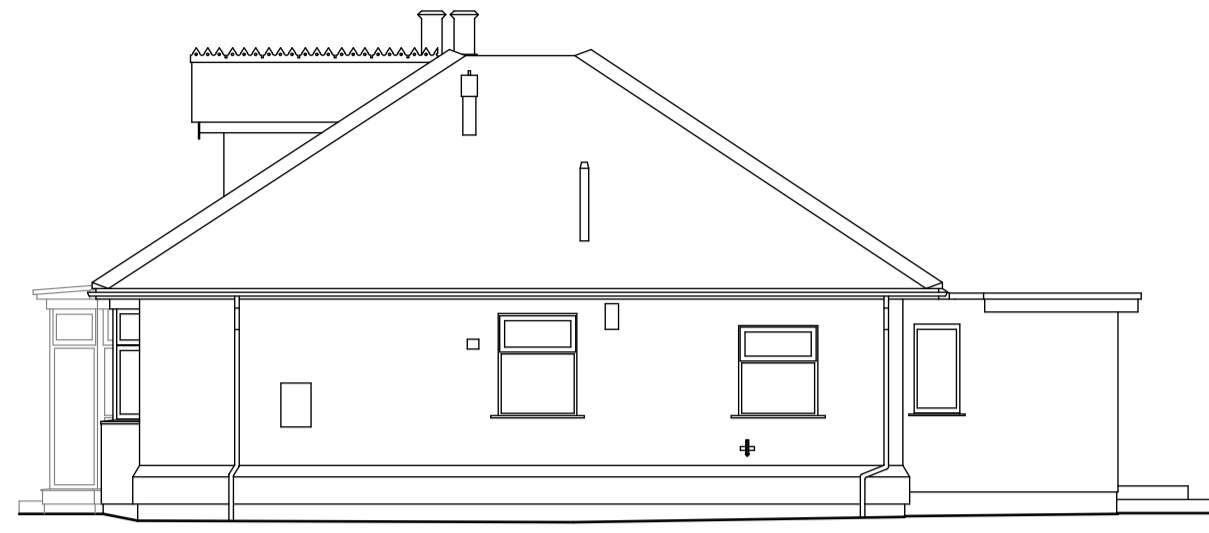


DATUM_165.00m_A.O.D.
SUNNYSIDE
REAR/NORTH-WEST ELEVATION

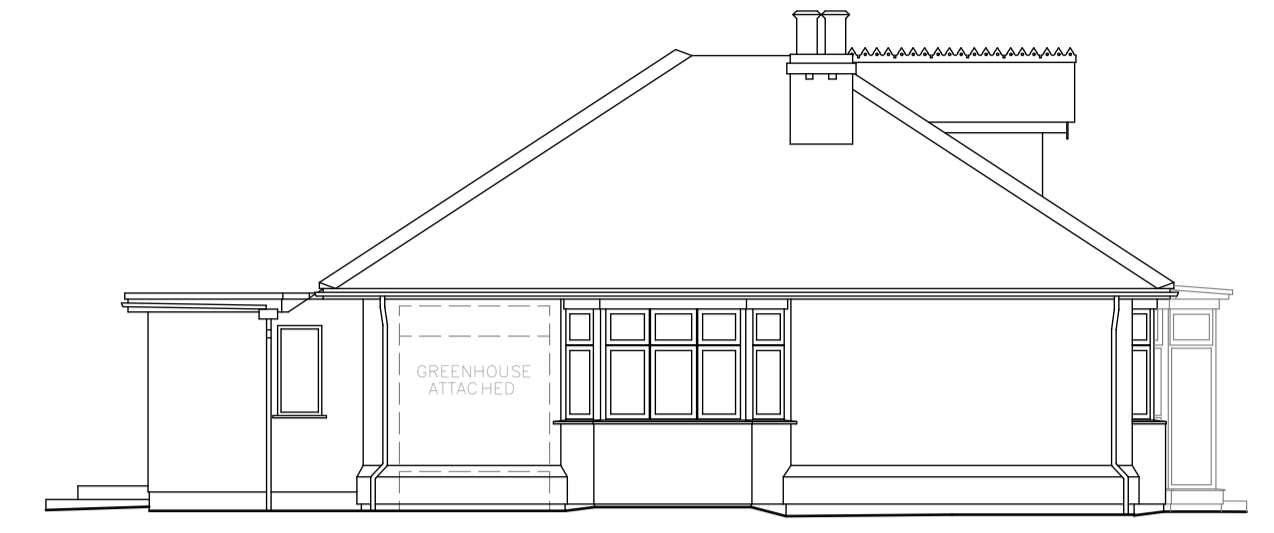

DATUM_165.00m_A.O.D.
SUNNYSIDE
SIDE/SOUTH-WEST ELEVATION

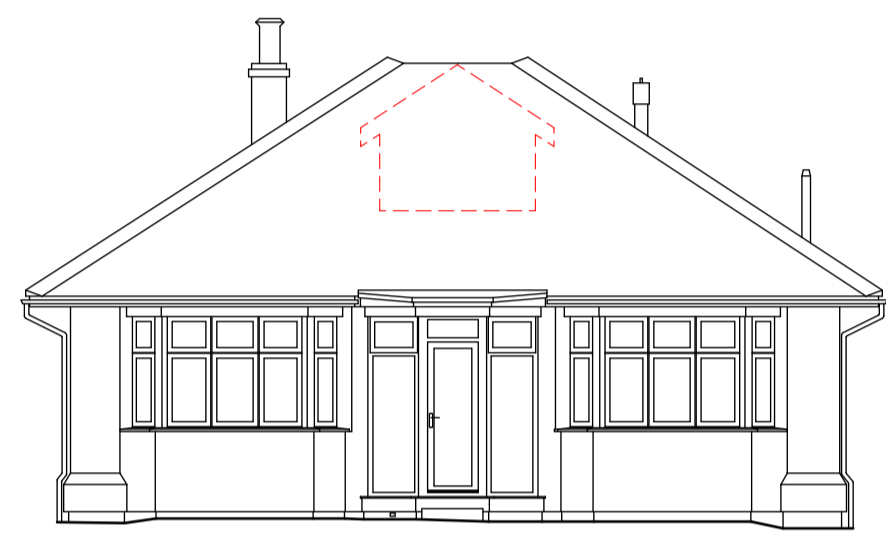


DATUM_165.00m_A.O.D.
SUNNYSIDE
FRONT/SOUTH-EAST ELEVATION

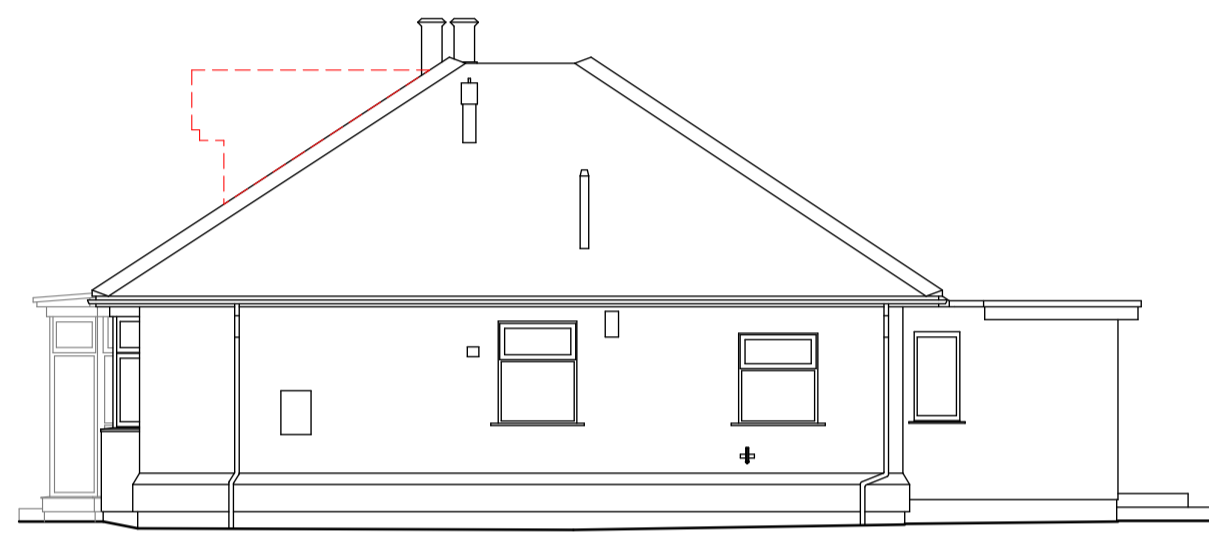

DATUM_165.00m_A.O.D.
SUNNYSIDE
SIDE/NORTH-EAST ELEVATION



DATUM_165.00m_A.O.D.
SUNNYSIDE
REAR/NORTH-WEST ELEVATION

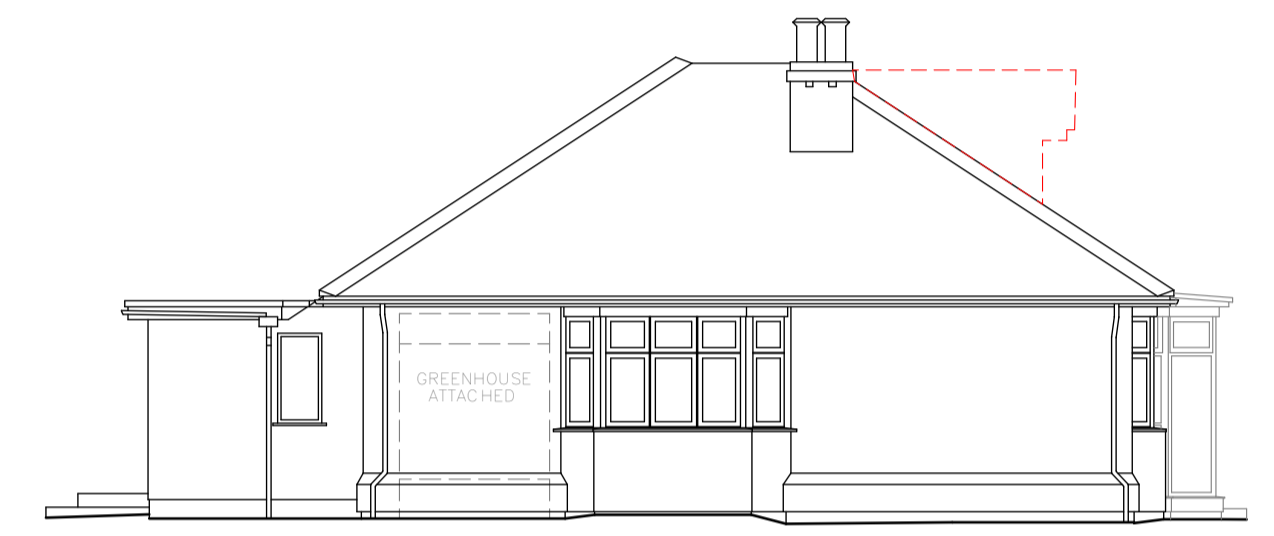


DATUM_165.00m_A.O.D.
SUNNYSIDE
SIDE/SOUTH-WEST ELEVATION


Proposed elevation with existing dormer window removed




DATUM_165.00m_A.O.D.
GARAGE
FRONT/SOUTH-EAST ELEVATION

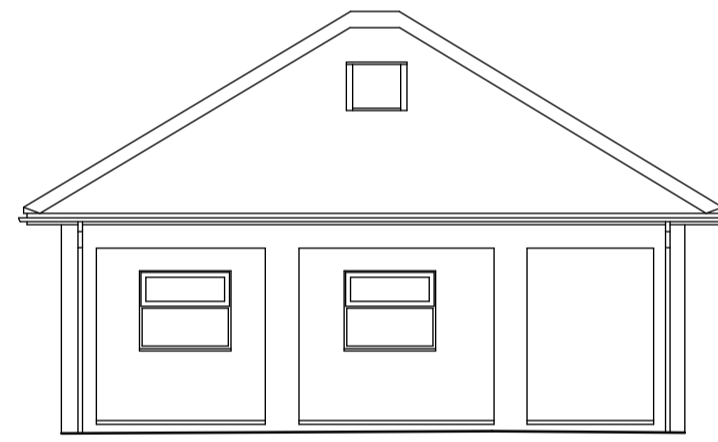


DATUM_165.00m_A.O.D.
GARAGE
SIDE/NORTH-EAST ELEVATION

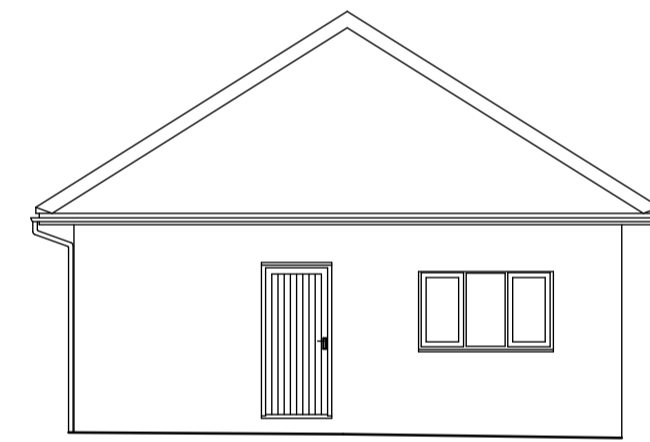


DATUM_165.00m_A.O.D.
GARAGE
REAR/NORTH-WEST ELEVATION

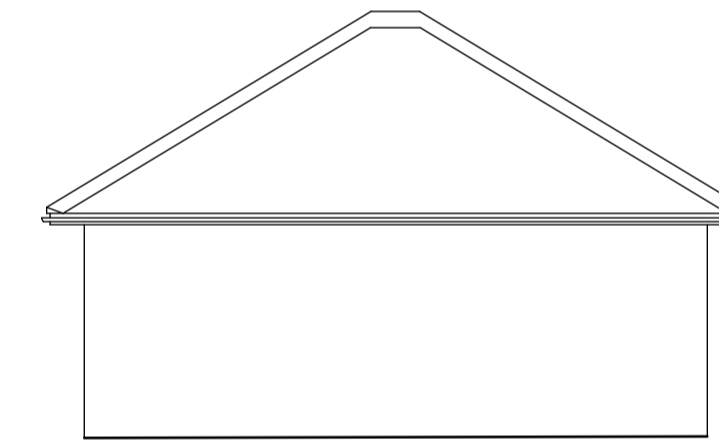


DATUM_165.00m_A.O.D.
GARAGE
SIDE/SOUTH-WEST ELEVATION

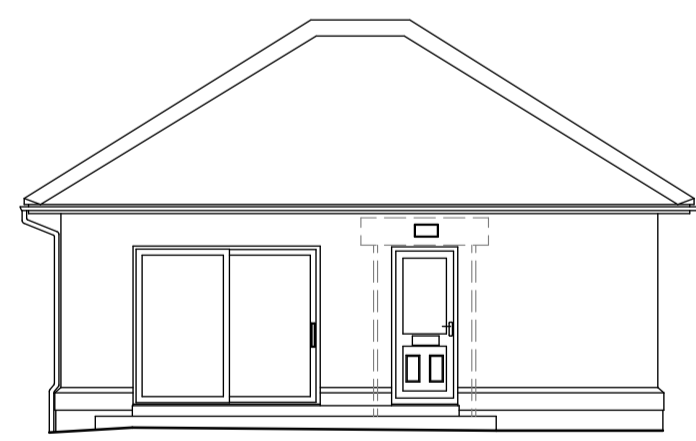


DATUM_165.00m_A.O.D.
ANNEXE
FRONT/SOUTH-WEST ELEVATION

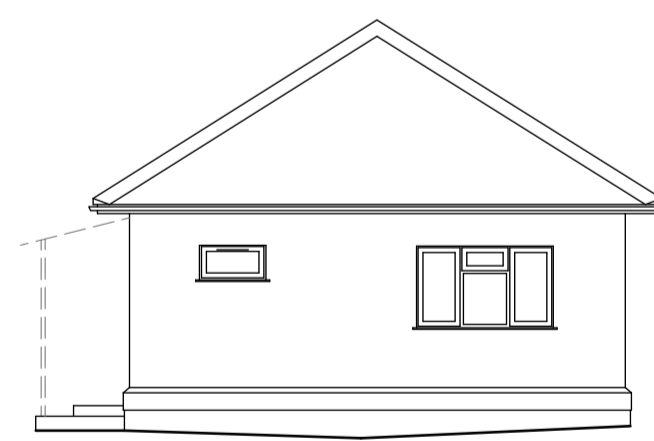


DATUM_165.00m_A.O.D.
ANNEXE
SIDE/SOUTH-EAST ELEVATION

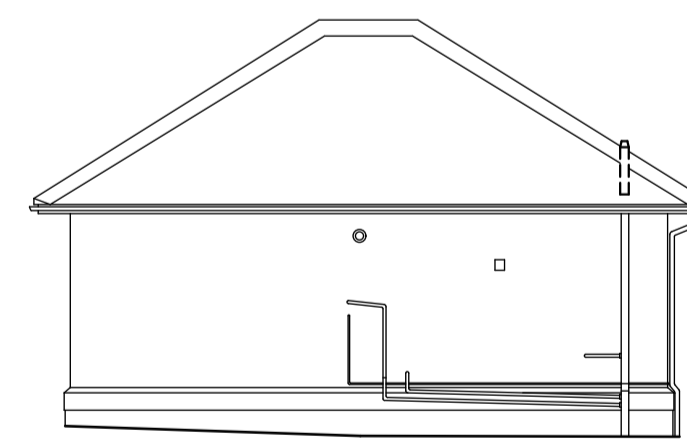

DATUM_165.00m_A.O.D.
ANNEXE
REAR/NORTH-EAST ELEVATION

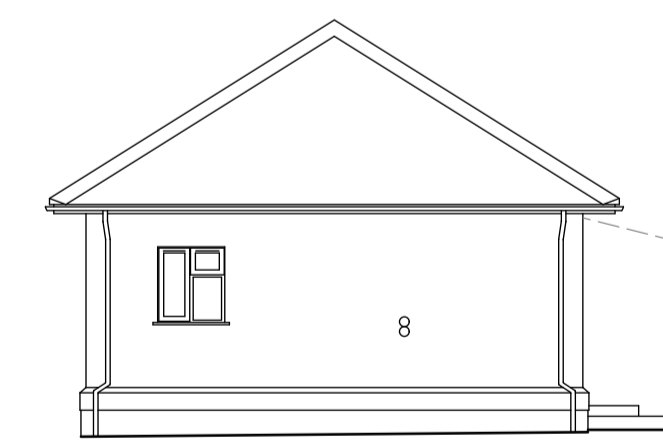

DATUM_165.00m_A.O.D.
ANNEXE
SIDE/NORTH-WEST ELEVATION

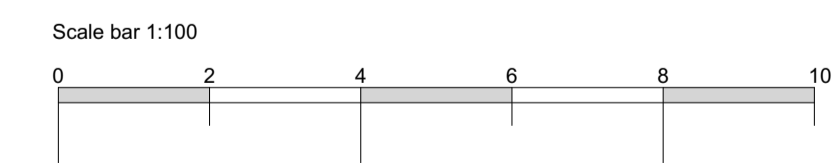

coombes : everitt architects limited
105-107
Bath Road
Cheltenham
Gloucestershire
GL53 7LE
t: 01242 807727 f: 0845 5575833
e: info@ce-architects.co.uk
www.ce-architects.co.uk

- Preliminary
- Feasibility
- Planning
- Building Regulations
- Tender
- Construction issue
- As Built

1. This drawing and content is copyright © of coombes : everitt architects limited and should not be copied without their prior written consent.
2. Do not scale drawing. all dimensions to be checked on site prior to construction and any discrepancies reported to contract administrator.
3. Do not use this drawing for setting out unless drawing specifically indicates setting out points.
4. Engineering information is indicative only and should be taken from structural engineers design.



Revisions
A June 2022 AH Proposed elevations (with dormer removed) added

Drawing title: Sunnyside Existing Buildings Elevations + Dormer Removed

Client: Mrs N Stranks
Drawn by: AH Checked: JE
Project No: 20.20.018

Project: Land at Sunnyside, Gloucester Road, Andoversford GL54 4HR

Scale: 1:100 @ A1
Date: May 2022
Project / Drawing No: 20.20.018 PL105A