
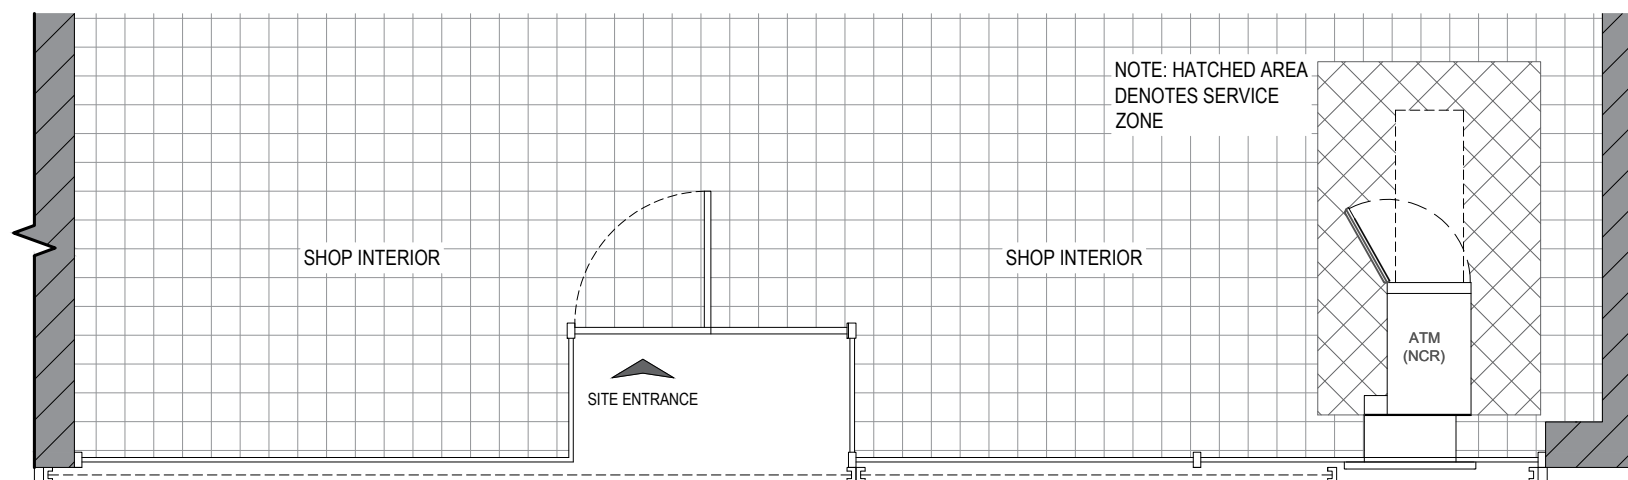



AS-INSTALLED FRONT ELEVATION

Scale 1:50

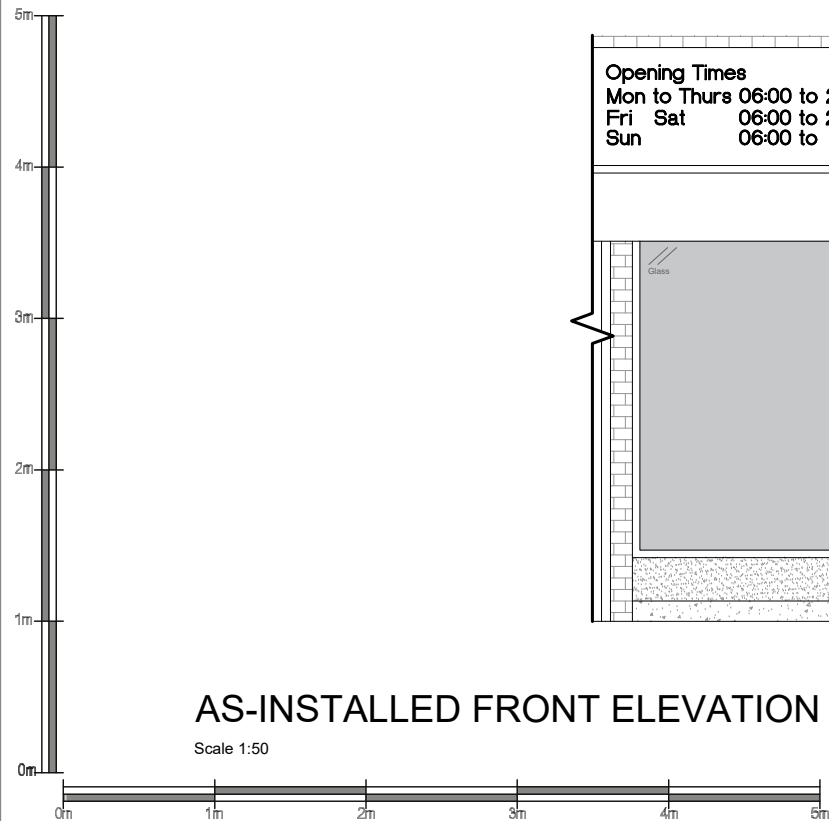

AS-INSTALLED PART PLAN

Scale 1:50

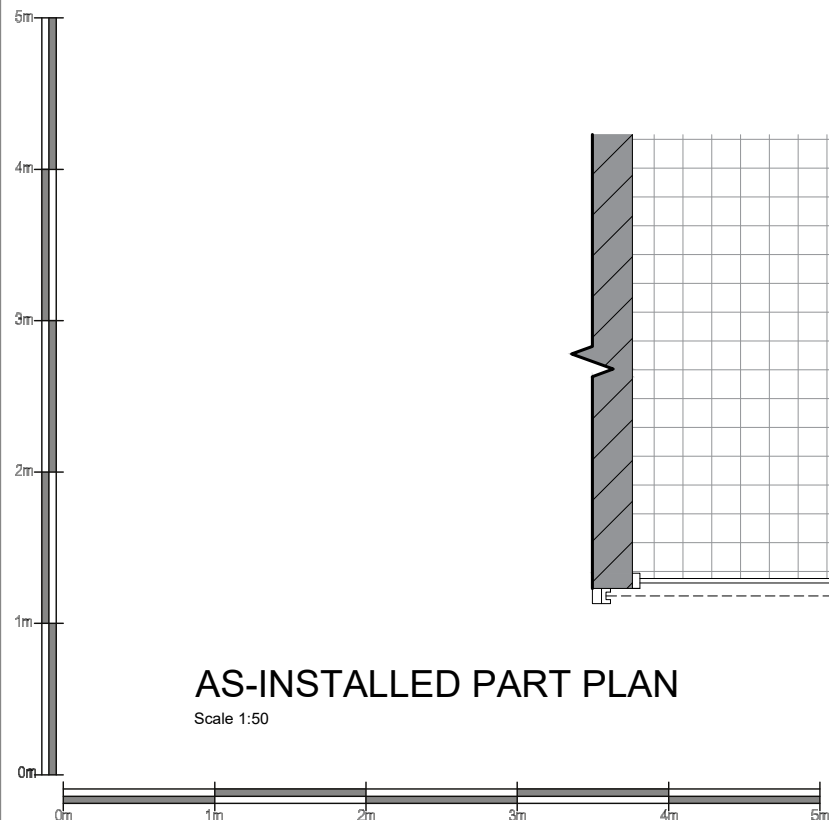

Date:	Comments:	By:
-------	-----------	-----

GENERAL NOTES:
 1) All dimensions in millimeters unless otherwise stated.

Site:
 363 Food And Wines,
 363 RAYLEIGH ROAD,
 BENFLEET,
 SS7 3SS

Drawing Title:
 As-Installed Plan and Elevation

Ref: T020848_AI	Date: 25/04/2022	Rev:
Scale: 1:50	Paper: A3	Date Rev: