




Location Plan: Existing

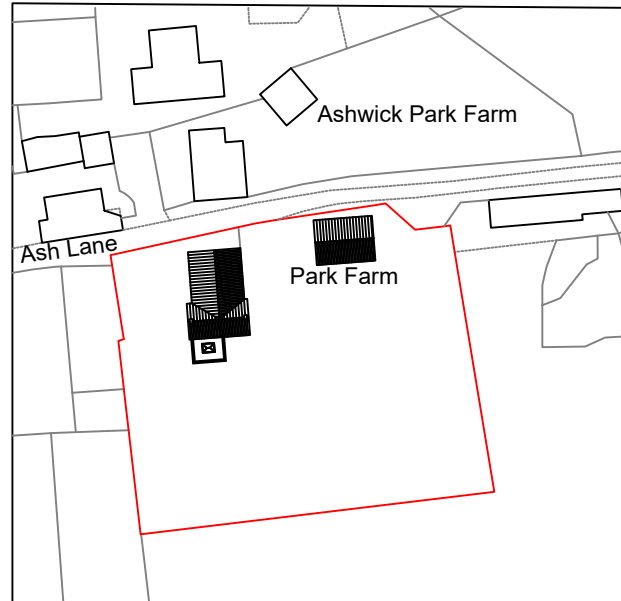

Location Plan: As Built

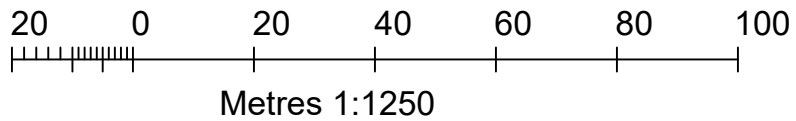

| Rev.  | Description | By          | Date                      |
|---|-------------|-------------|---------------------------|
|   |             |             |                           |
|   |             |             |                           |
|  <b>LEONINE CAD LTD</b><br>636 Dorchester Road, Upwey<br>Weymouth, Dorset, DT3 5LQ<br><small>TEL: 07811 377545<br/>                 EMAIL: jo@leoninecad.co.uk</small> |             |             |                           |
| <b>Project:</b><br>PARK FARM, ASH LANE, NEIGHBOURNE<br>RADSTOCK, SOMERSET, BA3 5BQ<br>For Mr & Mrs R Hole   |             |             |                           |
| <b>Drawing Title:</b><br>LOCATION PLAN  |             |             |                           |
| <b>Drawing No:</b><br>208.00.03   |             | <b>Rev.</b> | <b>Scale</b><br>1:1250@A4 |
| <b>Date</b><br>DEC 2020   |             |             |                           |