


As Built First Floor Plan. Partial measured survey undertaken.

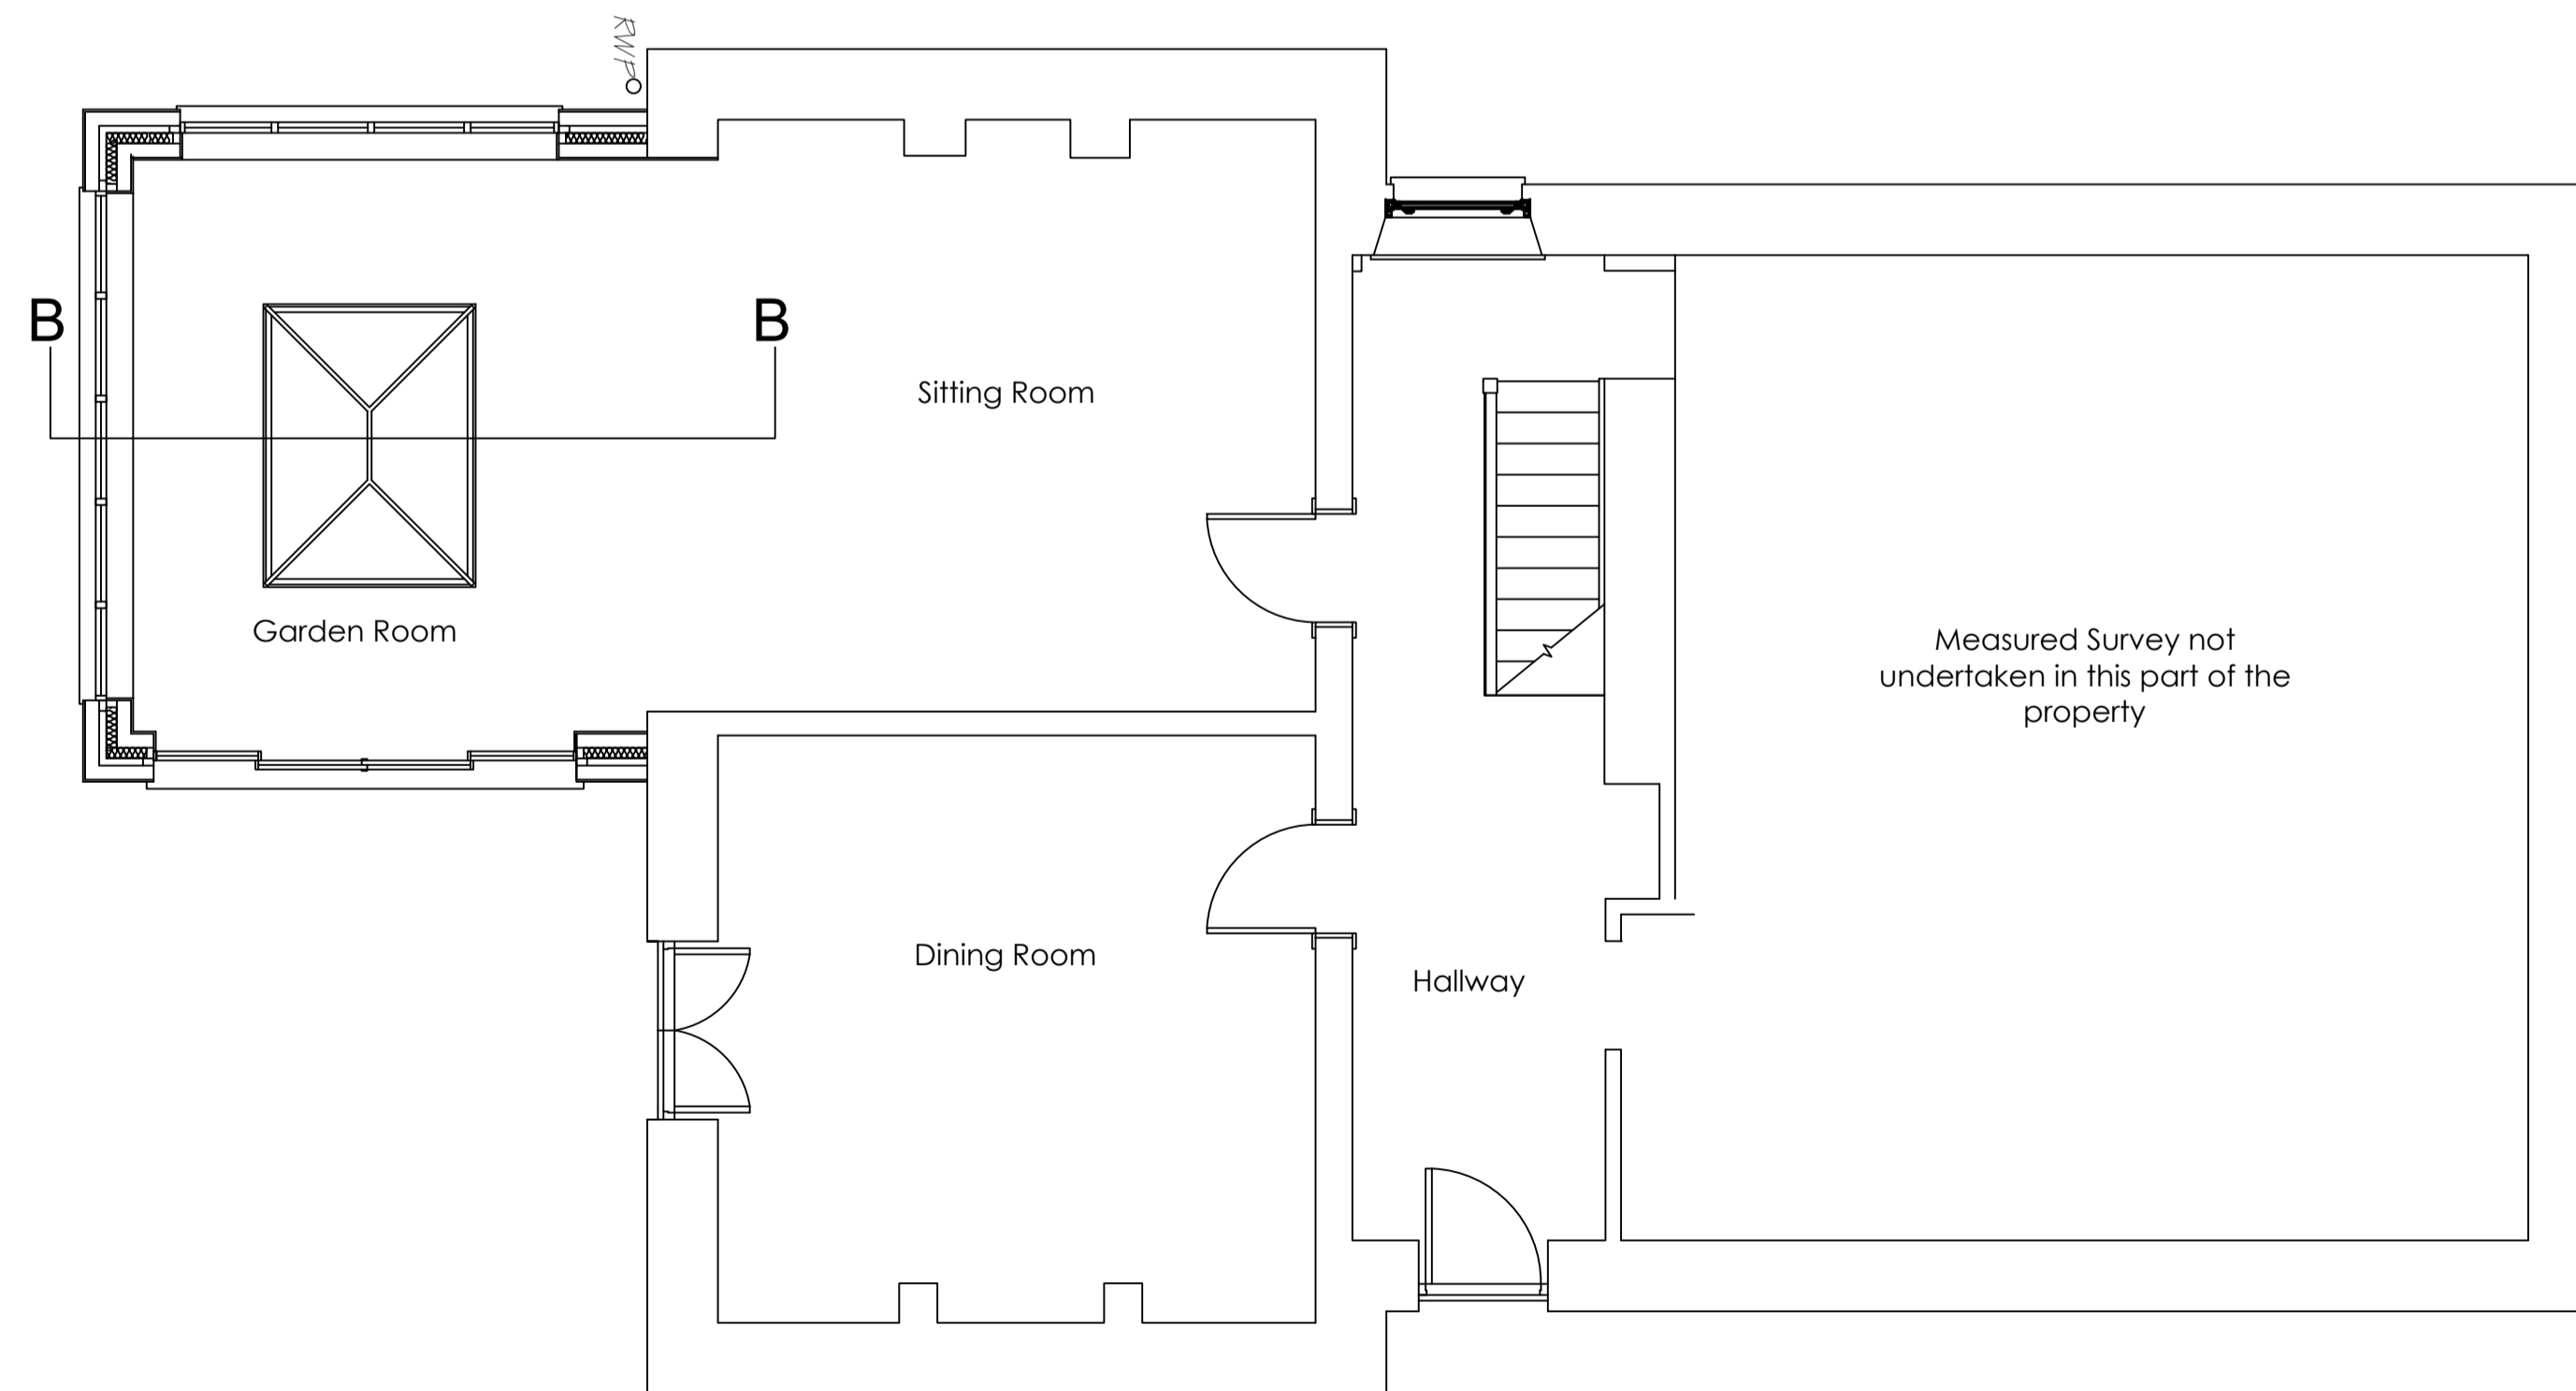

As Built Ground Floor Plan.


DUE TO UNAVOIDABLE INACCURACIES DURING THE REPRODUCTION PROCESS THIS DRAWING SHOULD NOT BE SCALED WHERE DIMENSIONS ARE CRITICAL. MEASUREMENTS MAY ONLY BE SCALED FROM THIS DRAWING FOR PLANNING PURPOSES. DO NOT SCALE FROM THIS DRAWING FOR CONSTRUCTION OR ANY OTHER PURPOSES. USE ONLY FIGURED DIMENSIONS. IF IN DOUBT, ASK.

DUE TO THE LIMITATIONS OF THE MEASURED SURVEY IN THE CURRENT COVID-19 CRISIS, ALL DIMENSIONS, LEVELS AND PARTICULARS ARE TO BE CHECKED ON SITE BEFORE WORK COMMENCES. ANY DISCREPANCY MUST BE REPORTED TO LEONINE CAD LTD BEFORE ANY WORK COMMENCES.

ALL DIMENSIONS ARE IN METRES OR MILLIMETRES UNLESS OTHERWISE STATED.

THIS DRAWING REMAINS THE COPYRIGHT OF LEONINE CAD LTD AND MAY NOT BE COPIED OR REPRODUCED IN PART OR WHOLE WITHOUT THEIR PRIOR WRITTEN APPROVAL.

THIS DRAWING IS FOR PLANNING PURPOSES ONLY AND SHOULD NOT BE RELIED UPON FOR CONSTRUCTION PURPOSES.

Rev.	Description	Date
 <b>LEONINE CAD LTD</b> 636 Dorchester Road, Upwey, Weymouth, Dorset, DT3 5LQ <small>TEL: 07811 377545          EMAIL: jo@leoninecad.co.uk</small>		
<b>Project:</b> PARK FARM, ASH LANE, NEIGHBOURNE RADSTOCK, SOMERSET, BA3 5BQ For Mr & Mrs R Hole		
<b>Drawing Title:</b> AS BUILT FLOOR PLANS		
<b>Drawing No:</b> 208.03.00	<b>Rev.</b>	<b>Scale</b> 1:50@A1
<b>PLANNING APPLICATION</b>		<b>Date</b> JUN 2022