




Survey information is prepared in good faith to illustrate the as built and proposed situation. All dimensions and details as drawn shall be checked and verified on site and any anomalies noted prior to undertaking any works or placing orders for materials.

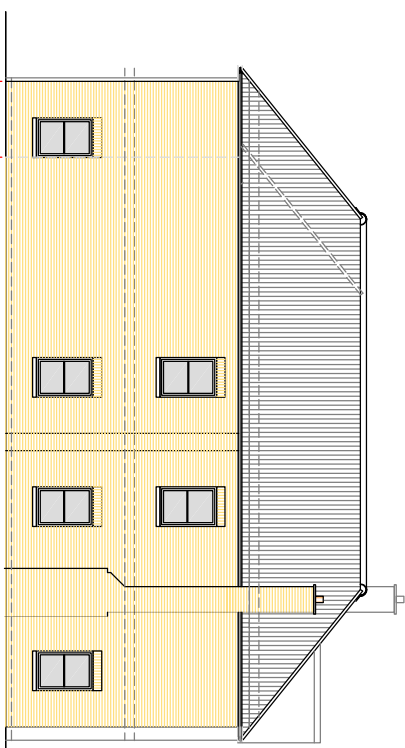

Side Elevation South 1/100

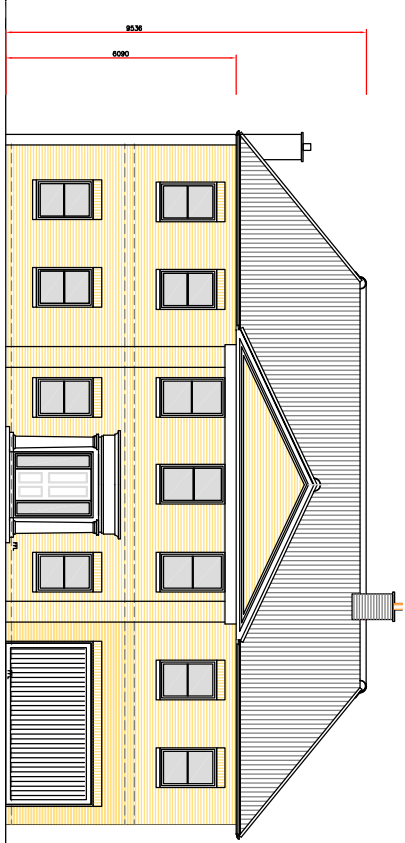

Front Elevation East 1/100

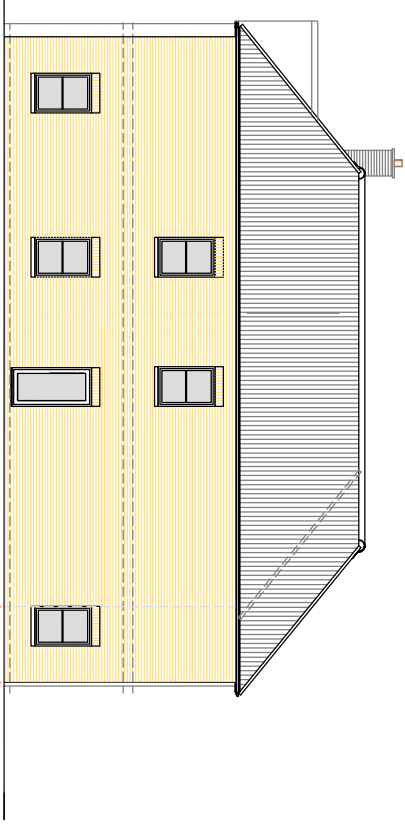


Side Elevation North 1/100

Materials-Proposed
 Roof tiles-concrete interlocking bold roll tiles colour and texture to match existing.
 Existing Roof modified and extended as hipped roof with upper internal flat roof.
 Upper flat roof of Grey single ply membrane installed as makers recommendations.
 Roof lights to upper flat roof as Valux or similar top lighting.
 PVCu fascias & barge board White to match existing.
 Rain water gutter & ramp's white UPvc to match existing.
 Elevations: yellow facing brick replaced or tinted with a red stock facing brick-natural mortar flush pointed joints.
 Sillier course Intel details to window and door heads
 Reconstituted stone portico style entrance canopy and upper portico gable detailing.
 PVCu window frames-vertical sliding sash.
 Reconstituted stone sill detail to windows. Double glazed sealed units.



Rear Elevation West 1/100

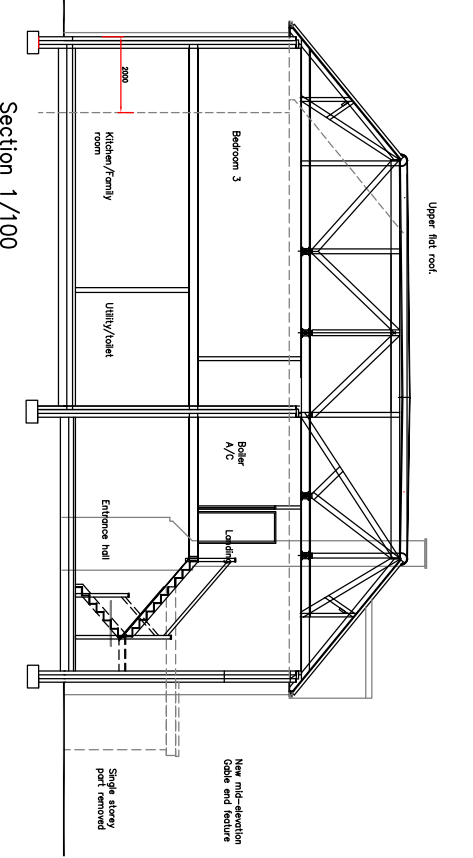

Section 1/100

PA3	Foot print front to rear +2m	28.01.22
PA2	Basement removed	17.07.19
PA1	Schemes amended as discussed with DBC Planning Team	18.08.18
A	SI005A inserted to 200-01-6A2	10.08.18
Rev.	Description	Date

Proposed extension & alterations of existing dwelling.

Project:
 13 Longdean Park
 Hemel Hempstead
 Herts HP3 8BZ

Title:
 Proposed Elevations
 Zm-Front & Back

Project Designer: Scale: 1:100
 Date: Sept 2018

Status: PLANNING DRAWING

Drawing No. 200-02 **Rev** PA3

Scale Bar 1/100

