




Survey information is prepared in good faith to illustrate the as built situation. All dimensions and details as drawn shall be checked and verified on site and any anomalies reported prior to undertaking any works or placing orders for materials.

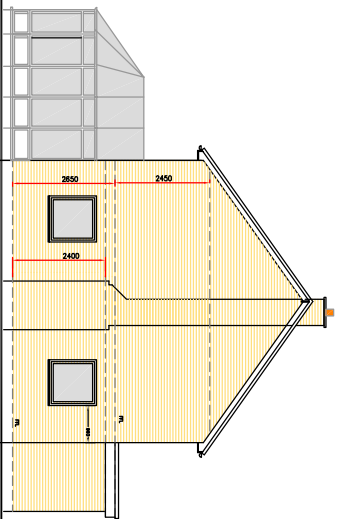


Side Elevation South 1/100

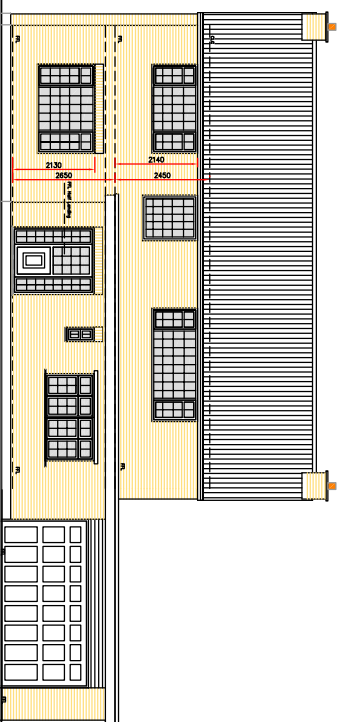


Front Elevation East 1/100

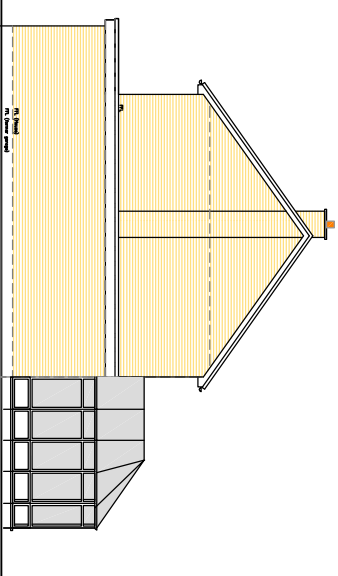


Side Elevation North 1/100

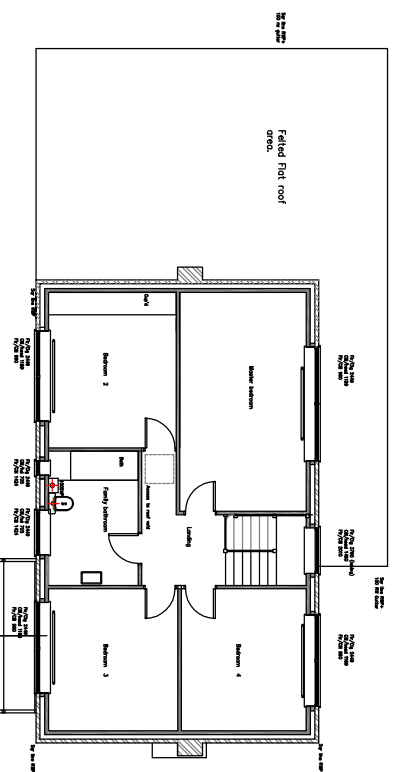


First floor plan 1/100

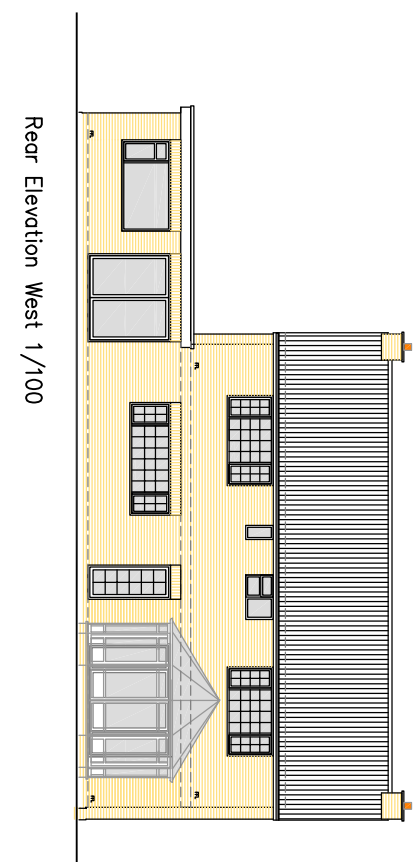


Rear Elevation West 1/100

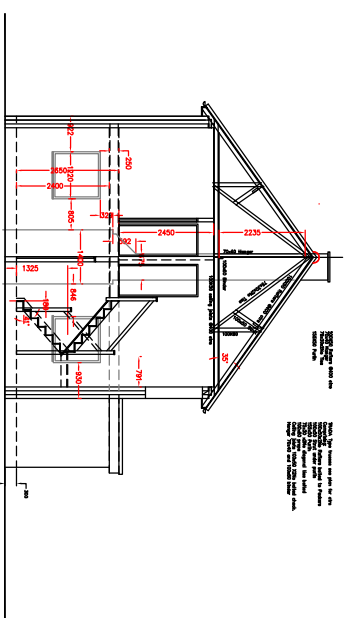

Typical Section 1/100

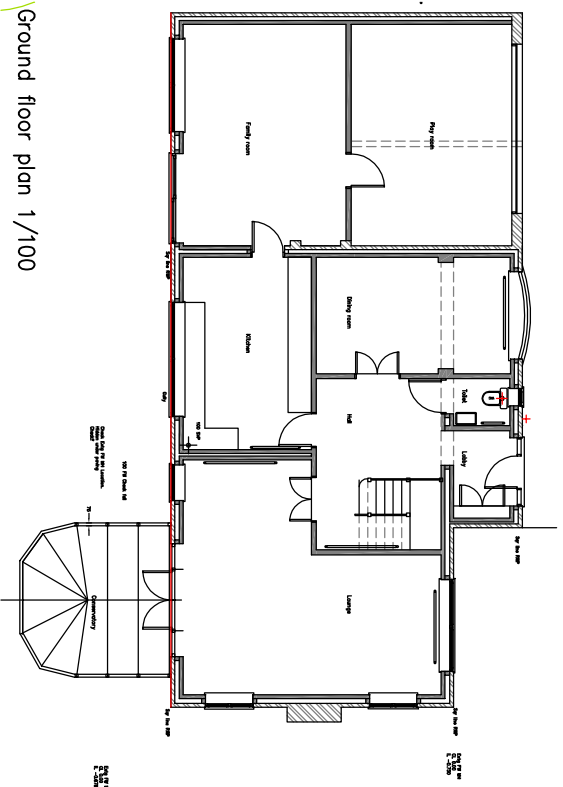

Ground floor plan 1/100

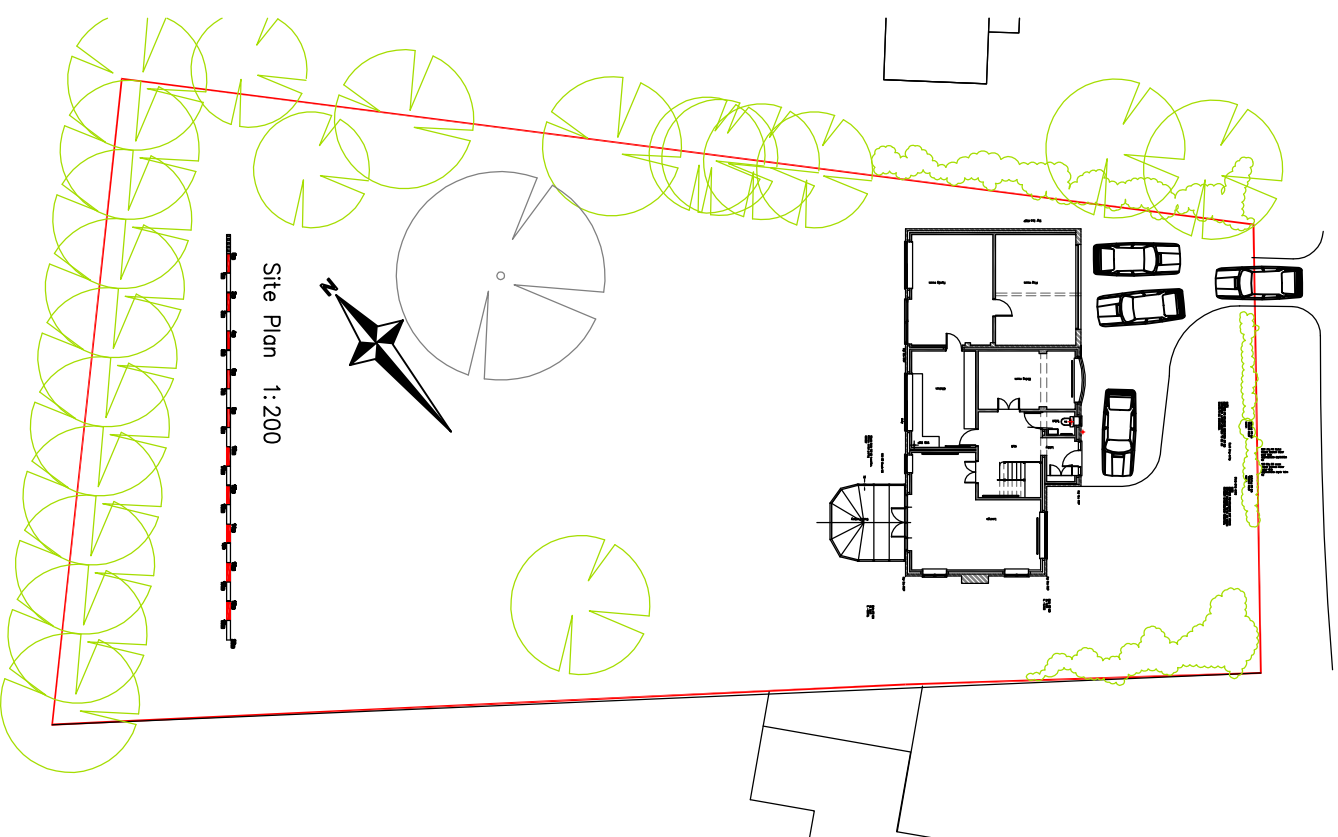

Site Plan 1:200



Existing dwelling-as built.

Rev.	Description	Date
PA1	Schemes amended as discussed with DBC Planning Team	18.09.18
A	SH024 amended to 200-01642	10.09.18

Project:
13 Longdean Park
Hemel Hempstead
Herts HP3 8BZ

Title:
Existing Elevations, Floor Plans
and Site plan

Project Design: Scale: 1:100
Project Designer: Date: Sept 2016
Status: PLANNING DRAWING

Drawing No. 200-00 **Rev** PA1