





North Elevation

West Elevation

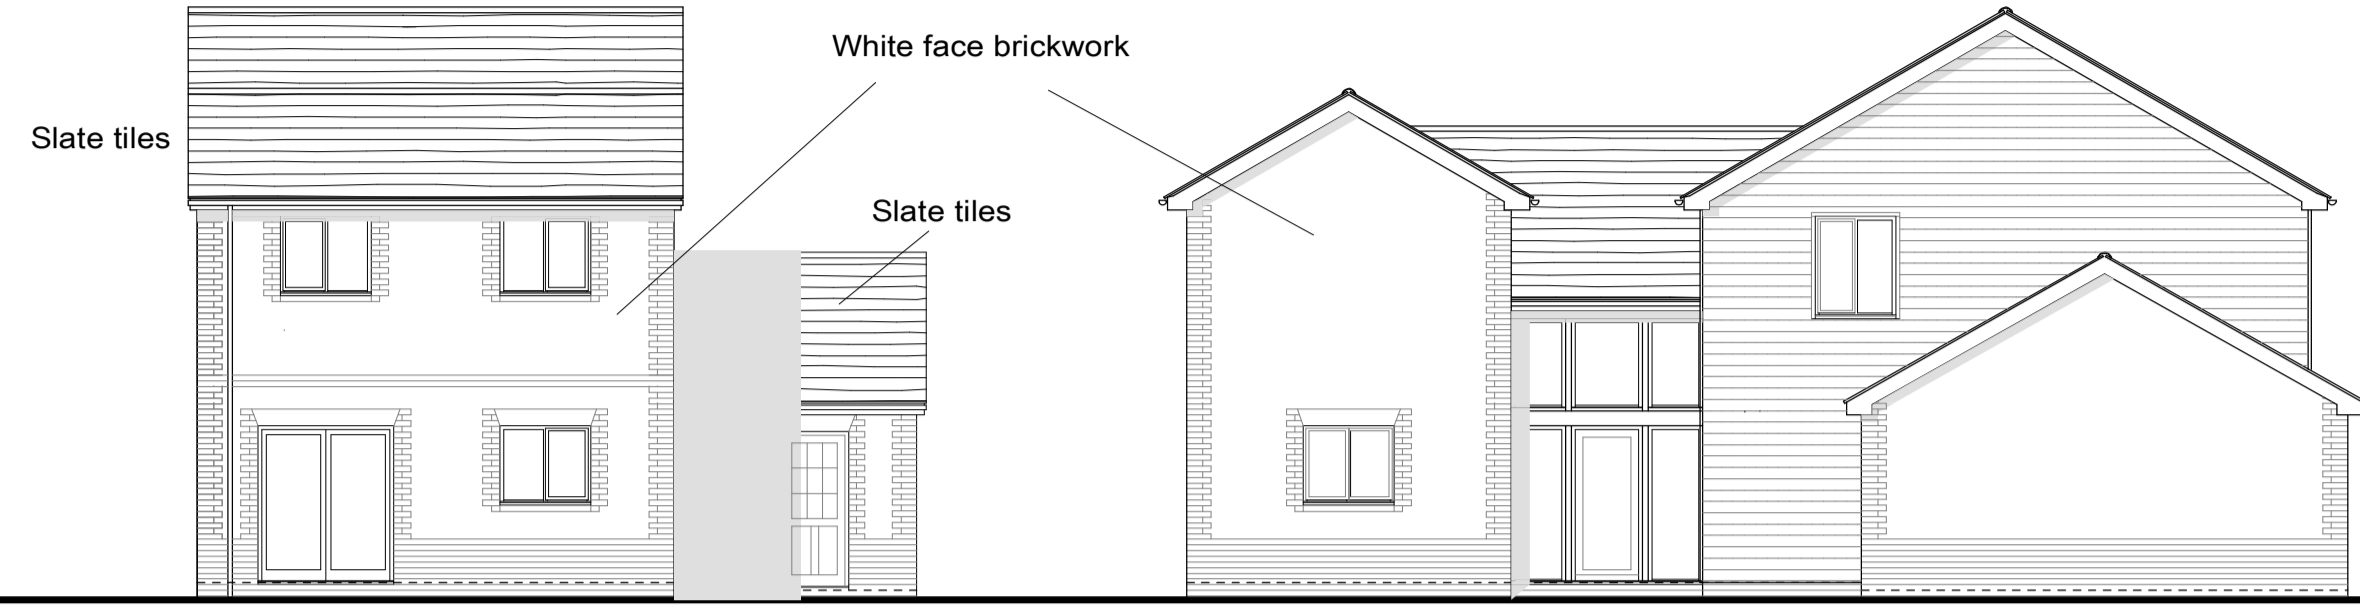


South Elevation


East Elevation

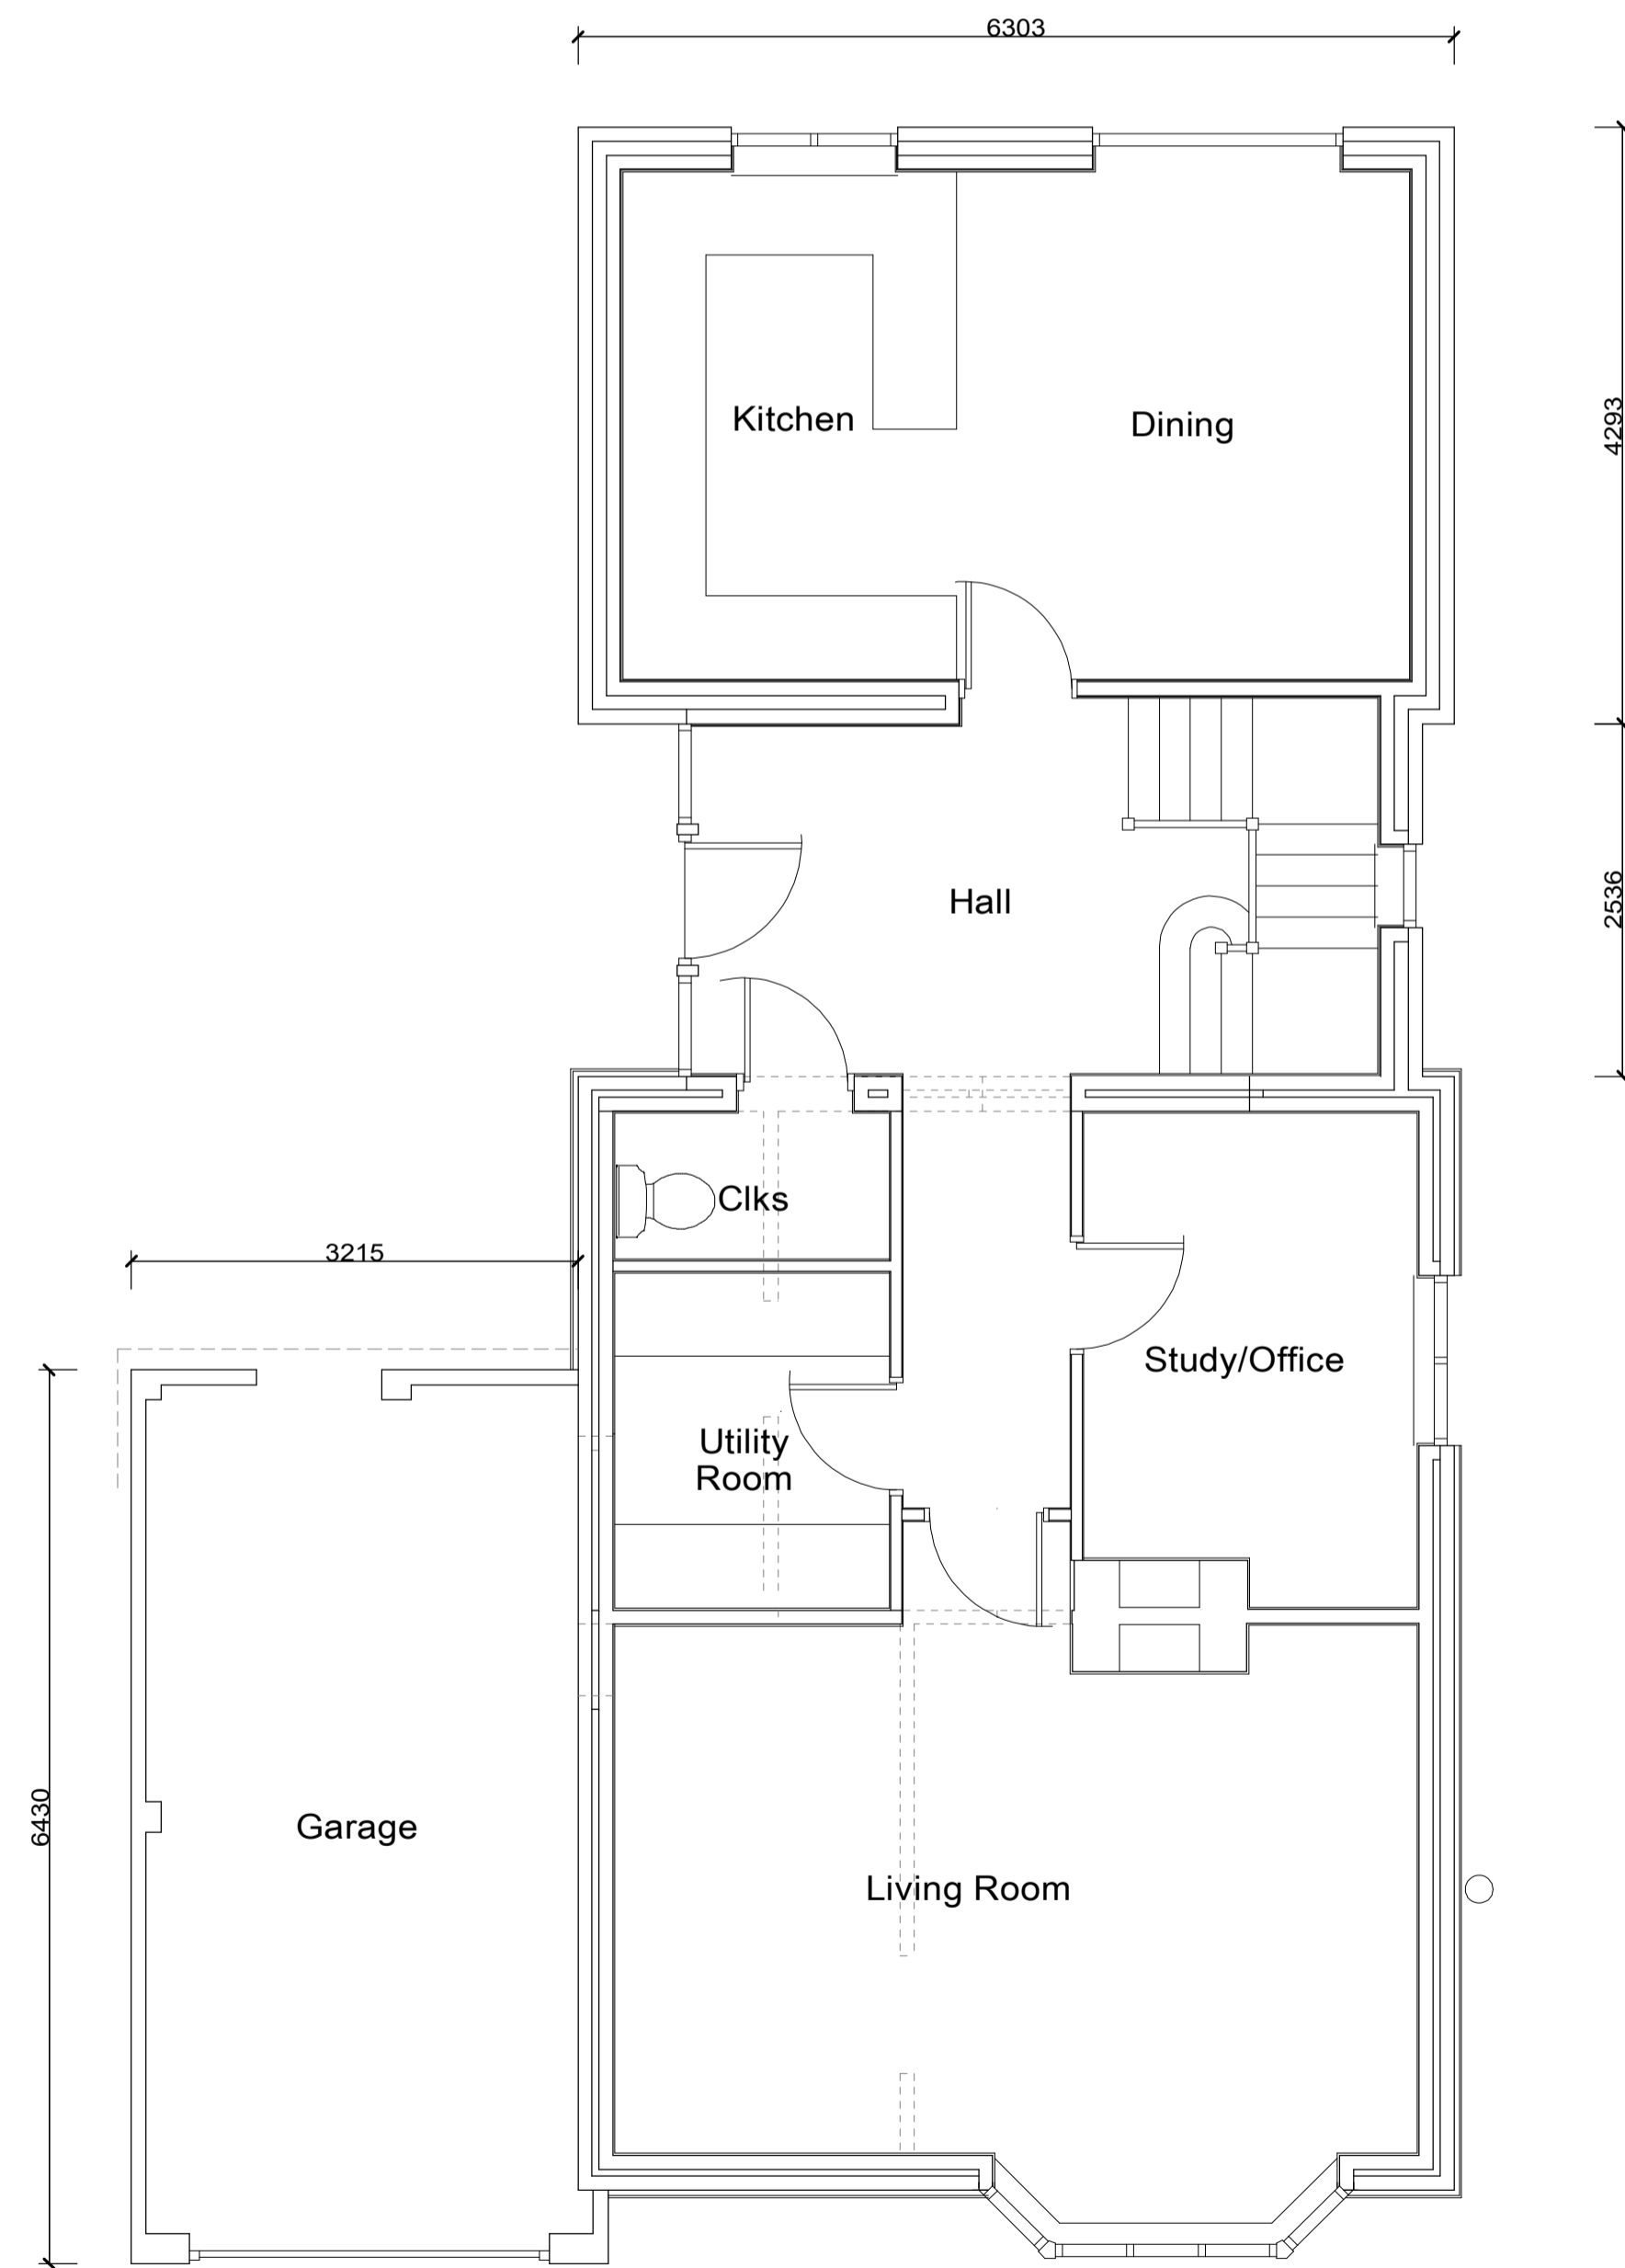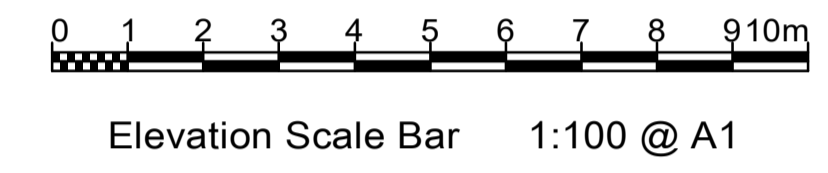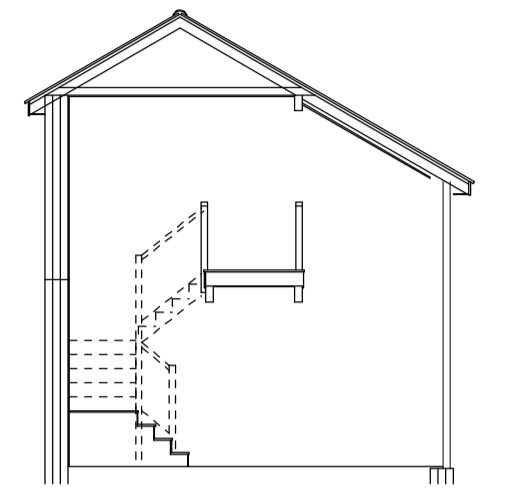

GROUND FLOOR PLAN

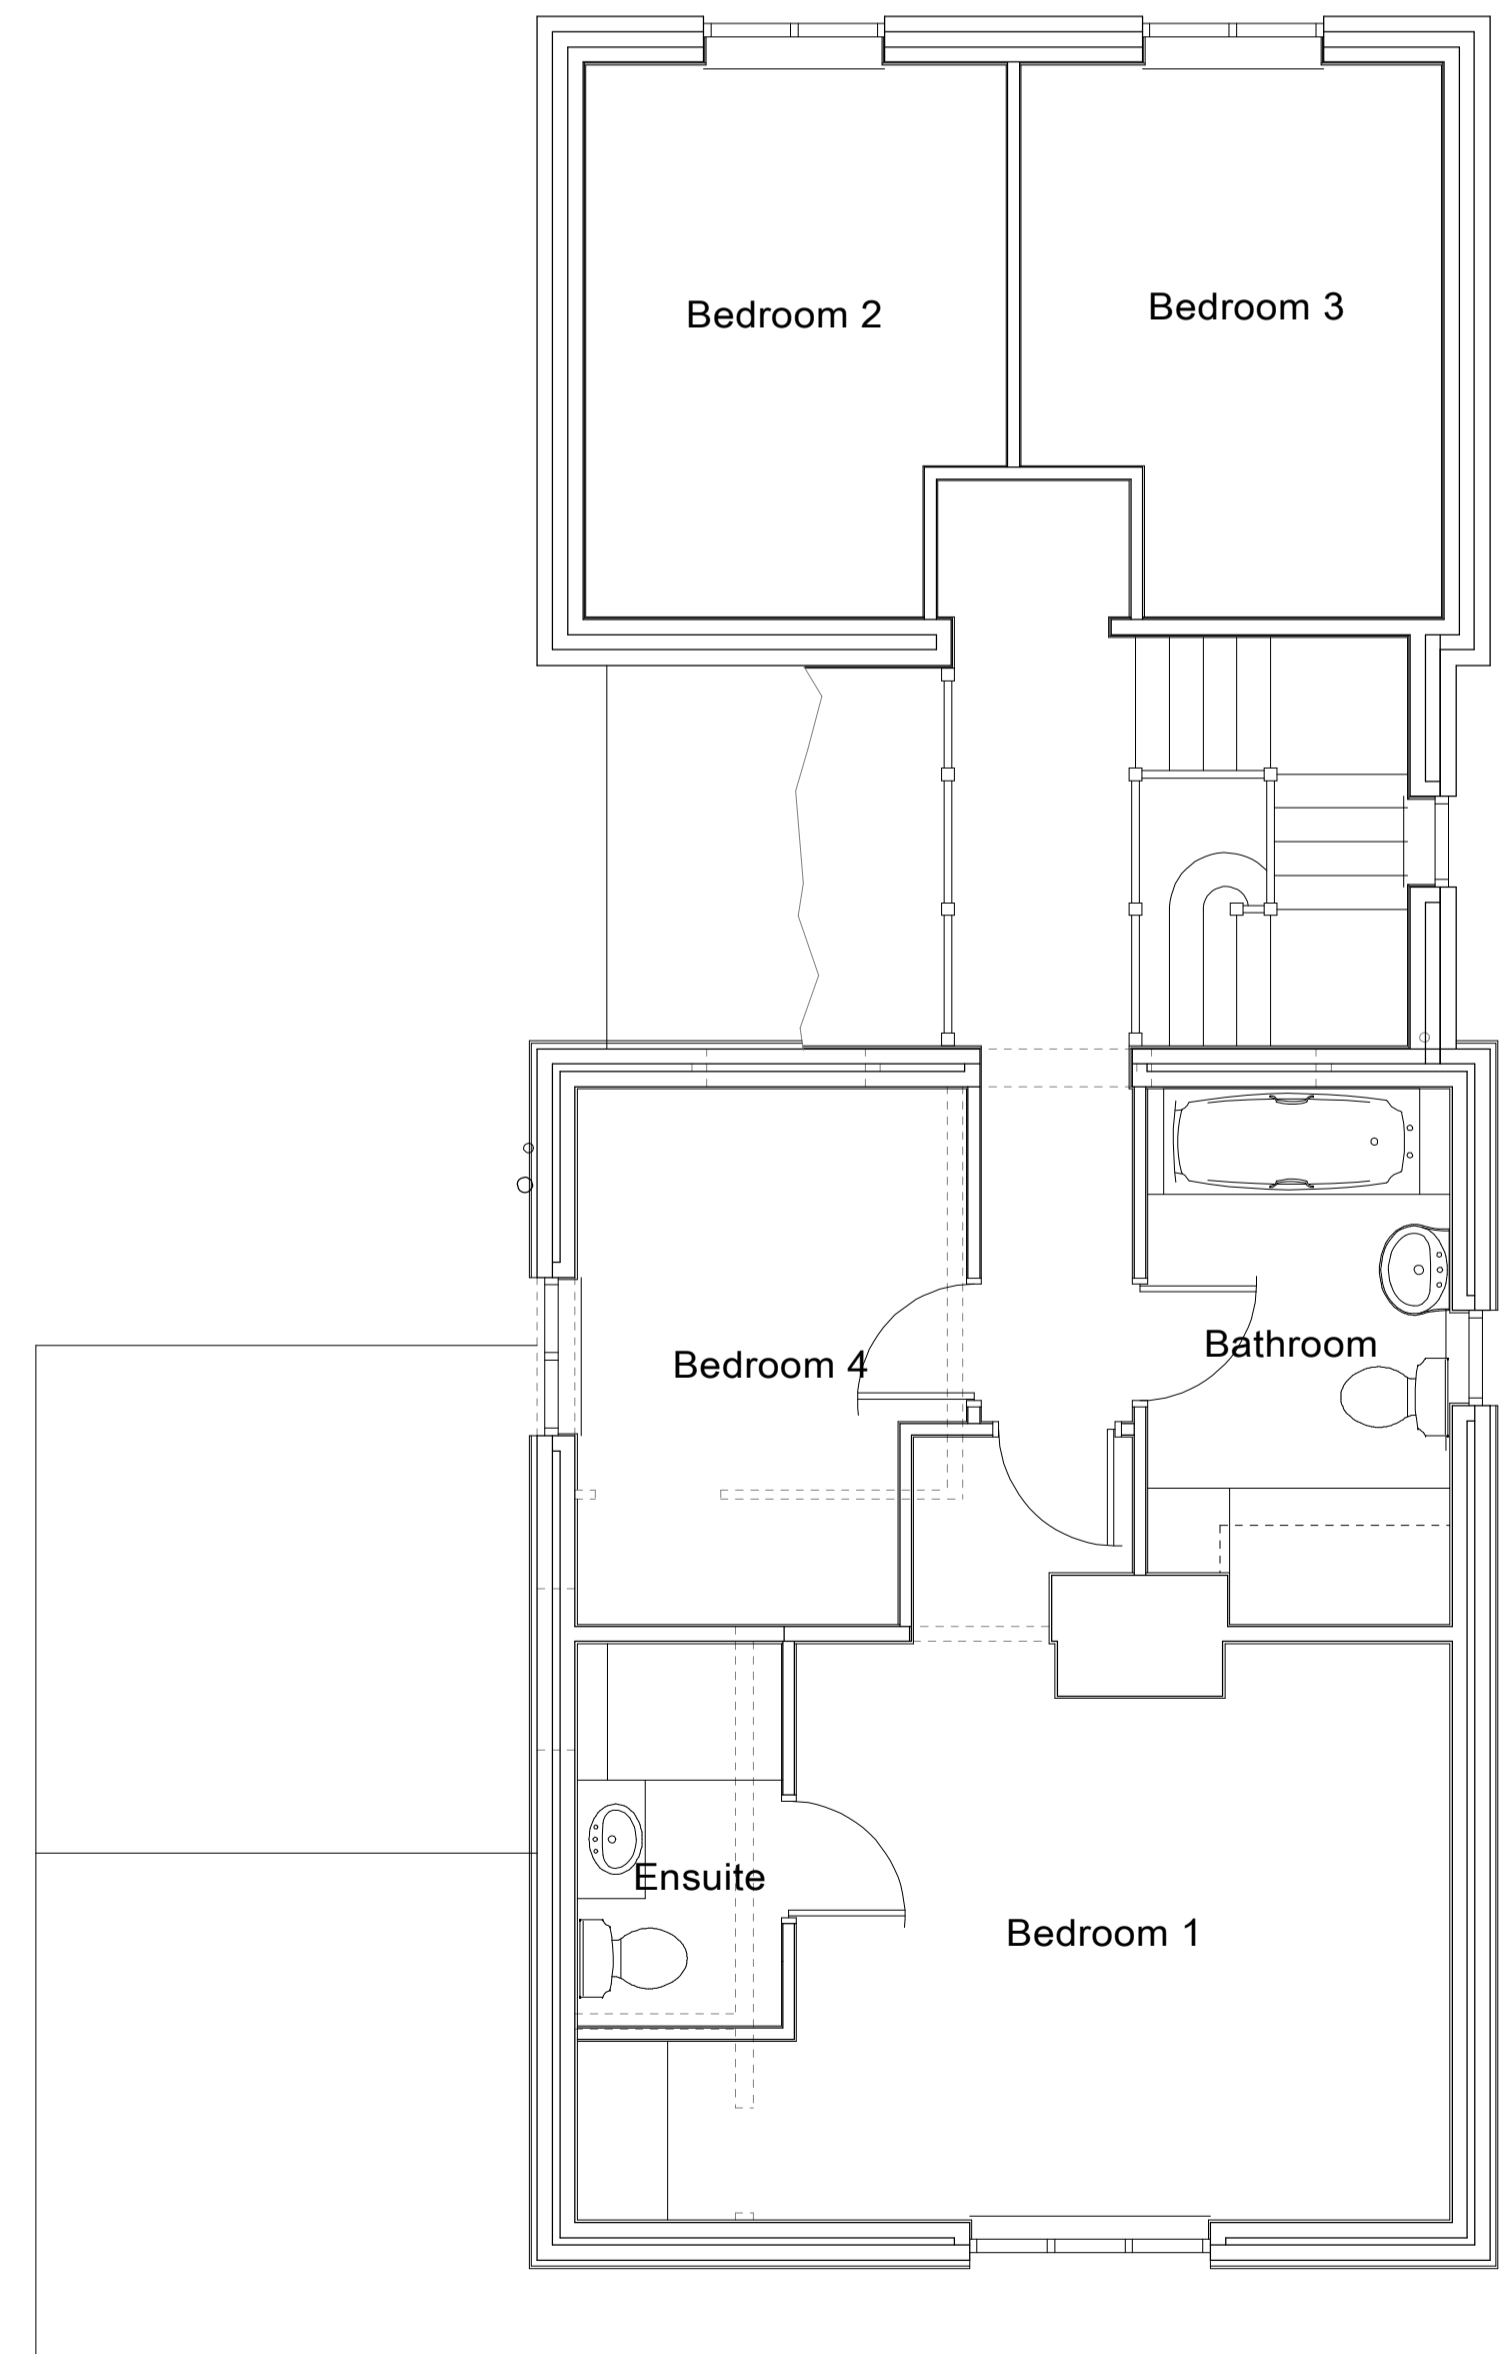

FIRST FLOOR PLAN

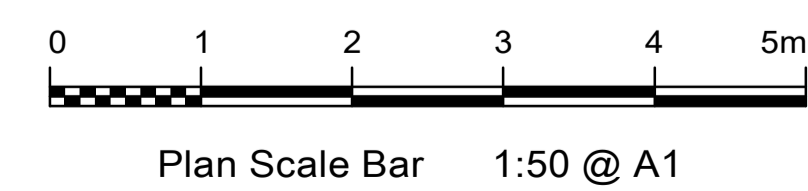

revisions:		
A	Utility Room Added	16.03.20
B	Elevations corrected to as built	03.08.22

clients:  
Mr A Ross

property:  
"Hawthorns"  
Long Thurlow  
Badwell Ash  
Bury St Edmunds IP31 3JA

title:  
Proposed  
Plans & Elevations

scale: 1:50 & 1:100  
date: March 2020

**A1**

drwg. no:  
**20008-02**

**A B**

**Paul Elliott**  
Architectural  
Services

4A Wenny Road, Chatteris, Cambs PE16 6UT  
01354 669248 / 07837 990724  
p.jelliott@btopenworld.com