



10m 20m
 scale 1:500

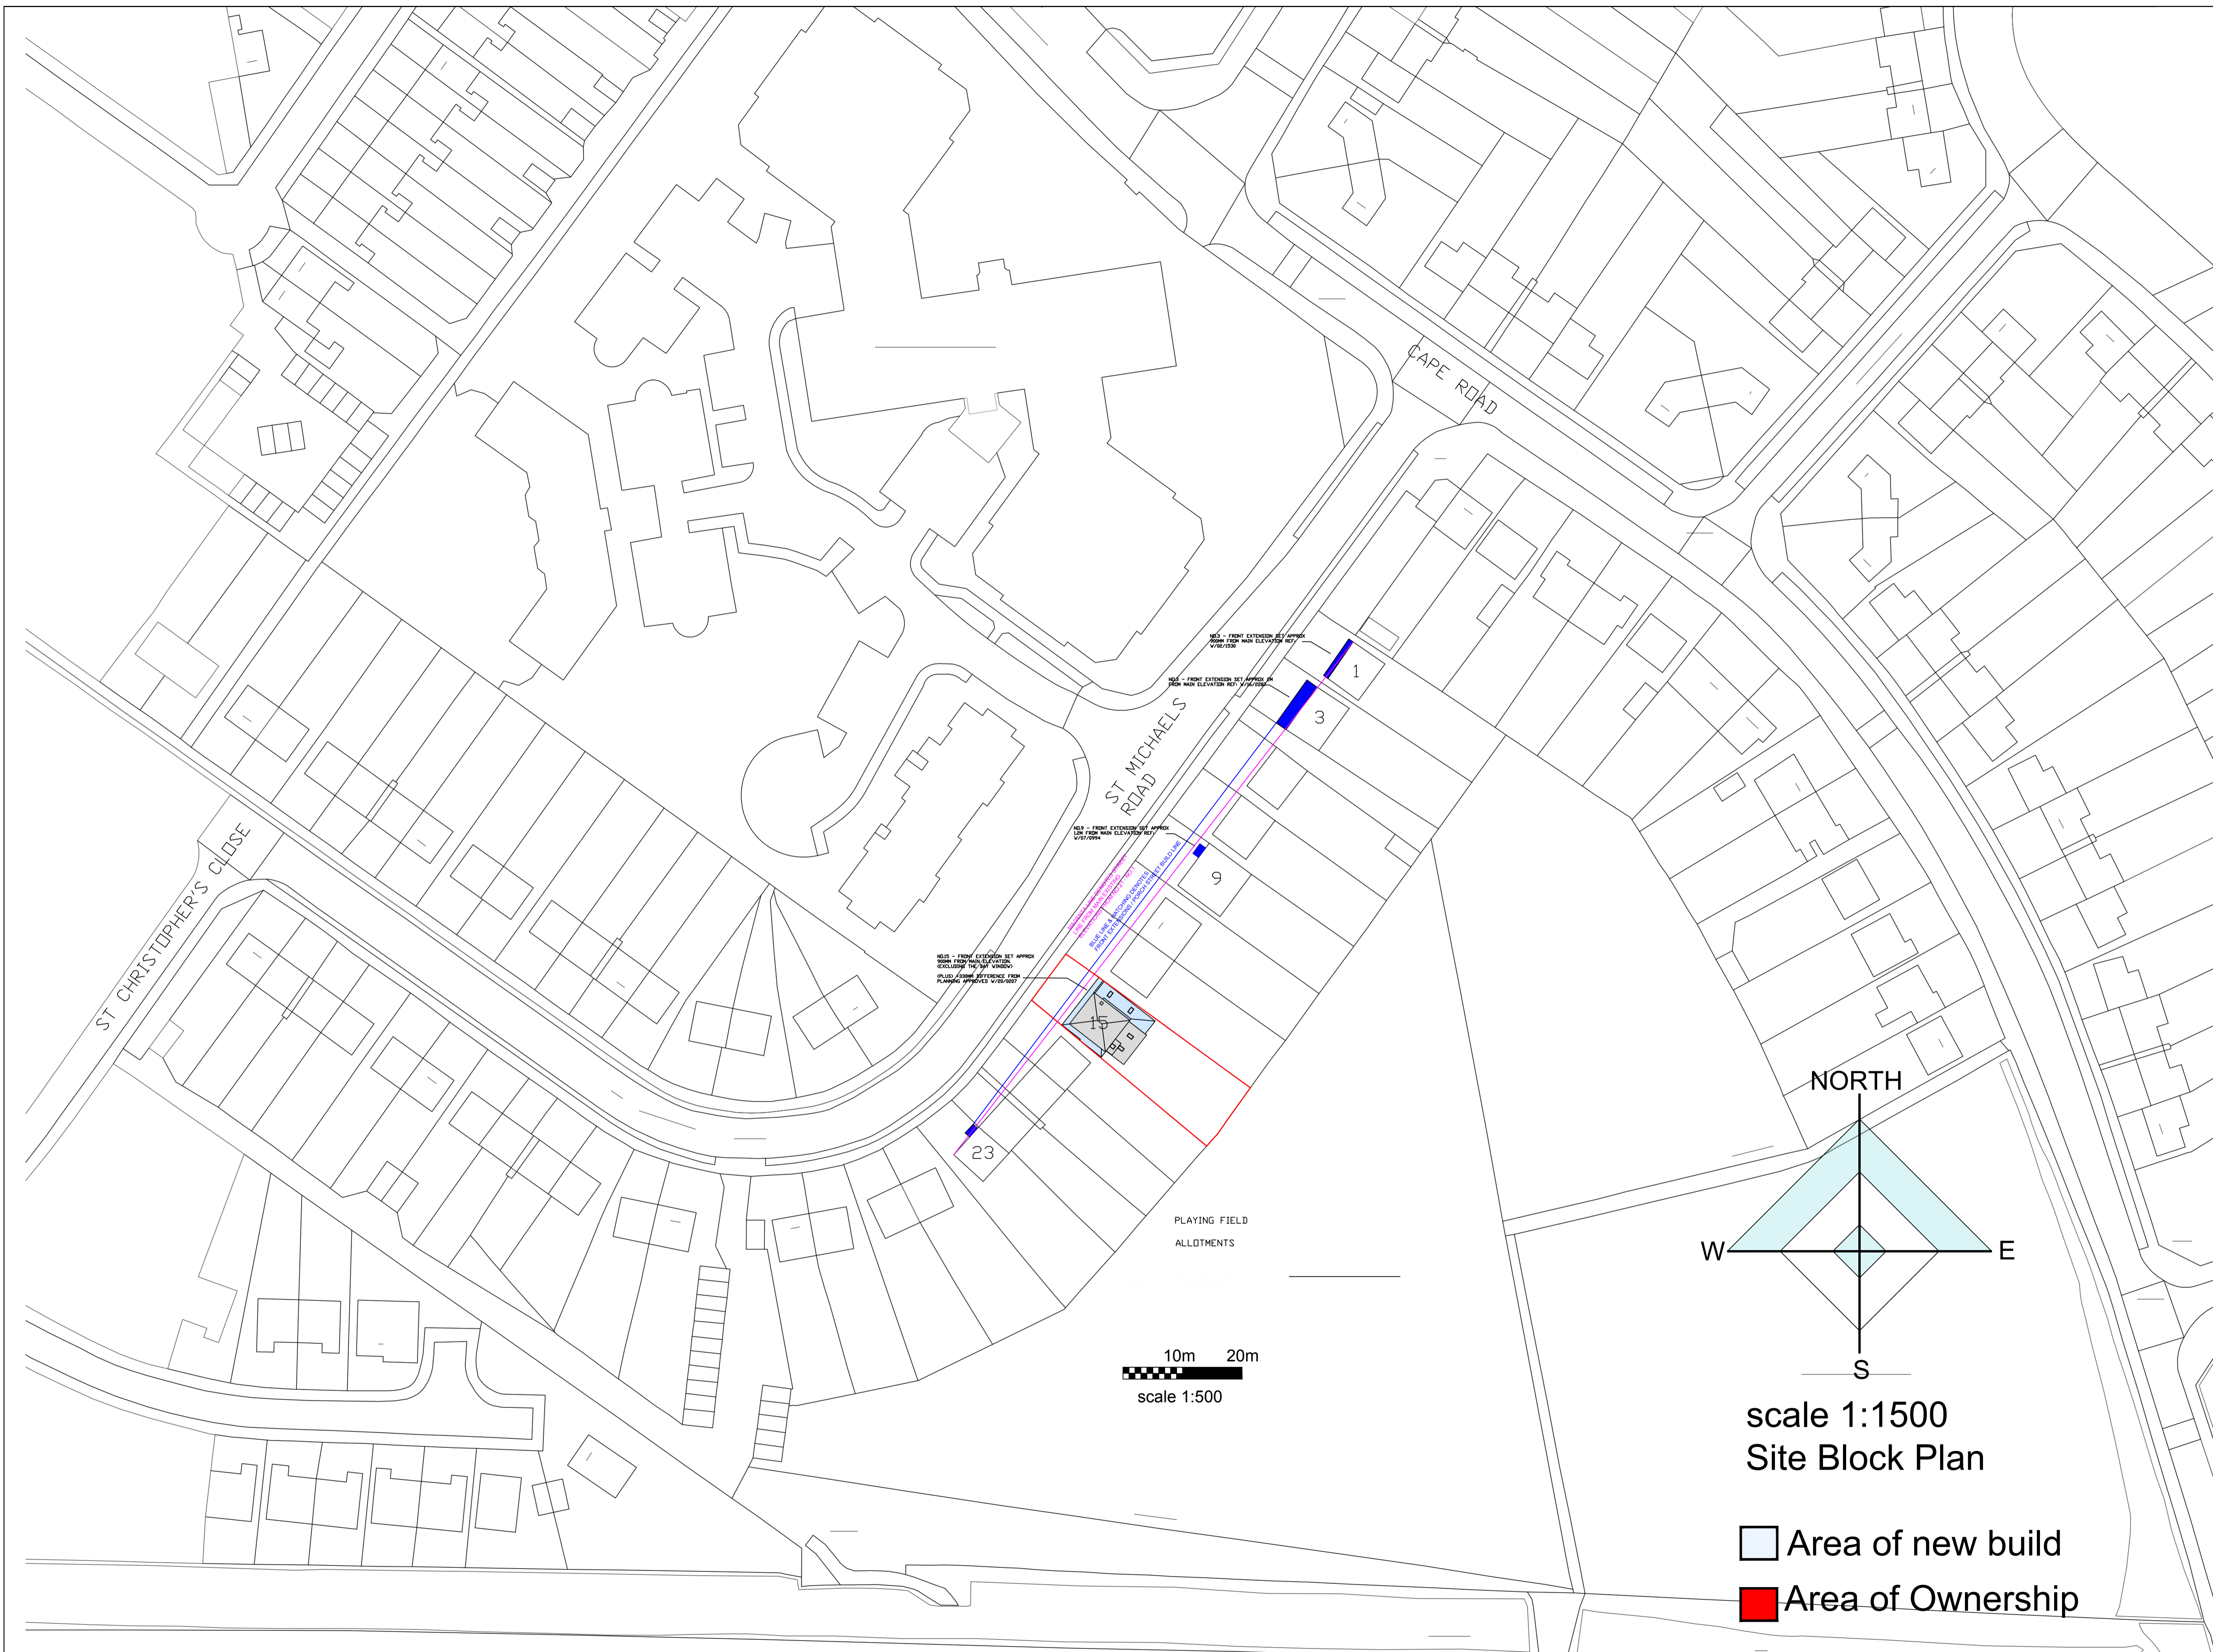

10m 20m
 scale 1:500

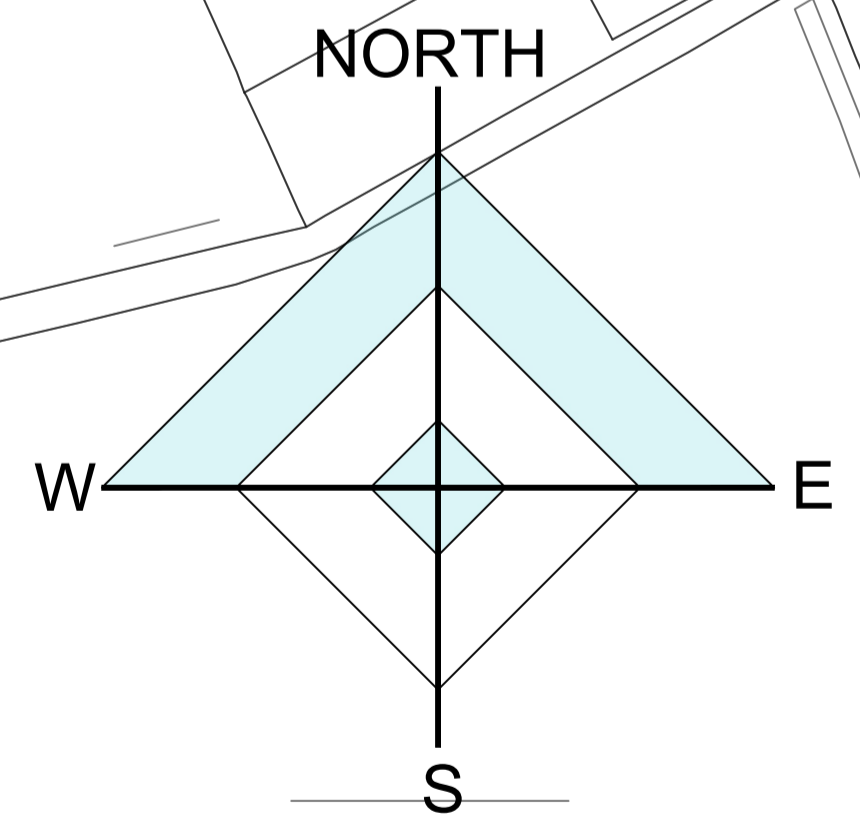

scale 1:1500
 Site Block Plan

- Area of new build
- Area of Ownership

LAJ
 Architectural
 Design Ltd
 Company Number 11118199
 Bank Gallery, 13 High Street,
 Kenilworth, Warwickshire, CV8 1LY
 web: LAJArchitecturalDesign.co.uk

PROJECT	
PROPOSED WORKS at: 15 ST MICHAELS WARWICK CV34 5RS	
DRAWING TITLE	
AS BUILT SITE BLOCK PLAN WITH STREET BUILD LINE GUIDES	
Drawing Status	PLANNING
Date	JULY 22
Drawn by	LAJ
Scale	1:500 @A1 as shown
Drawing No.	Revision
ENF-05	REVA