

NO.3 - FRONT EXTENSION SET APPROX 900MM FROM MAIN ELEVATION REF: W/02/1530


NO.3 - FRONT EXTENSION SET APPROX 2M FROM MAIN ELEVATION REF: W/16/2207

NO.9 - FRONT EXTENSION SET APPROX 1.2M FROM MAIN ELEVATION REF: W/07/0994

NO.15 - FRONT EXTENSION SET APPROX 900MM FROM MAIN ELEVATION (EXCLUDING THE BAY WINDOW) (PLUS) 4330MM DIFFERENCE FROM PLANNING APPROVED W/20/0207

MAGENTA LINE DENOTES STREET LINE FROM MAIN EXISTING ELEVATIONS FROM NO.1

BLUE LINE & HATCHING DENOTES FRONT EXTENSIONS / PORCH STREET BUILD LINE

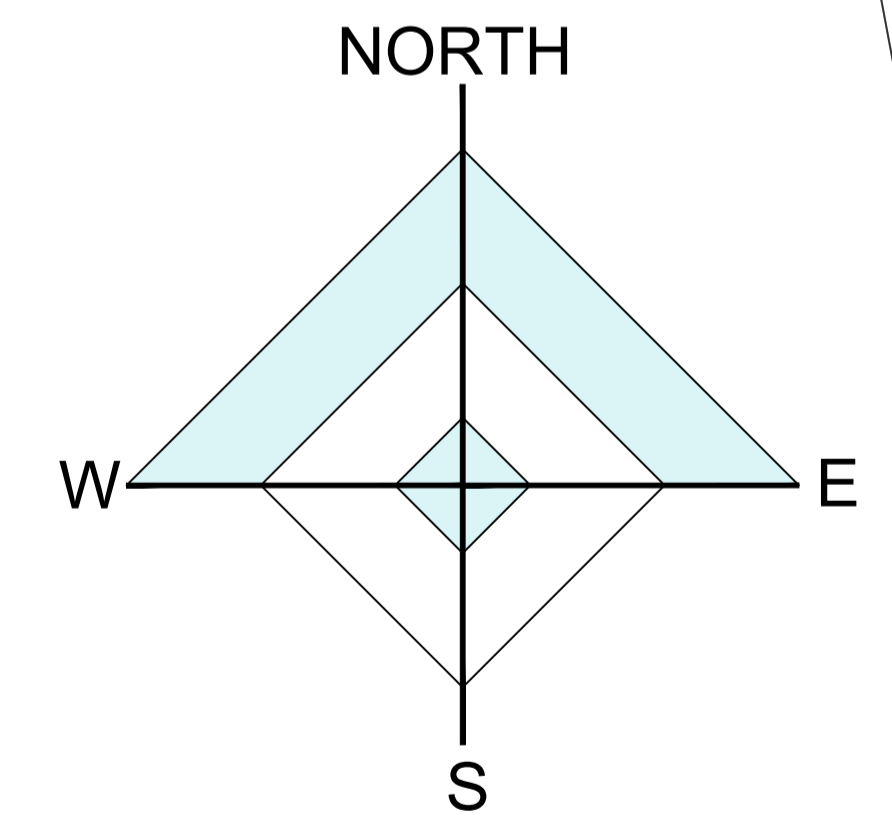

scale 1:1500
Site Block Plan

- Area of new build
- Area of Ownership

PLAYING FIELD ↗

ALLOTMENTS ↘

LAJ
Architectural Design Ltd
Company Number 11118199
Bank Gallery, 13 High Street,
Kenilworth, Warwickshire, CV8 1LY
web: LAJArchitecturalDesign.co.uk

PROJECT

PROPOSED WORKS at:
15 ST MICHAELS
WARWICK
CV34 5RS

DRAWING TITLE

AS BUILT SITE BLOCK PLAN
WITH STREET BUILD LINE
GUIDES

Drawing Status	PLANNING
Date	JULY 22
Drawn by	LAJ
Scale	1:200 @A1 as shown
Drawing No.	Revision
ENF-05	