


– GABLE 'CUT' PROFILE TO NEW ROOF ABOVE ENTRANCE DOOR GREY CLADDING TO GABLE INFILL



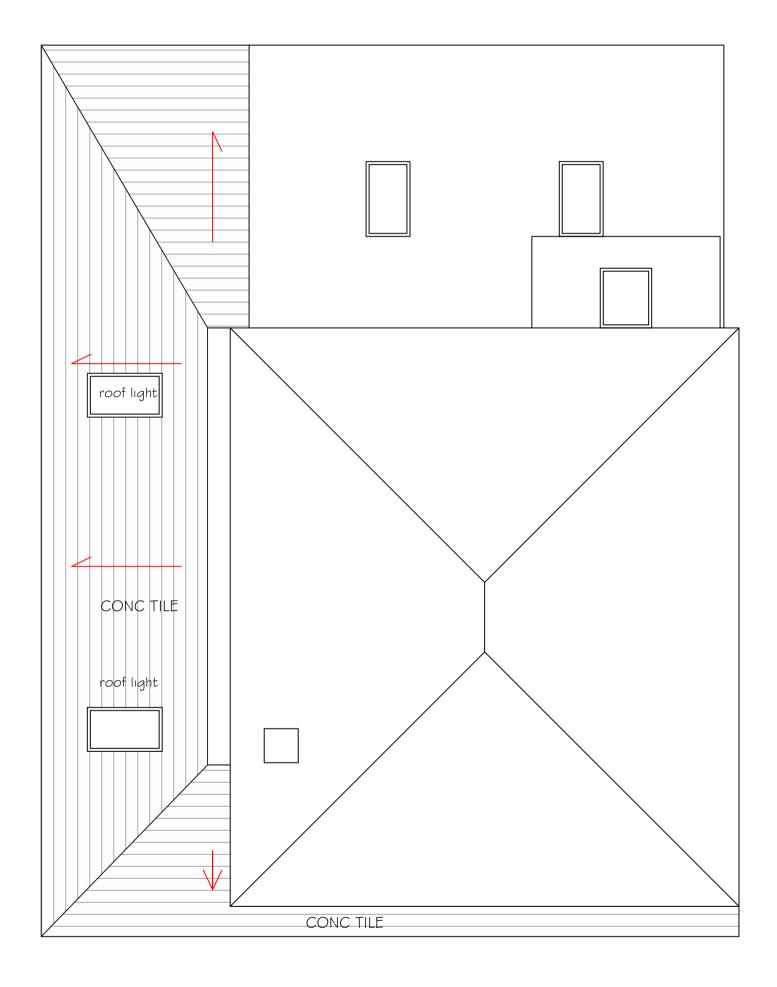

Architectural Design Ltd	
Company Number 11118199	
Bank Gallery, 13 High Street, Kenilworth,Warwickshire, CV8 1LY	
web: LAJArchitecturalDesign.co.uk	
PROJECT	
PROPOSED WORKS at: 15 ST MICHAELS WARWICK CV34 5RS	
DRAWING TITLE PLANNING APPROVED ROOF PLAN LAYOUT & AS BUILT ROOF PLAN LAYOUT PLAN	
Drawing Status	PLANNING
Date	JULY 22
Drawn by	LAJ
Scale 1:50 @A1 as shown	
Drawing No.	Revision
ENF-02	