


Planning Approved Roof Plan



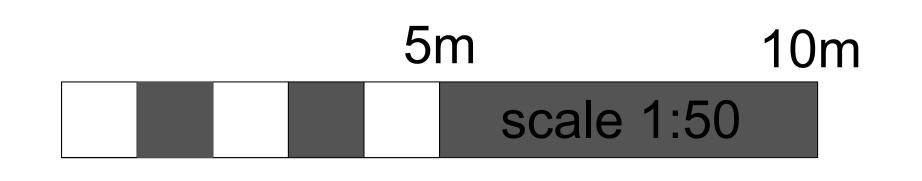

PROJECT

PROPOSED WORKS at:

15 ST MICHAELS WARWICK CV34 5RS

DRAWING TITLE

PLANNING APPROVED ROOF PLAN LAYOUT & AS BUILT ROOF PLAN LAYOUT PLAN

| | Scale | 1:50 @A | 1:50 @A1 as shown o. Revision | |
|--------------|----------|---------|--------------------------------|--|
| Date JULY 22 | Drawn by | | | |
| | Date | | JULY 22 | |