


Birdcombe Court Form  
Ridge Ht 33.25  
Eaves Ht 28.31

Birdcombe Court  
Tower Ridge Ht 38.79  
Tower Eaves Ht 36.54  
Main Ridge Ht 34.02  
Eaves Ht 29.72  
Parapet Ht 31.31

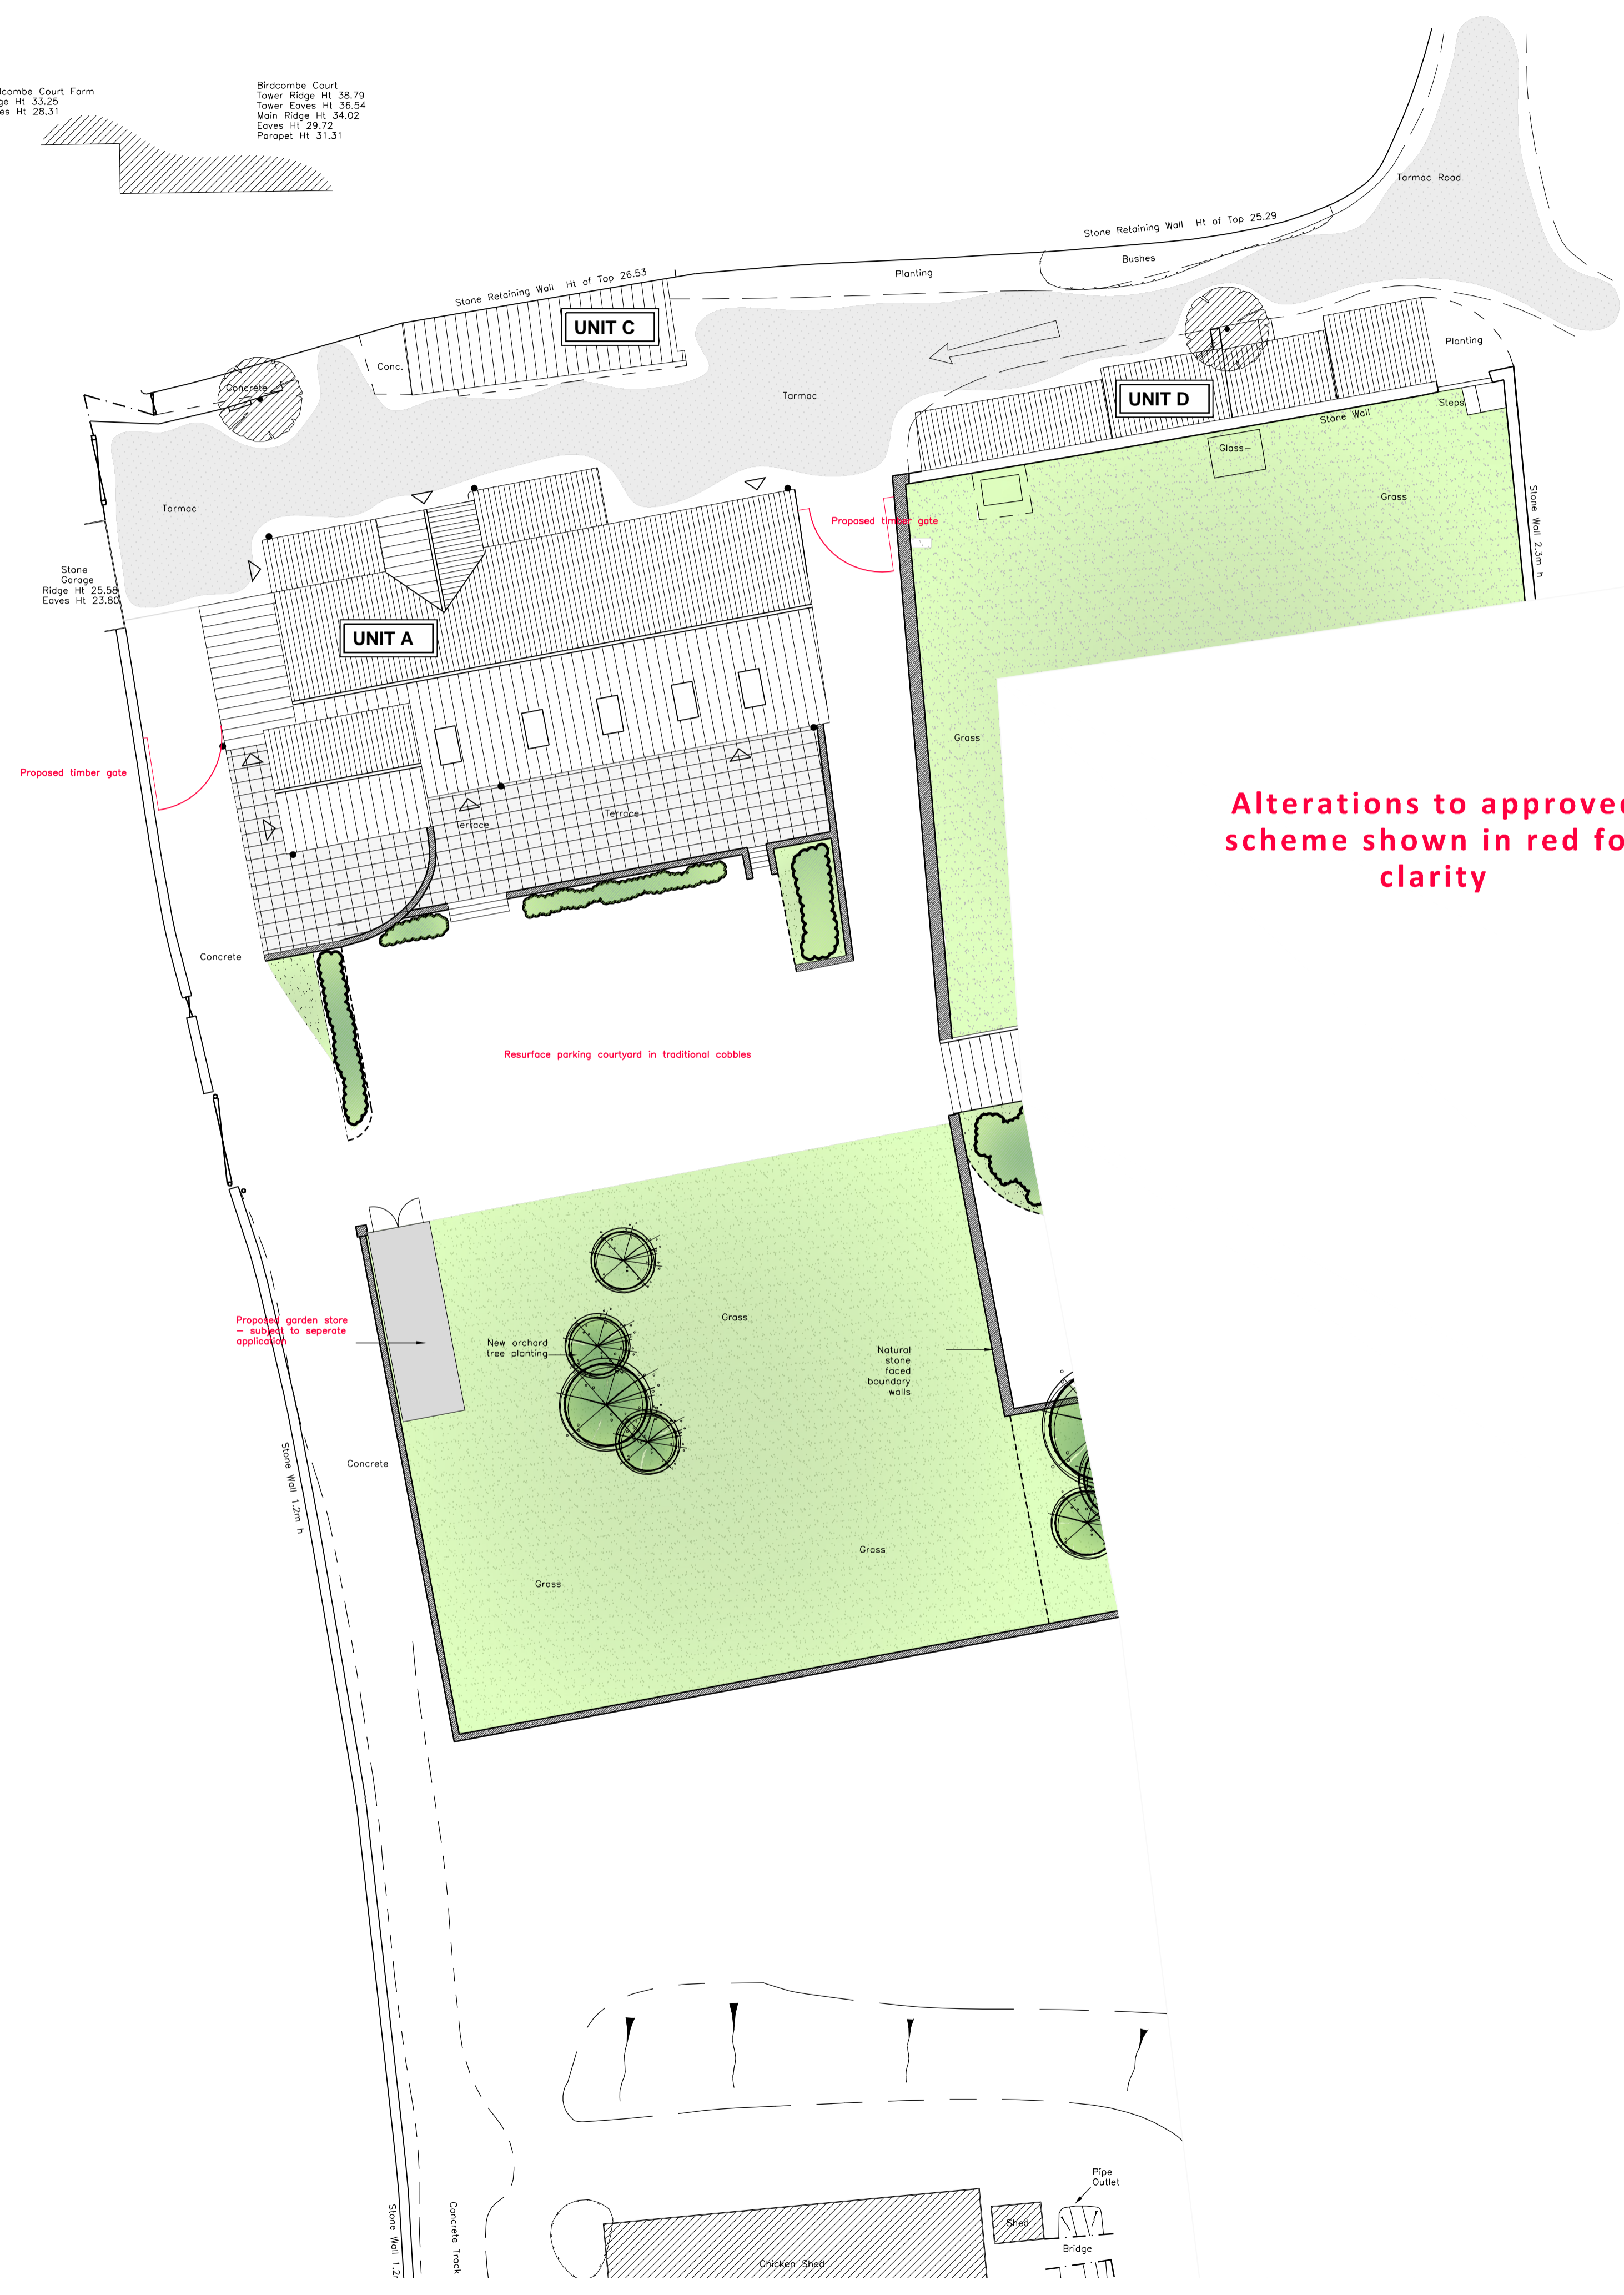

**Alterations to approved  
scheme shown in red for  
clarity**

Notes

Revisions		

Drawn by **EJ** Checked by **HP**  
Project  
**Birdcombe Court Barn,  
Wraxall**

Title  
**Proposed Site Plan**

Status  
**Planning**

**W.H. ARCHITECTS LTD**  
Bookbinder House,  
1 Kingsdown Parade,  
Bristol, BS65UD  
0117 973 5690  
www.wharchitects.co.uk

Date **Nov 2021** Scale **1:200 @ A1**

Ref **1397-21 / 3000 A**