



Elevation D-D

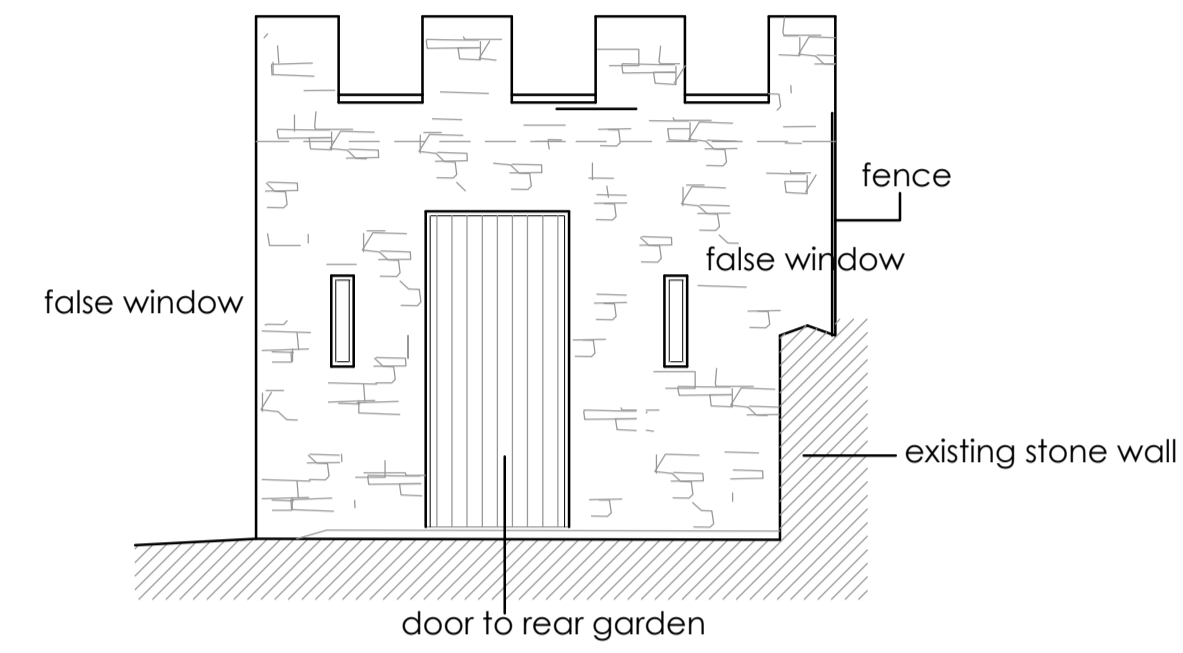

Elevation E-E

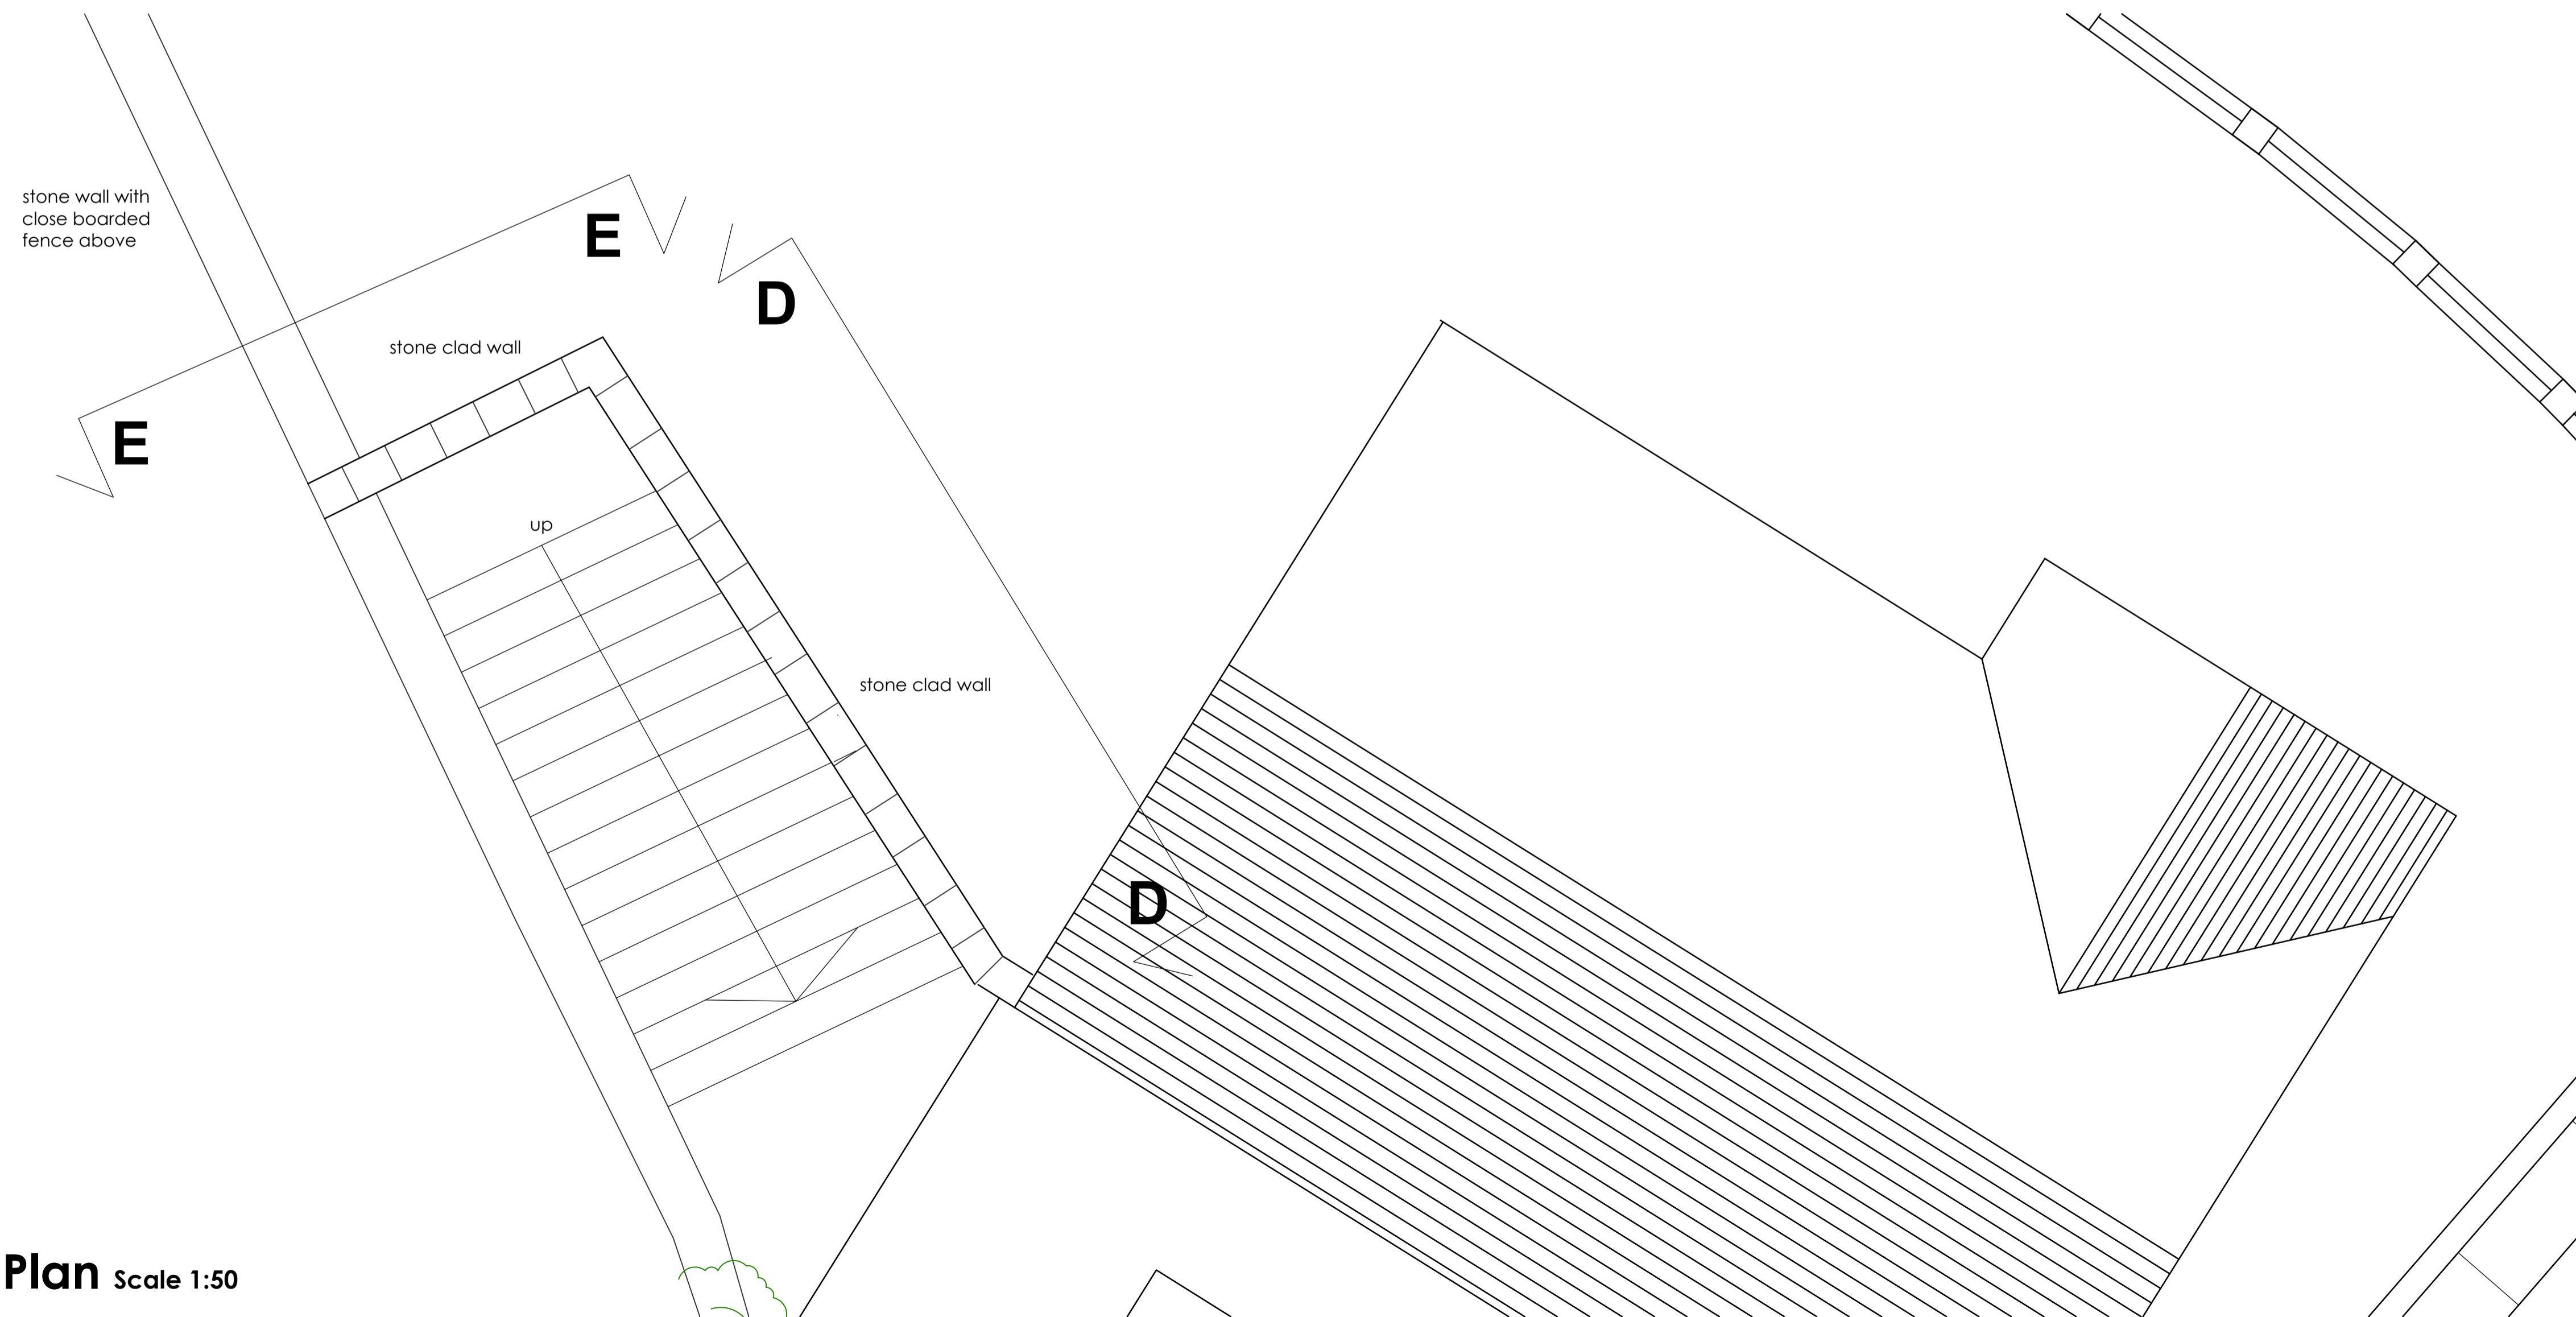

Plan Scale 1:50

Planning

REV No	DATE	DESCRIPTION	BY
A	05.10.22	planning issue	

Project  
**Woodstock House**  
 Mill Lane  
 Haltwhistle  
 NE49 9LW

Drawing Title  
**Rear Yard Wall**  
**(as built)**

scale : 1:50@A1  
 date : 27.09.22  
 drg. no : 2025-PL-20 rev A

**S** Design Services  
 7 Howard Gardens  
 Brampton  
 Cumbria  
 CA8 1AH  
 Tel No 07765 400383

