

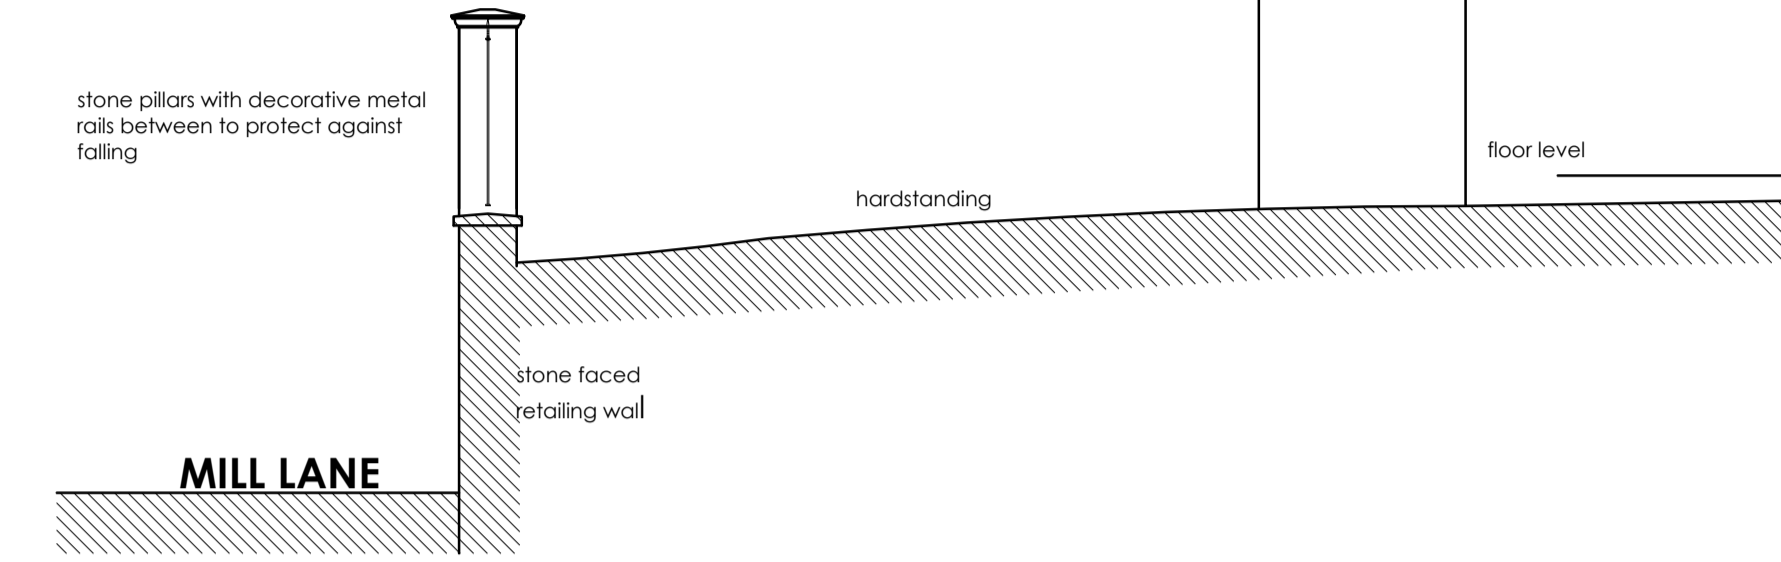


Plan scale 1:200


SCALE 1:200 only 0 1 2 3 4 5 10 15 20 M

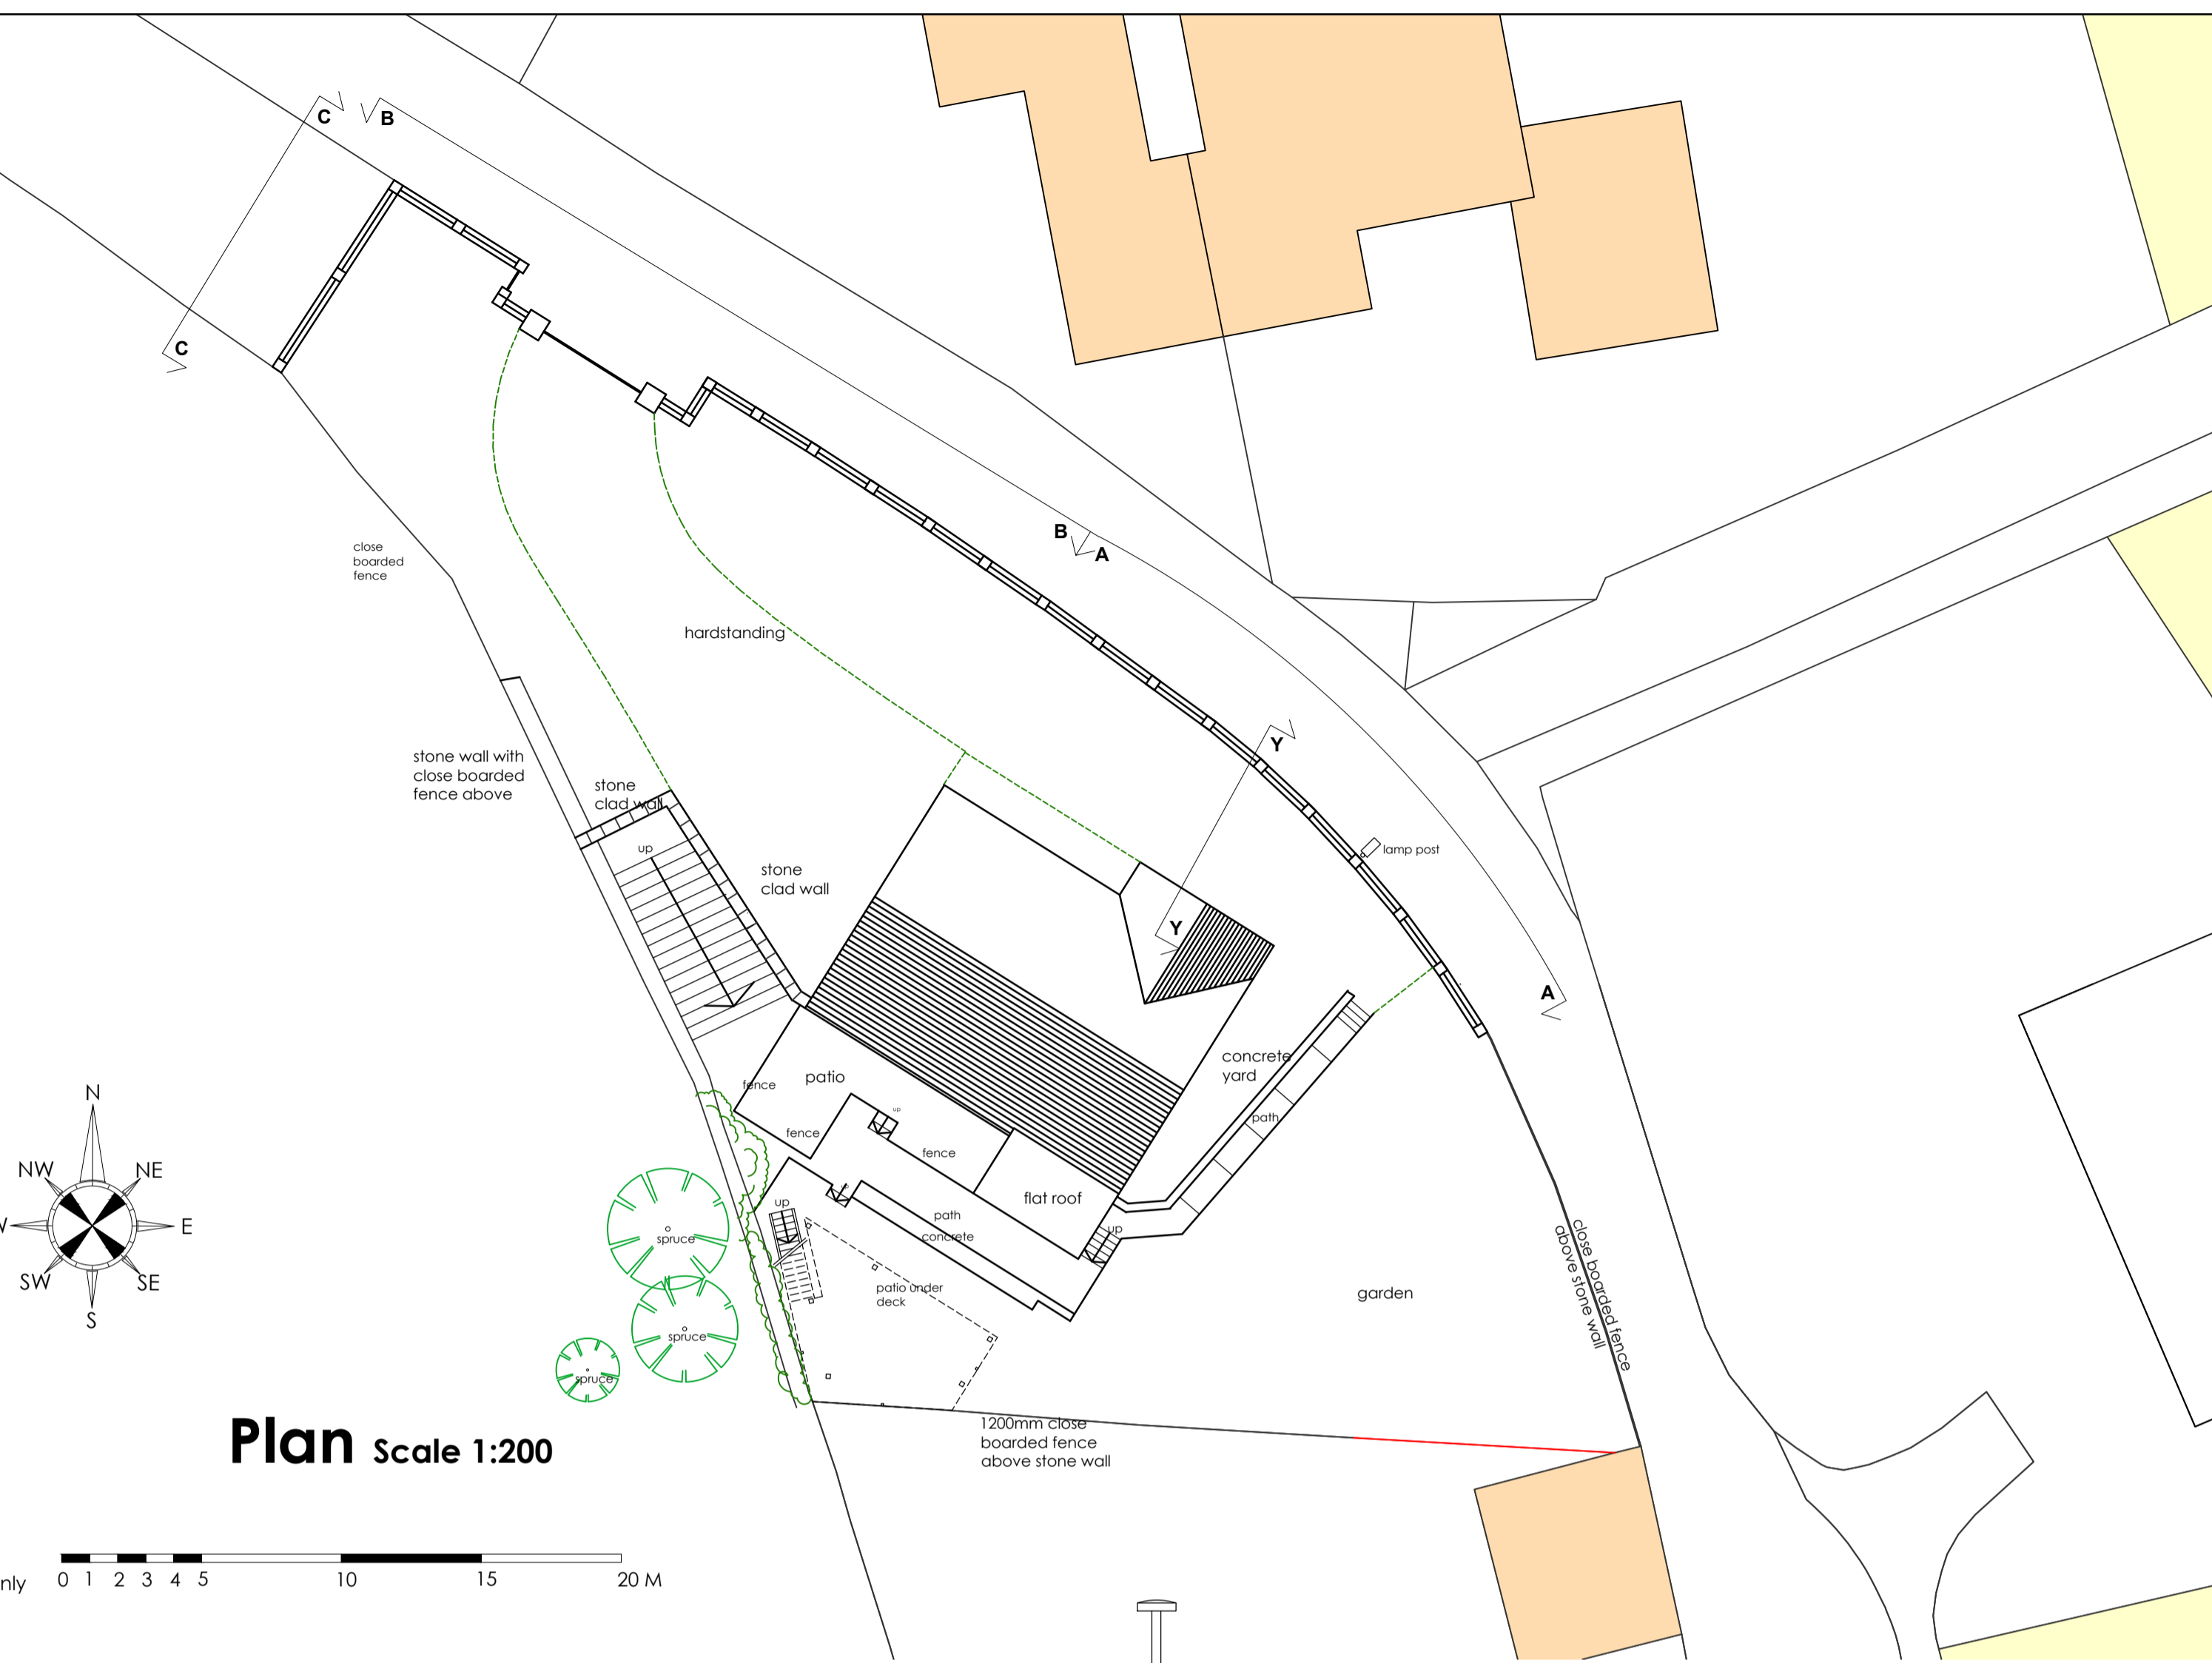


Section Y-Y

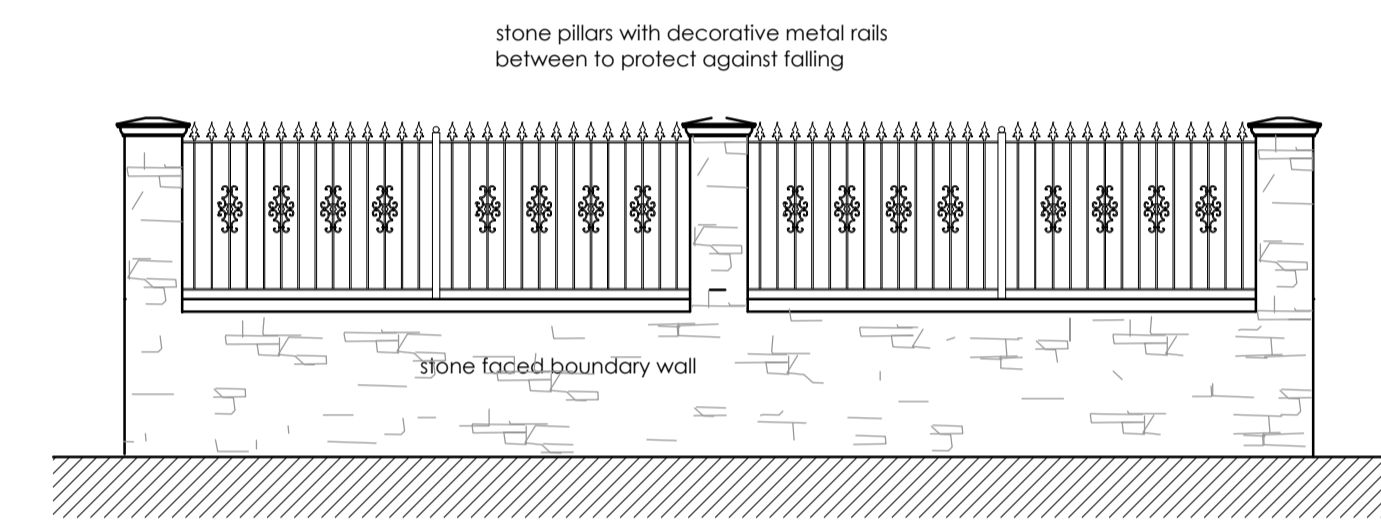

Elevation C-C

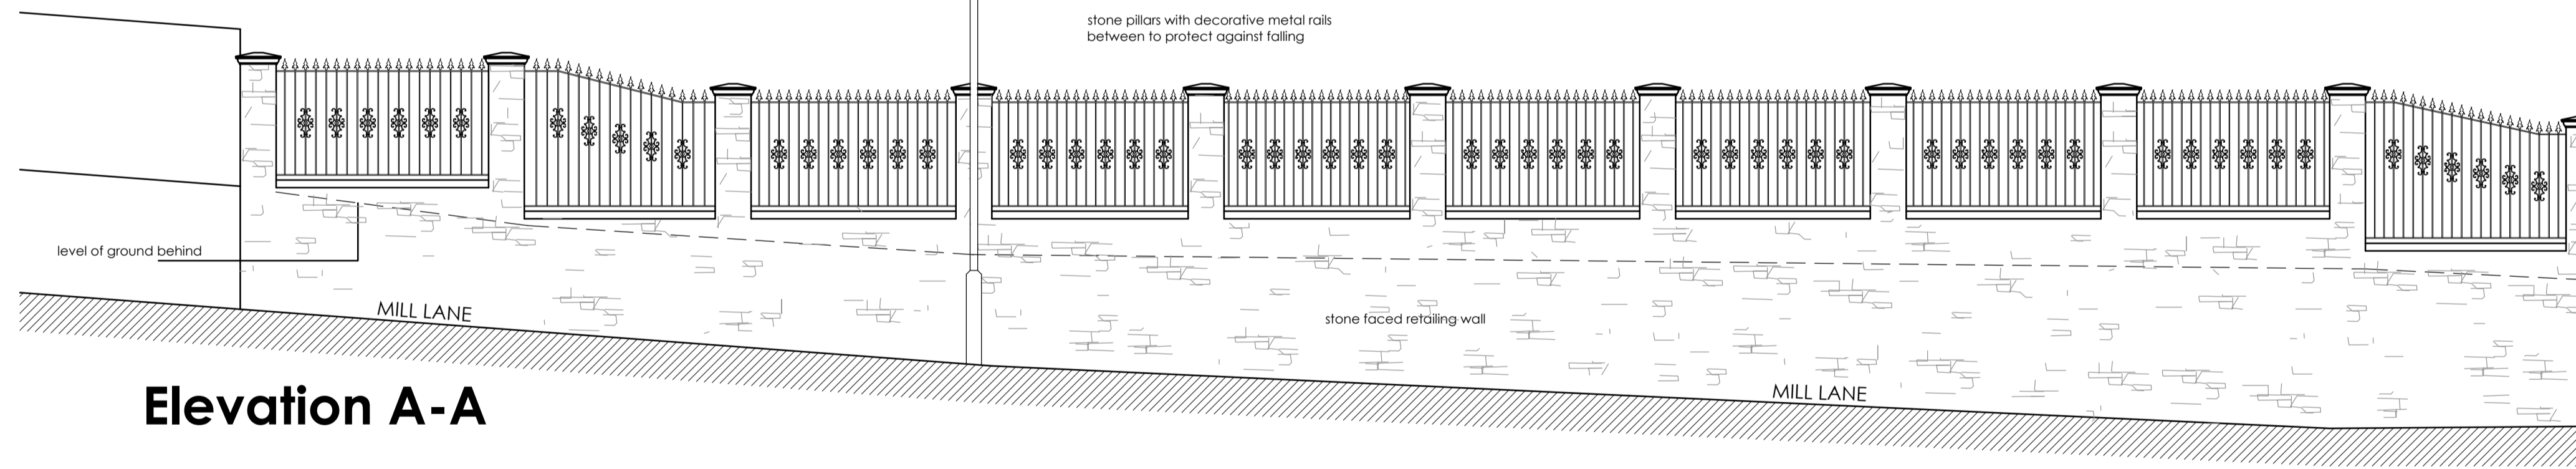

Elevation A-A

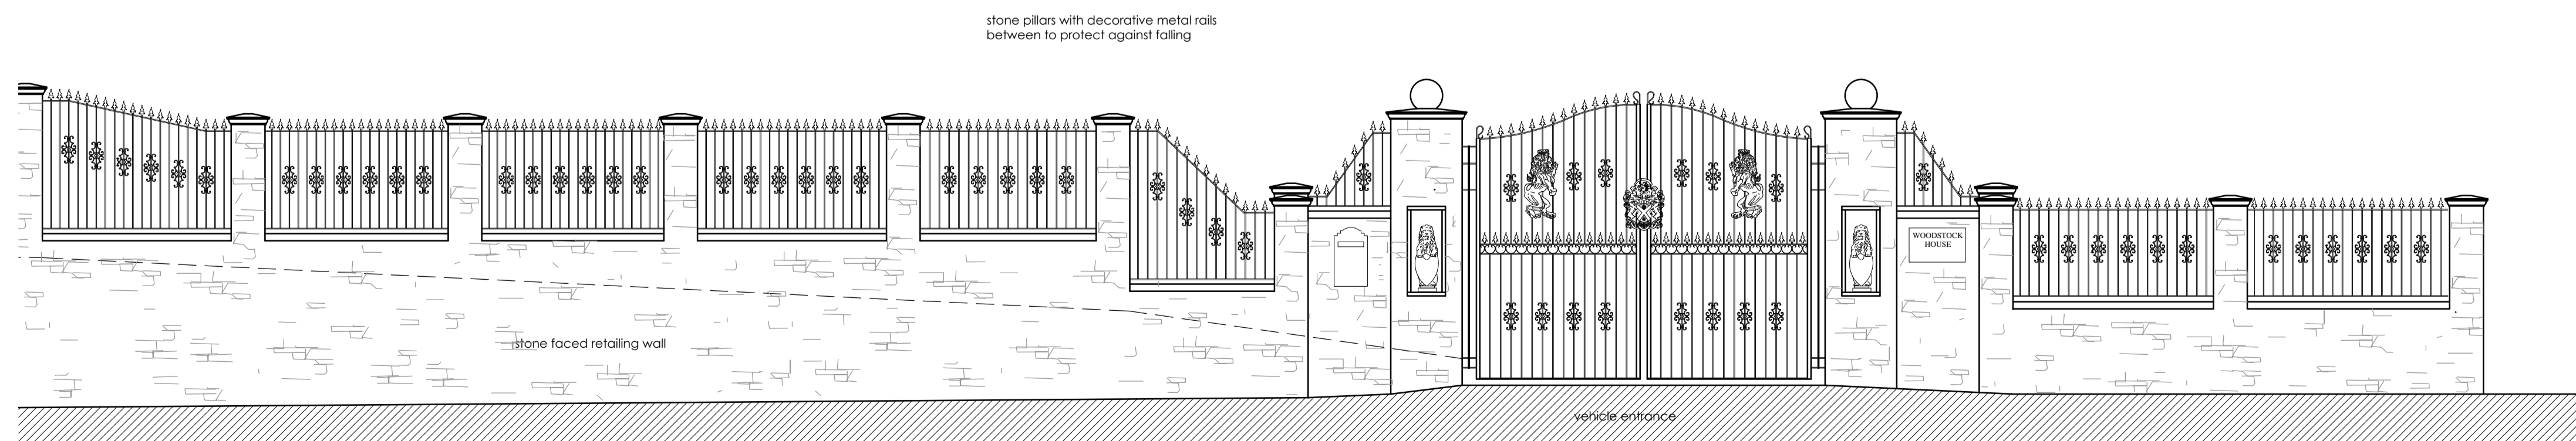

Elevation B-B

SCALE 1:50 only 0 1 2 3 4 5 10

Planning

REV No	DATE	DESCRIPTION	BY
C	22.10.22	add north point	
B	26.10.22	note trees	
A	25.10.22	planning issue	

Project
Woodstock House
 Mill Lane
 Haltwhistle
 NE49 9LW

Drawing Title
Boundary Wall
 (as built)

scale : 1:50 & 1:200@A1
 date : 27.09.22
 drg. no : 2025-PL-21 rev C

S Design Services
 7 Howard Gardens
 Brampton
 Cumbria
 CA8 1AH
 Tel No 07765 400383