

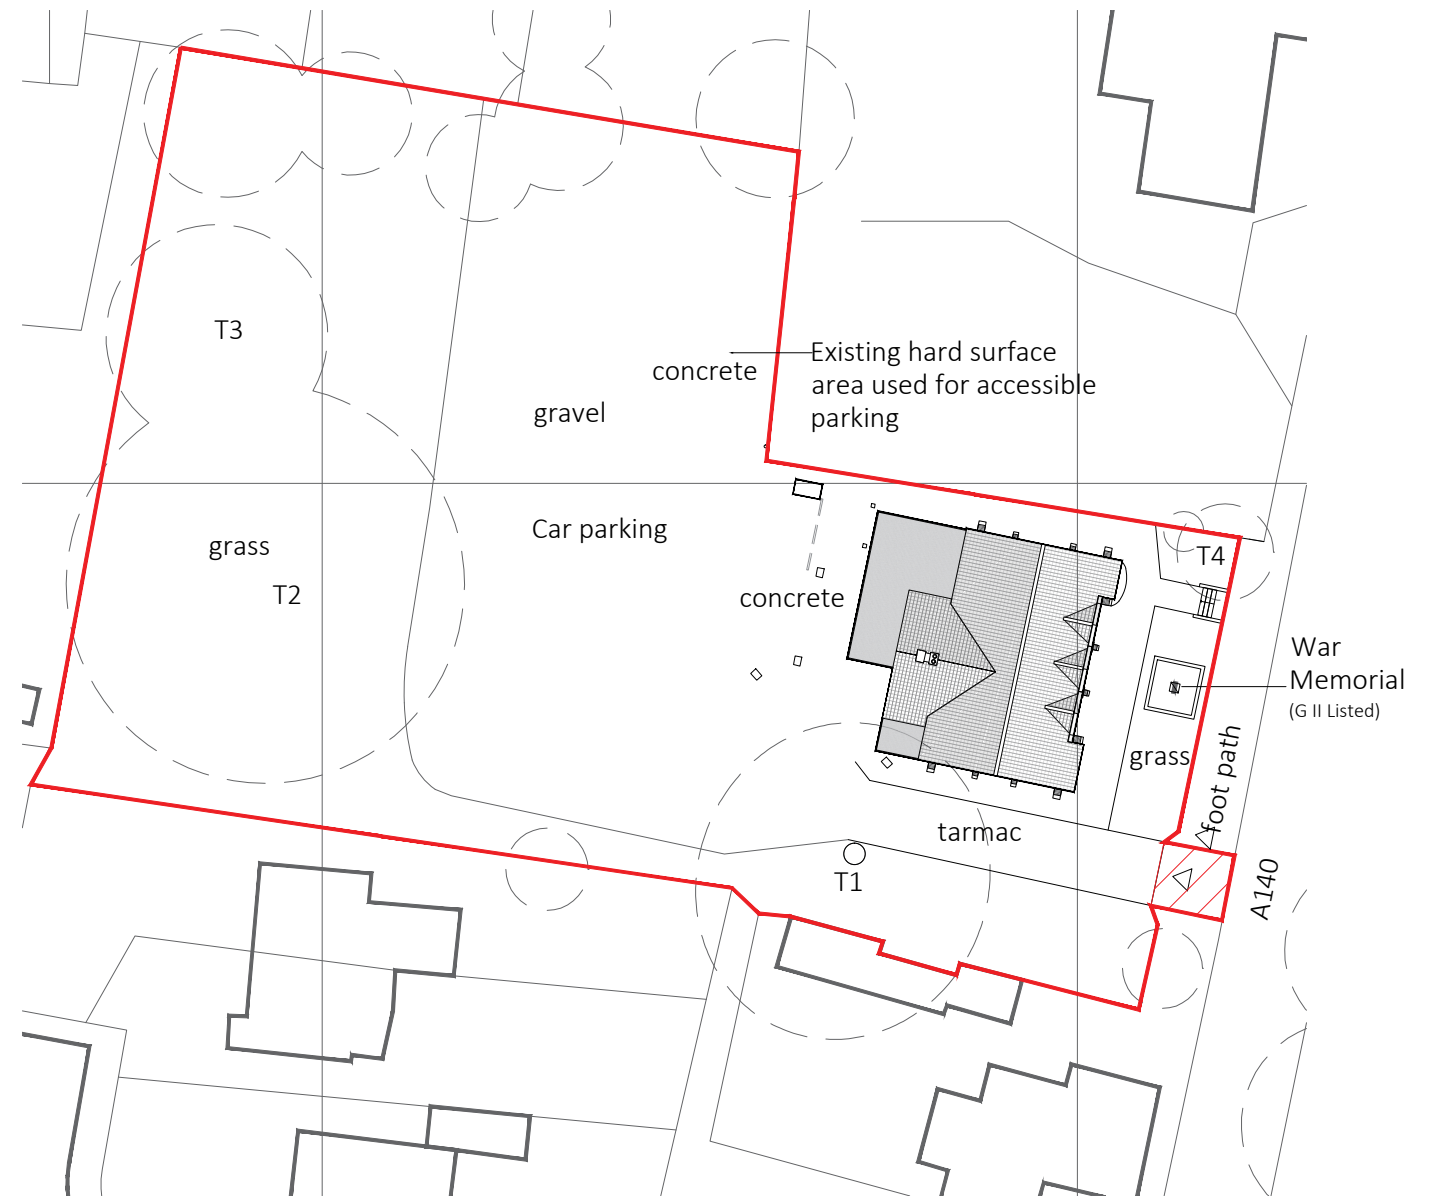


Roof Plan

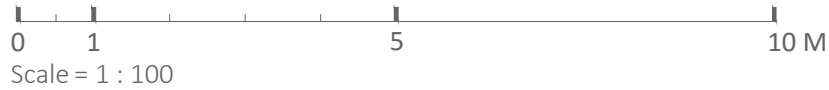

Existing Site Plan

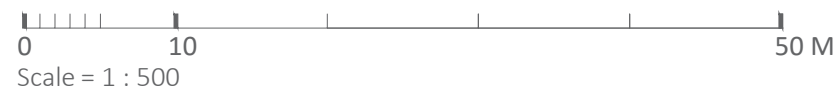

Project Rear Extension and Remodel
Long Stratton Village Hall
Client A. Phillips
Drawing Existing Roof and Site Plan
Number SK 102 B
Scale 1:100 @ A3
Status Planning
Revision Issue B : 11 11 2022

**wilde
&
wilde**
Architecture

www.wildeandwilde.com
01508 493 369
Architecture/ Interior Design/ Workplace

The UEA Enterprise Centre
University Drive
Norwich
Norfolk NR4 7TJ



Architects Registration Board
Registered Design & Construction Architect

Revised red line
boundary as SNDC
requirements