






EAST ELEVATION

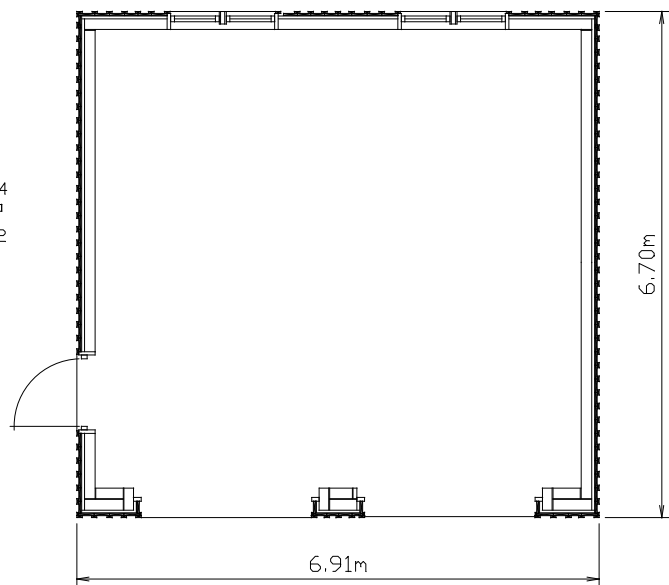


FLOOR PLAN

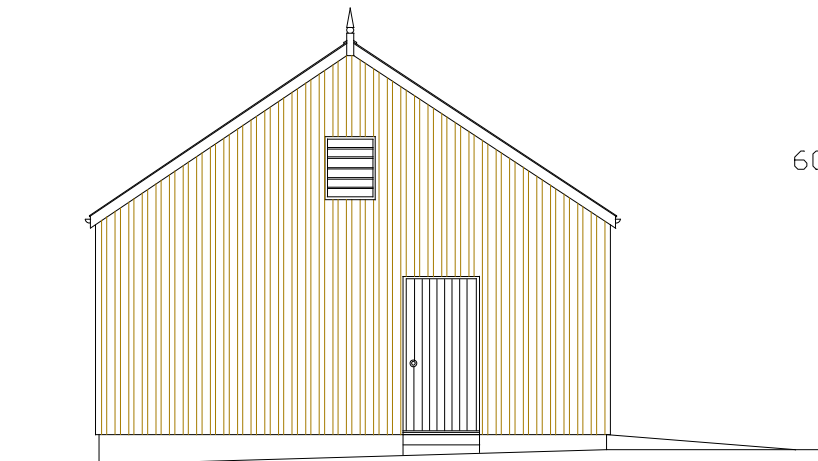


SOUTH ELEVATION

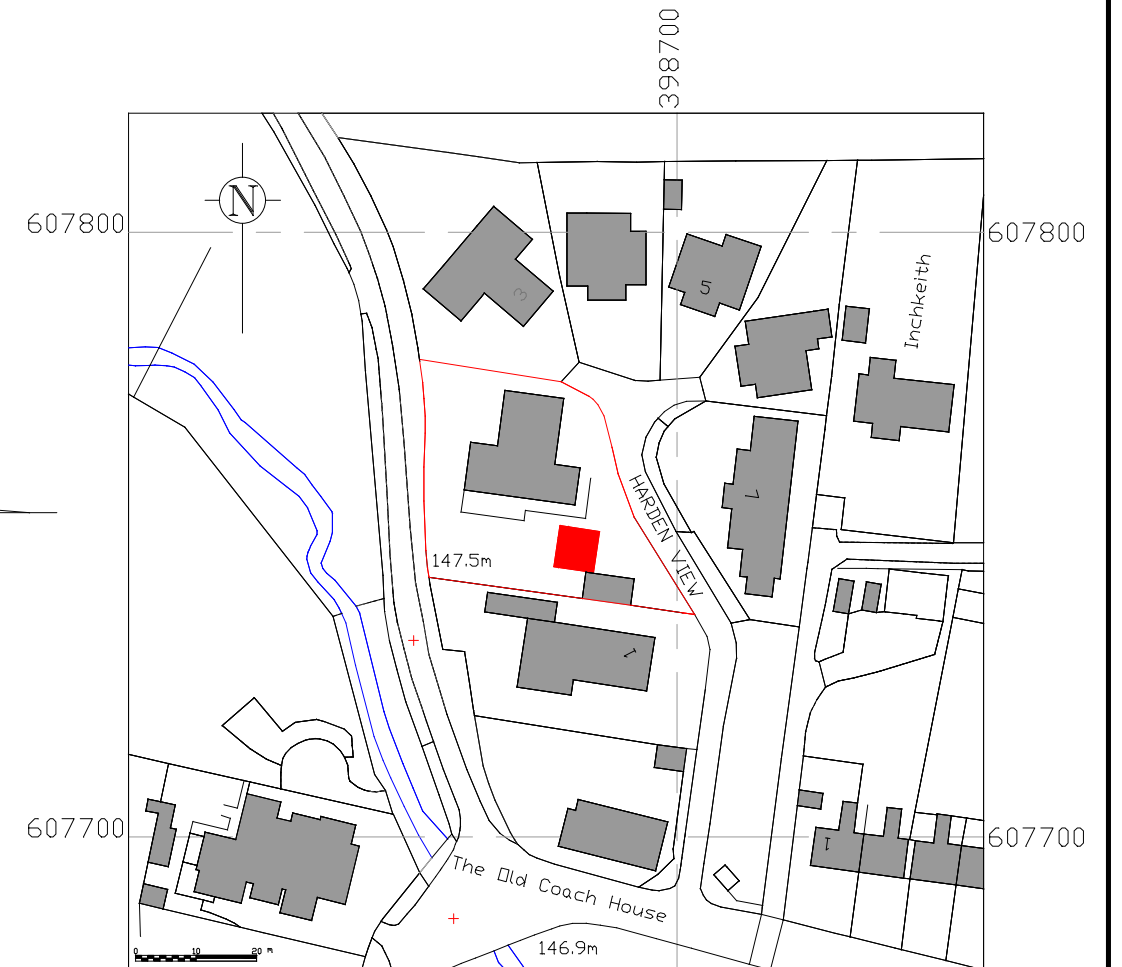


LOCATION PLAN 1:1250 @ A3
OS Ref NT986077
W3W offers:crash:defrost

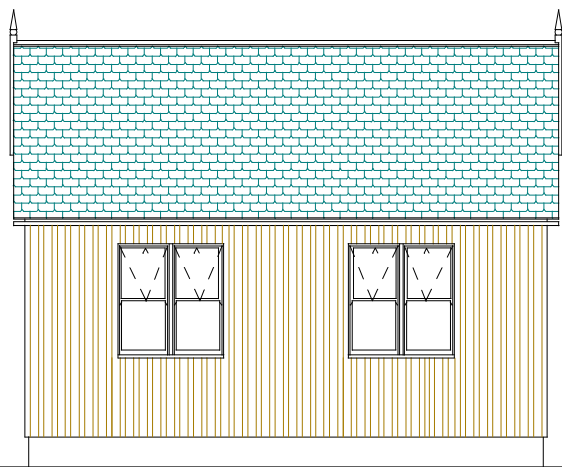

WEST ELEVATION

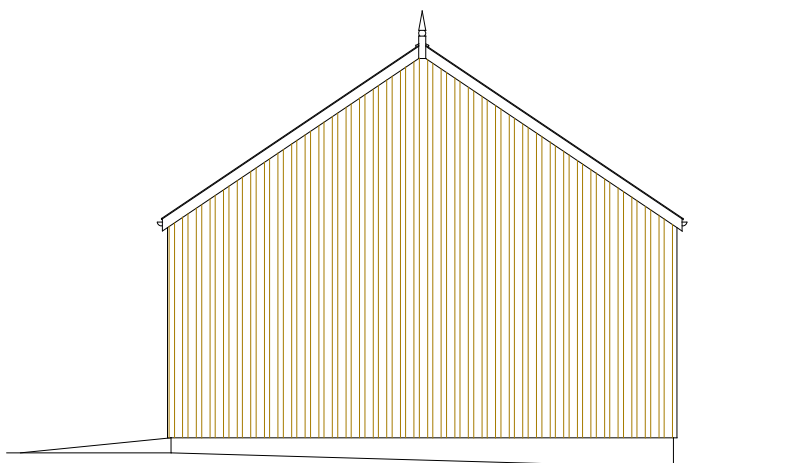

NORTH ELEVATION

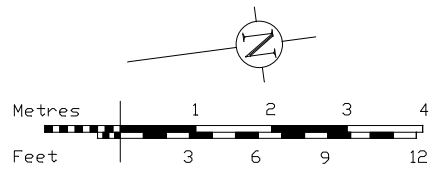

GENERAL SPECIFICATION

DOUBLE GARAGE

Site
Finished floor level to be raised above any ground surface water to be determined on site

Roof
Blue/grey slate

Walls
Vertical rough sawn treated softwood on timber frame and inner concrete block.

Windows
Double glazed in treated timber frames

Bat loft void
Untreated larch timber frame and louvres spaced to allow access to untreated timber lined loft.

Door
Braced and framed timber personnel door.

Do not scale from drawing.
Check on site and report any variation

Double Garage at
No2 Harden View, Netherton,
Northumberland, NE65 7HE
for
Mr K Fair

As built elevations and plan
General specifications
Scale 1:100 @ A3
Date 01/12/2022

DRAWING NUMBER
2022/931/10r1