

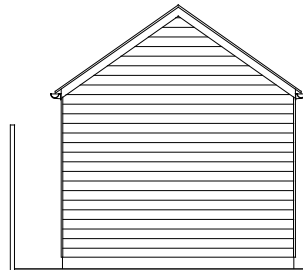



SOUTH ELEVATION TO HOUSE PRIOR TO BUILD

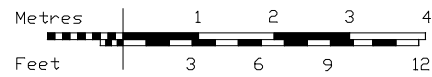


EAST ELEVATION TO HOUSE & SHED PRIOR TO BUILD

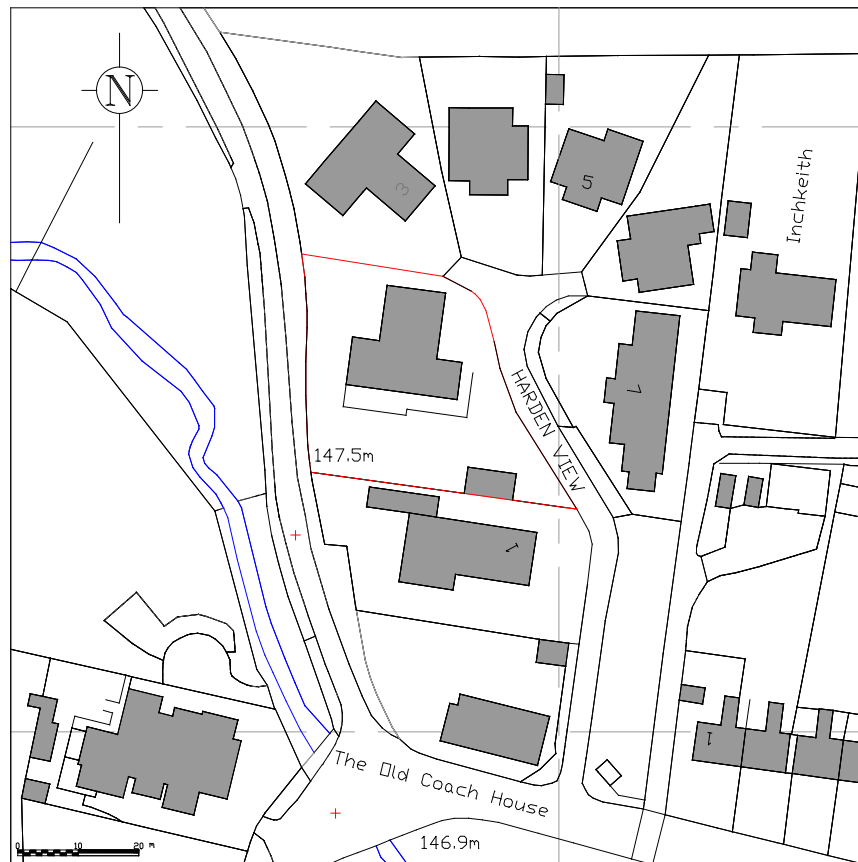

PRIOR TO BUILD LOCATION PLAN 1:1250 @ A3  
OS Ref NT986077

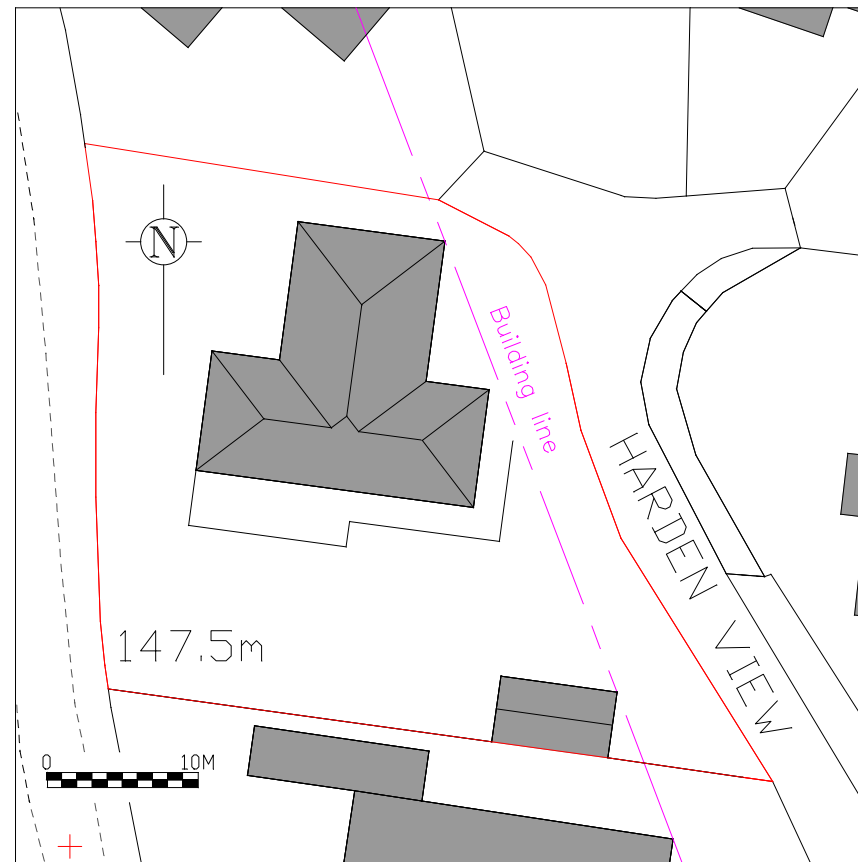

PRIOR TO BUILD BLOCK PLAN 1:500 @ A3  
OS Ref NT986077

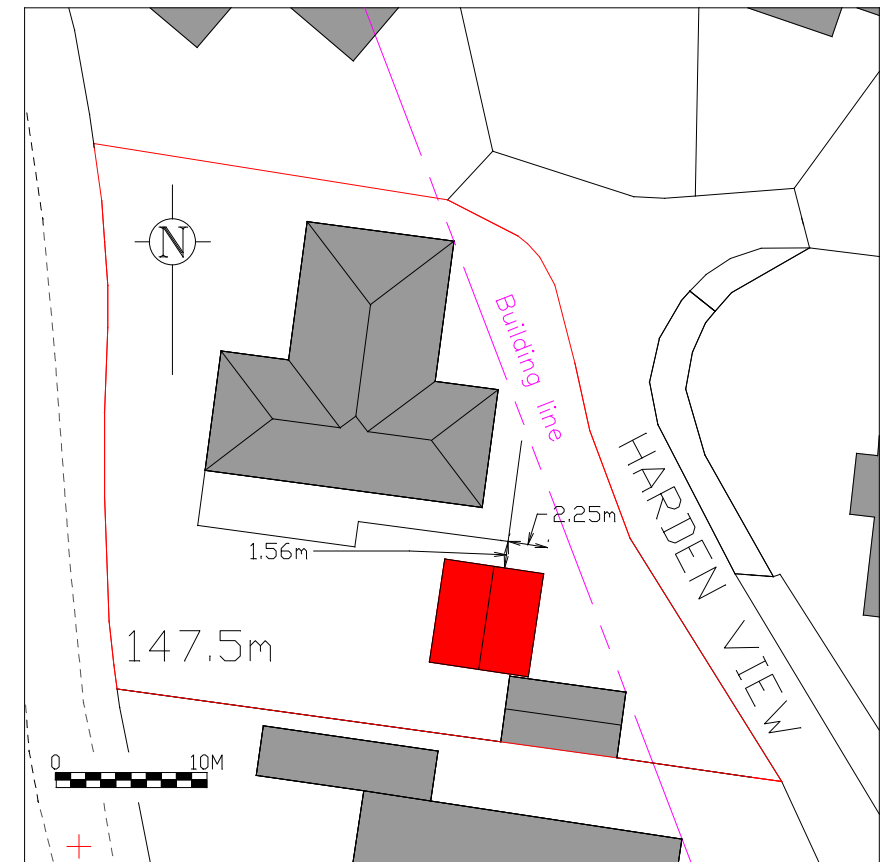

AS BUILT BLOCK PLAN 1:500 @ A3  
OS Ref NT986077

Double Garage at  
No2 Harden View, Netherton,  
Northumberland, NE65 7HE  
for  
Mr K Fair

As prior to build elevations  
and plan General specifications  
Scale 1:100 @ A3  
Date 01/12/2022

DRAWING NUMBER  
2022/931/11r1