

North Elevation, AS BUILT.





North Elevation, Proposed.



Section

Dormer removed and replaced with matching natural slates and 'Conservation' rooflights (Velux).

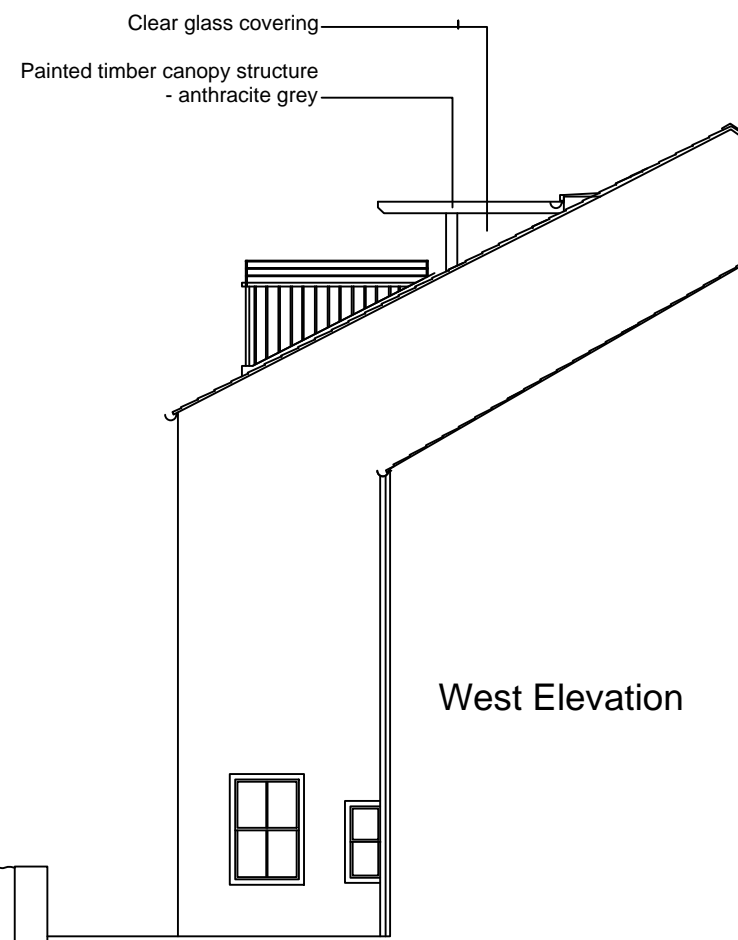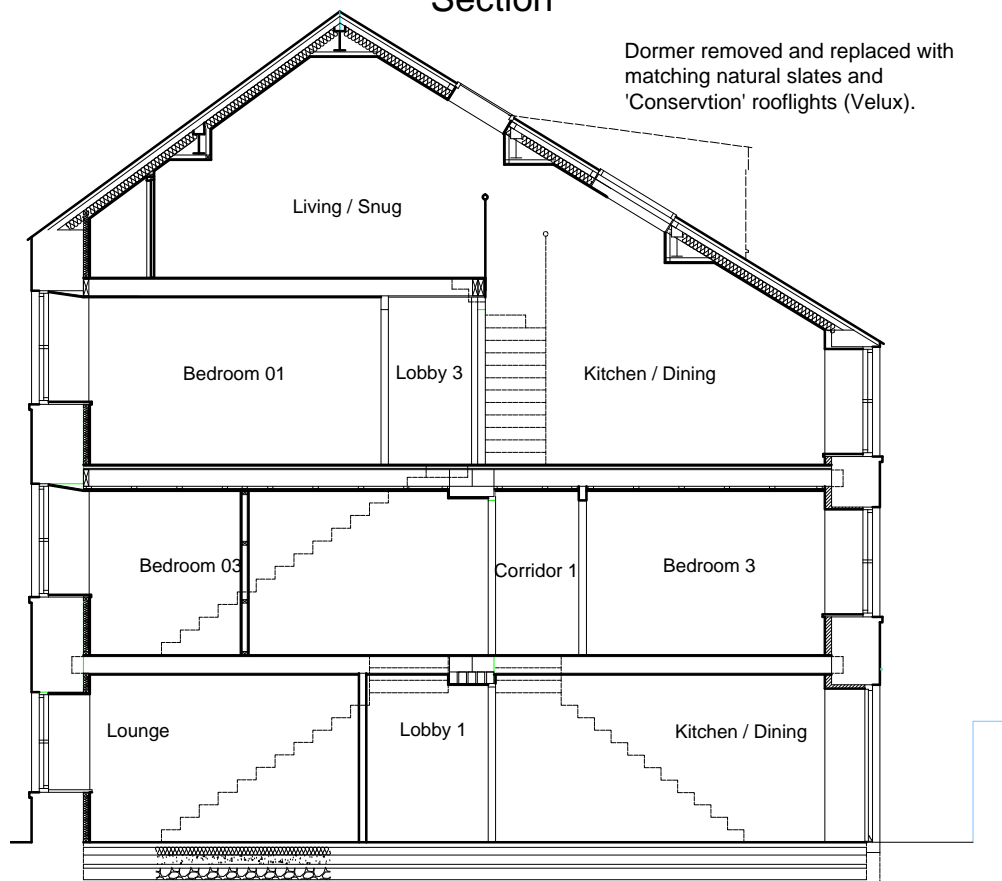

West Elevation

DOONAN ARCHITECTS
 16 Hallstile Bank Hexham Northumberland NE46 3PQ
 Phone: 01434 601020 mail@doonanarchitects.co.uk

Project name Dale Hotel Amendments to approved plans		
Date Dec 2022	Drawn by KSG/KLD	Scale 1:100@A3
Job no 1439	Drawing no PP10	Rev

For
Linda and Tony Beck

Drawing title
Proposed elevations

Discrepancies, ambiguities and/or omissions between this drawing and information given elsewhere must be reported to the architect before proceeding.
 This drawing is copyright.
 Dimensions must be checked on site.
 Do not scale off dimensions from this drawing.

