



EXISTING FLOOR PLAN
Scale 1:100@A1



EXISTING ROOF PLAN
Scale 1:100@A1

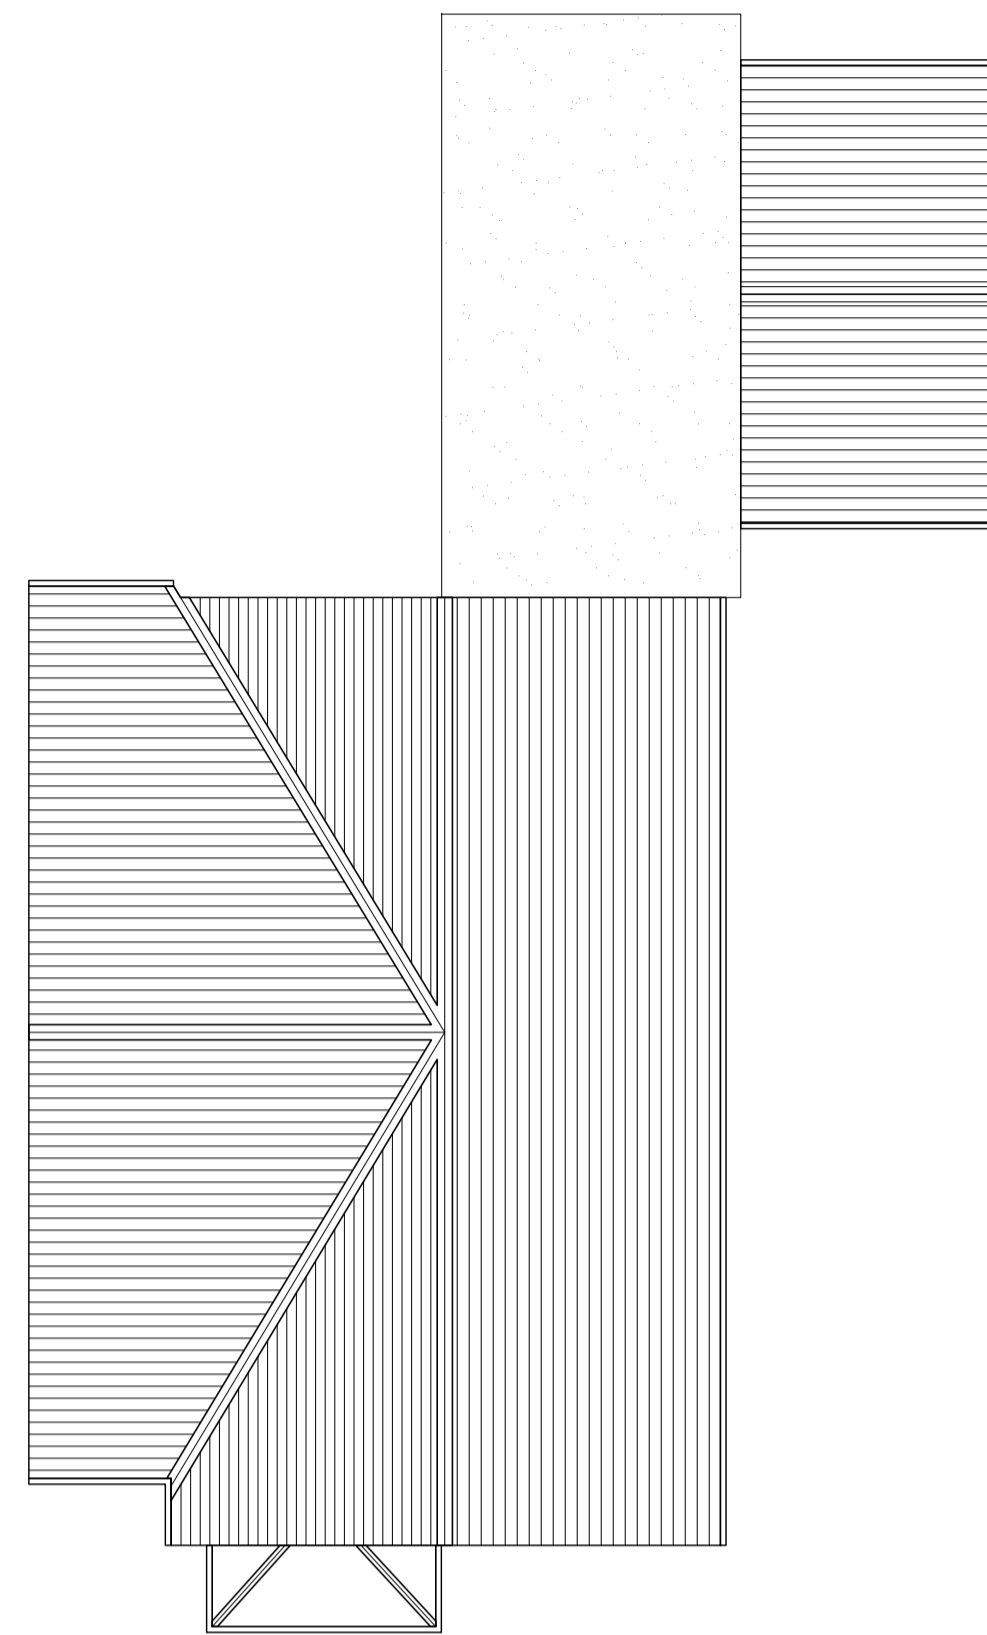


EXISTING FRONT ELEVATION
Scale 1:100@A1

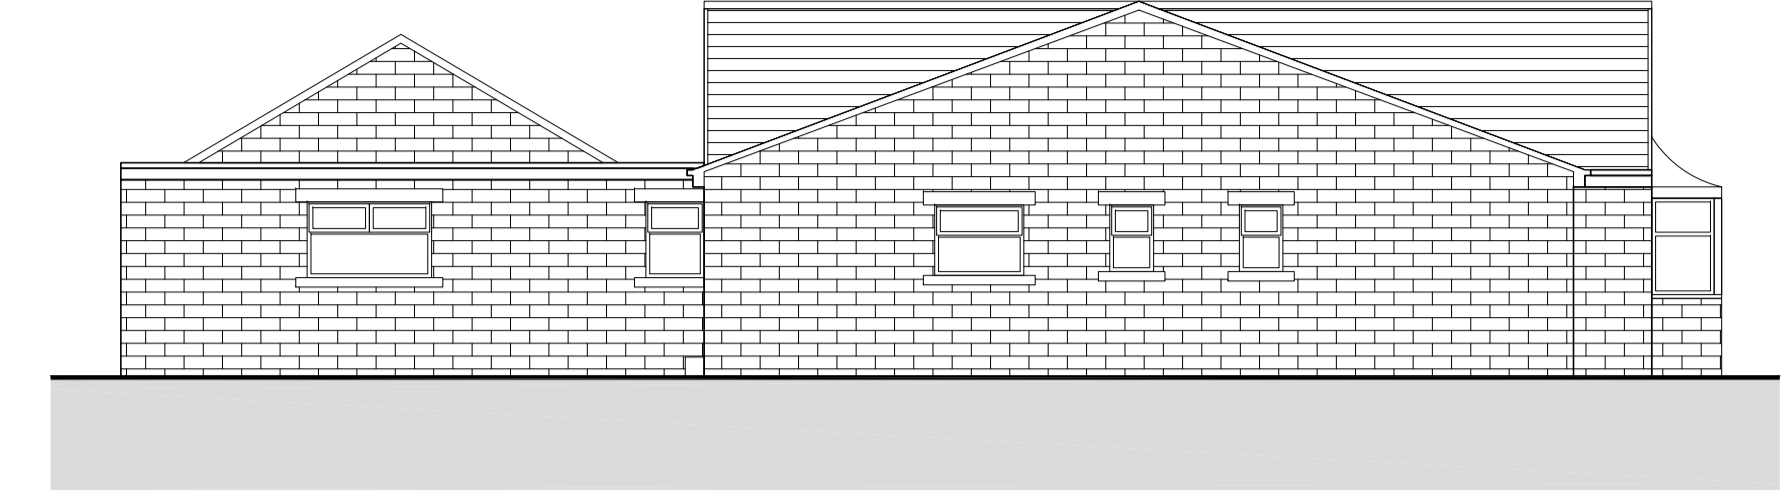


EXISTING SIDE ELEVATION
Scale 1:100@A1




EXISTING REAR ELEVATION
Scale 1:100@A1

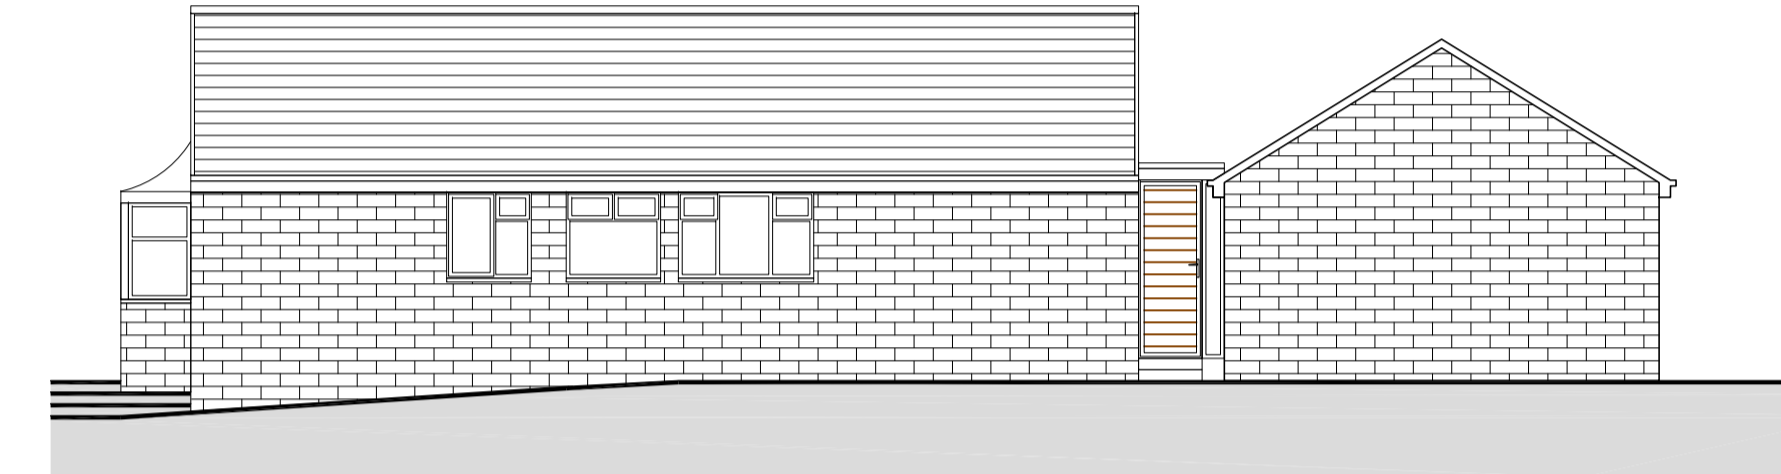

EXISTING OTHER SIDE ELEVATION
Scale 1:100@A1

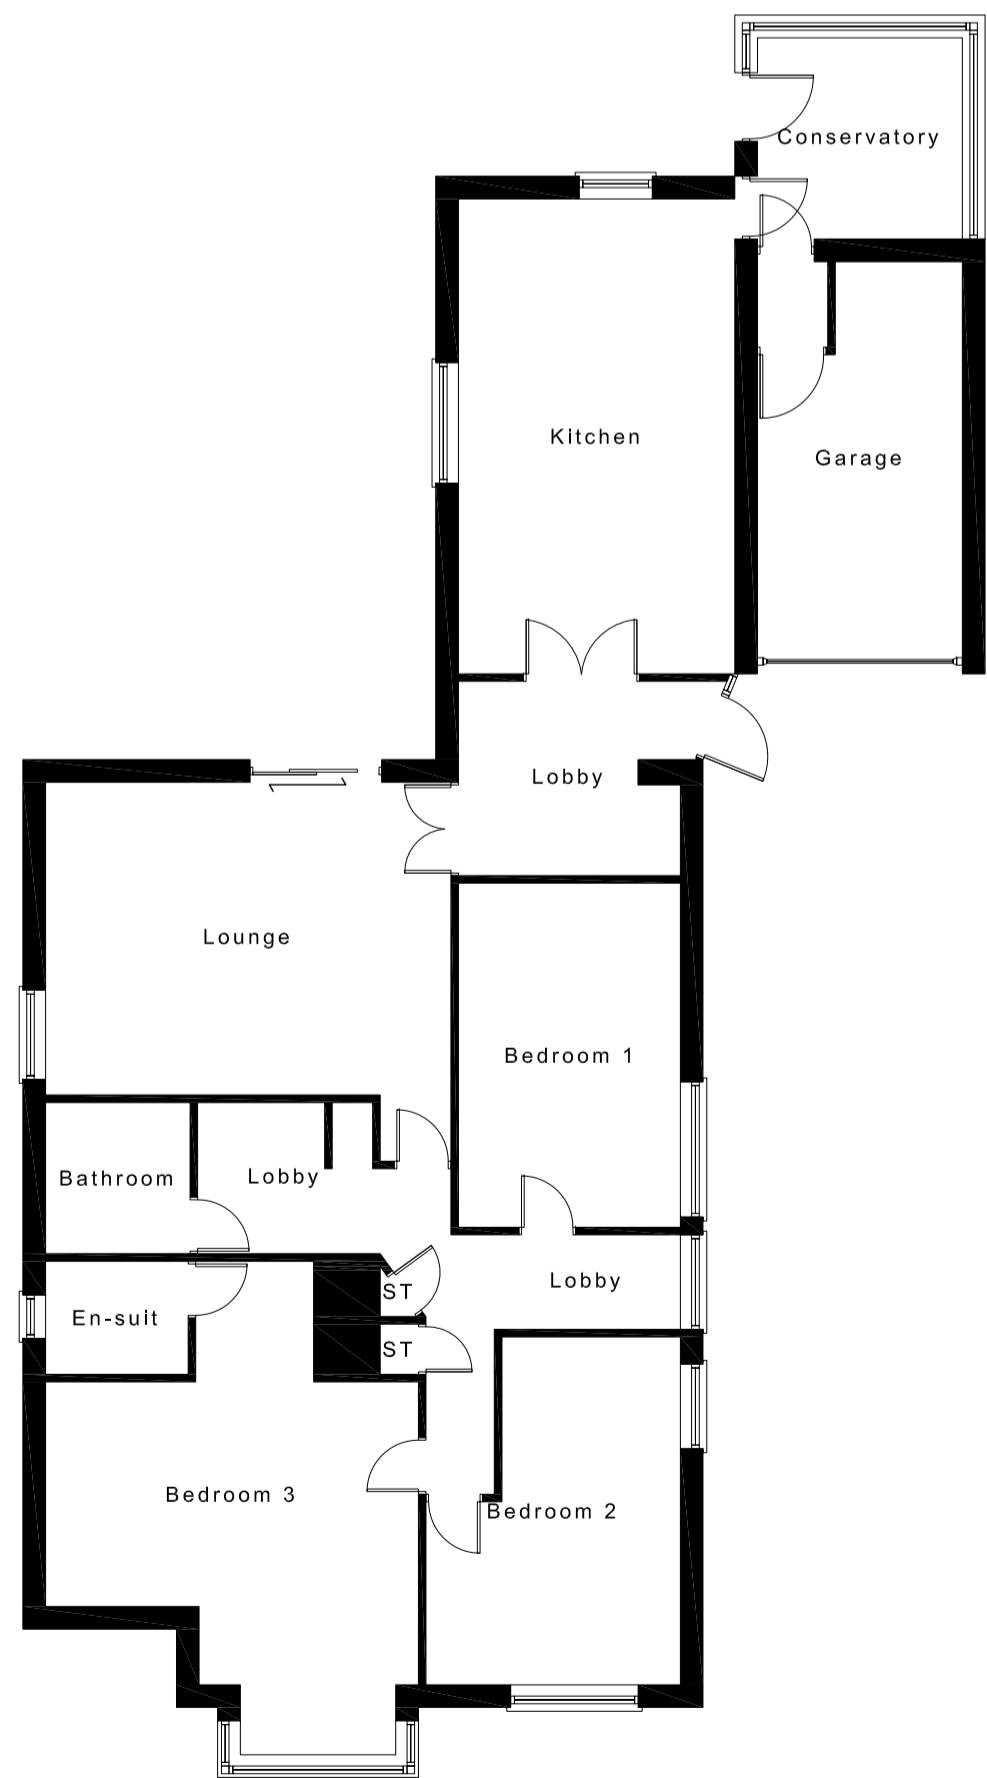


AS BUILT FLOOR PLAN
Scale 1:100@A1

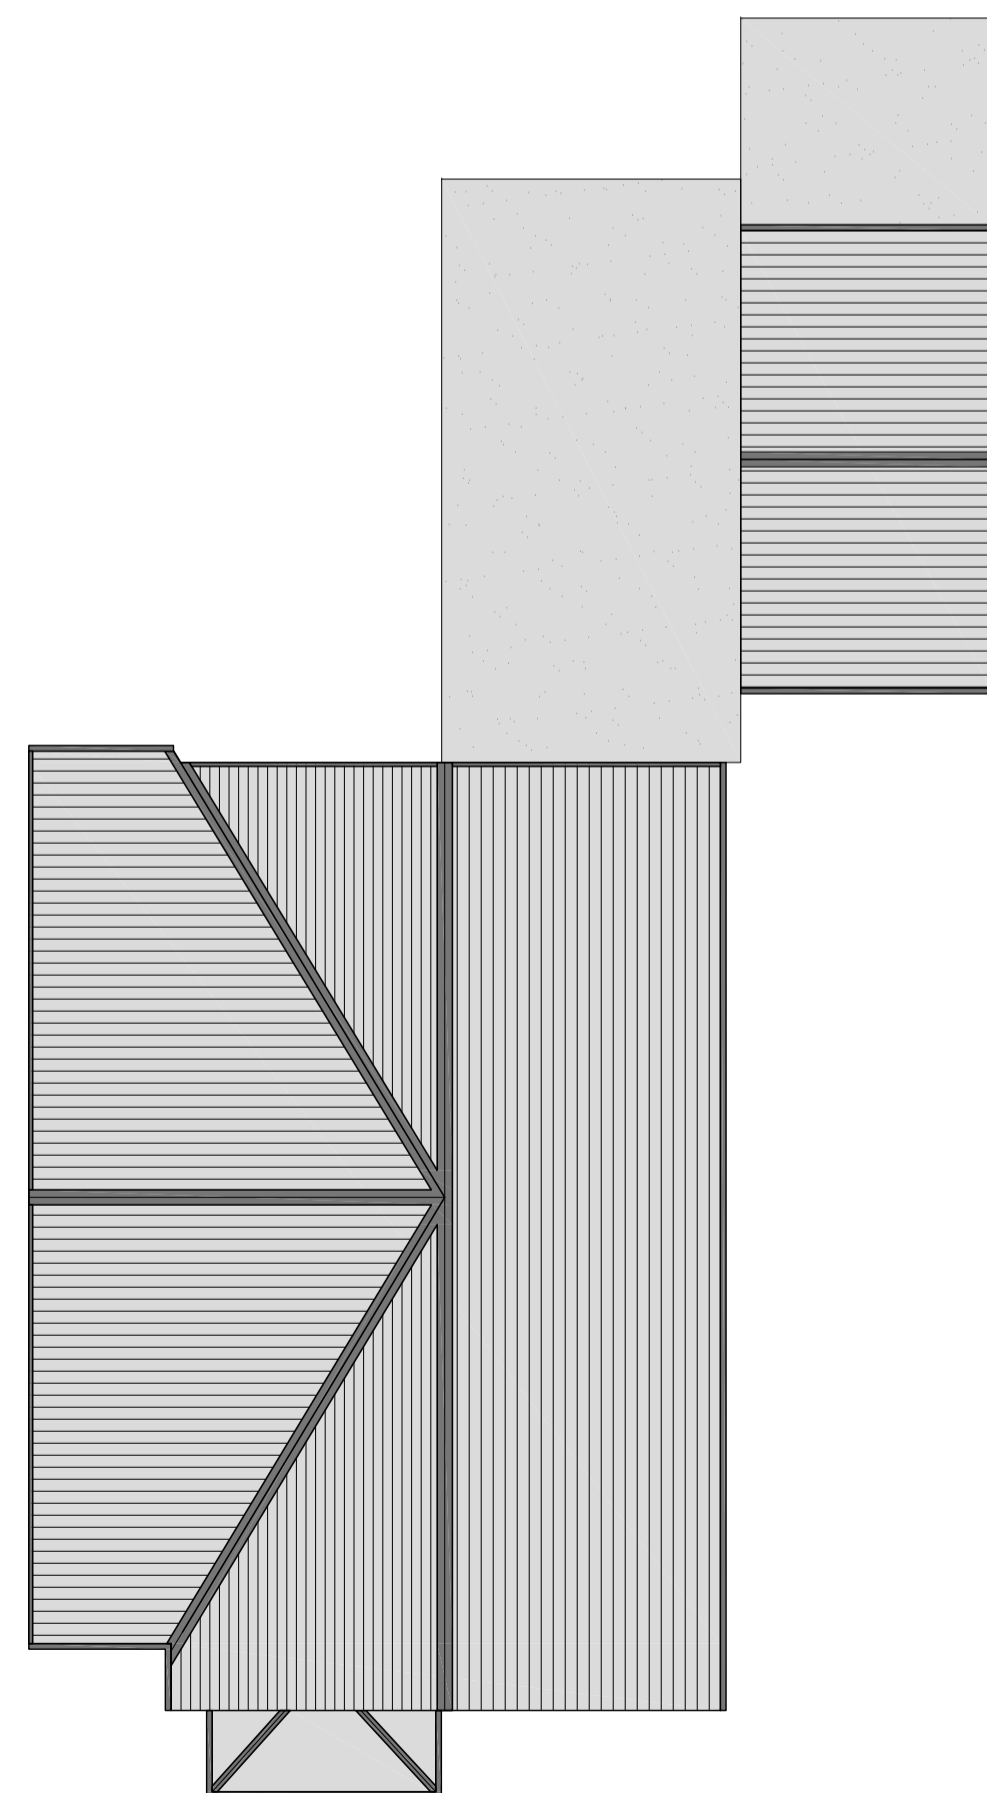

AS BUILT ROOF PLAN
Scale 1:100@A1



AS BUILT FRONT ELEVATION
Scale 1:100@A1

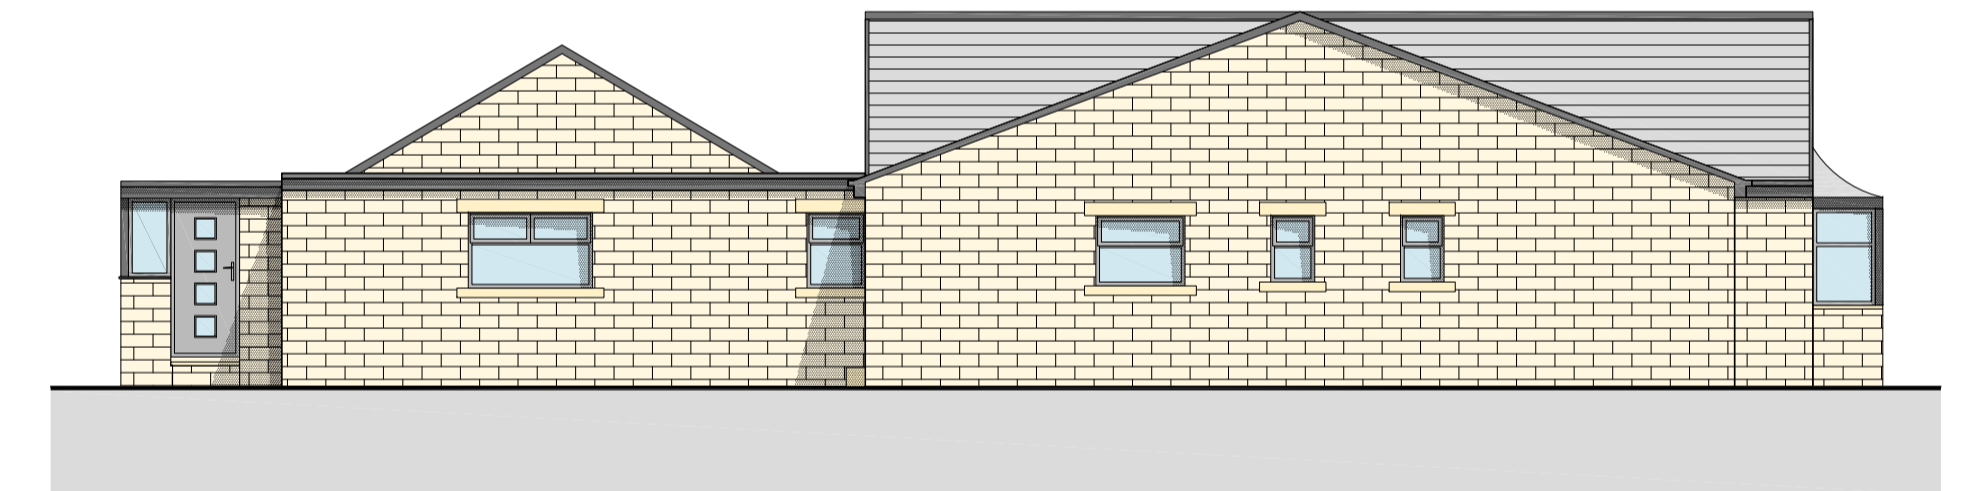

AS BUILT SIDE ELEVATION
Scale 1:100@A1



AS BUILT REAR ELEVATION
Scale 1:100@A1



AS BUILT OTHER SIDE ELEVATION
Scale 1:100@A1

NOTE: Do not scale drawing. Work to figured dimensions. This drawing has been prepared for planning purposes only and is to be read in conjunction with all other relevant specialist drawings, details and specifications. All works are to be carried out in accordance with the latest edition of the Building Regulations and any amendments, together with all relevant British Standards and codes of practice. All dimensions unless stated otherwise are in millimetres. All dimensions and levels are to be checked by the contractor on the job in order. Identification or commencement of work on site. Contractor to check and satisfy himself of the positions of all existing statutory authorities make services on and around site. All materials and proprietary items are to be fixed/installed/applied in full accordance with the respective manufacturers recommendations. At all stages of work, the contractor shall be responsible for and must ensure the overall stability of all buildings, structures and excavations etc. is maintained. During the construction works all existing fire drainage is to be adequately protected and normal flows maintained.

Issue Purpose : Householder Planning Application

Client	N/A	Drawn	NS
Project	Retrospective Conservatory	Date	22-11-2022
		Scale	1:100 @ A1
Address	2 Damsion Court, Bradford, BD14 6NL	Stage Identification	
		Design - D	Sketch Scheme - SK
Title	Existing and As built Plans and Elevations	Planning - P	Construction - C

Rev - : DD-MM-YYYY : Initial : Issue.
Drawing Number 22-145 - P - 02

Faum Architecture
Studio 2,
First Floor,
610 Leeds Road,
Bradford,
BD3 9TY
01274 928259
www.faumarchitecture.co.uk

