


FRONT ELEVATION
(AS BUILT)


RIGHTSIDE ELEVATION
(AS BUILT)

REAR ELEVATION
(AS BUILT)


LEFT SIDE ELEVATION
(AS BUILT)

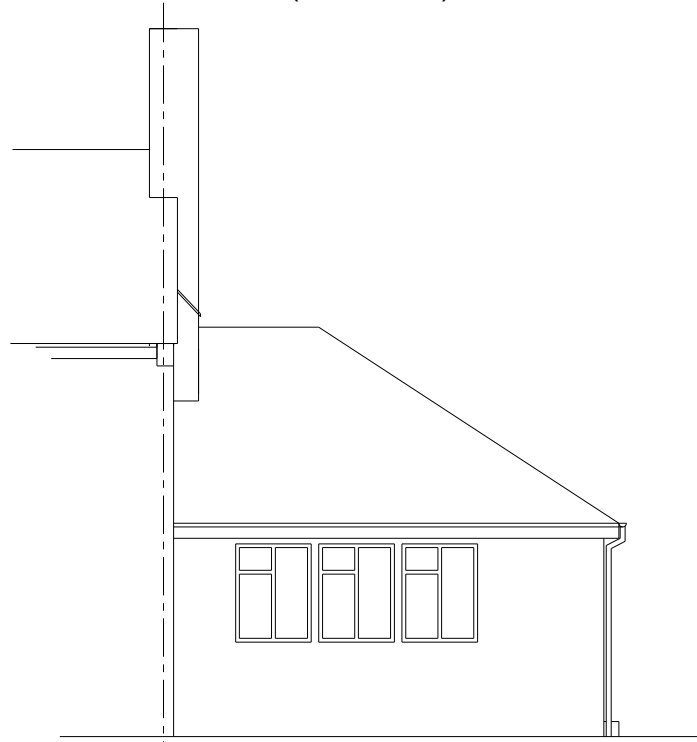


FRONT ELEVATION
EXISTING

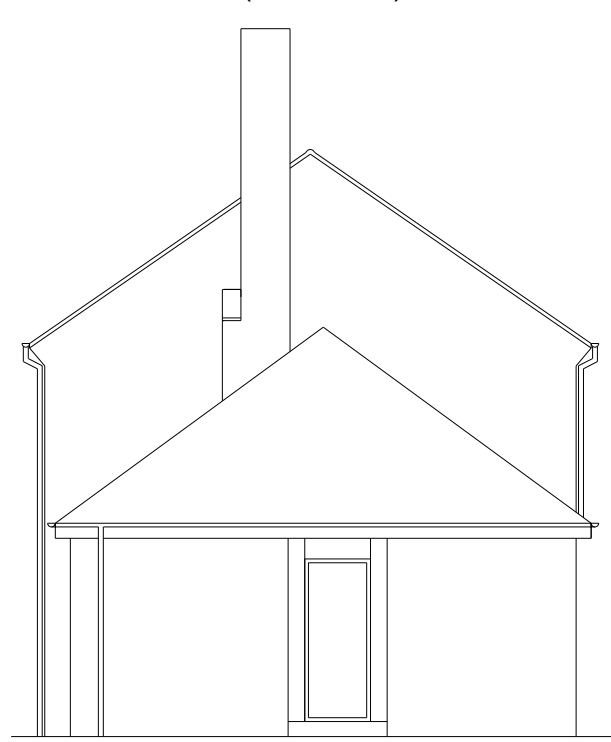

RIGHTSIDE ELEVATION
EXISTING

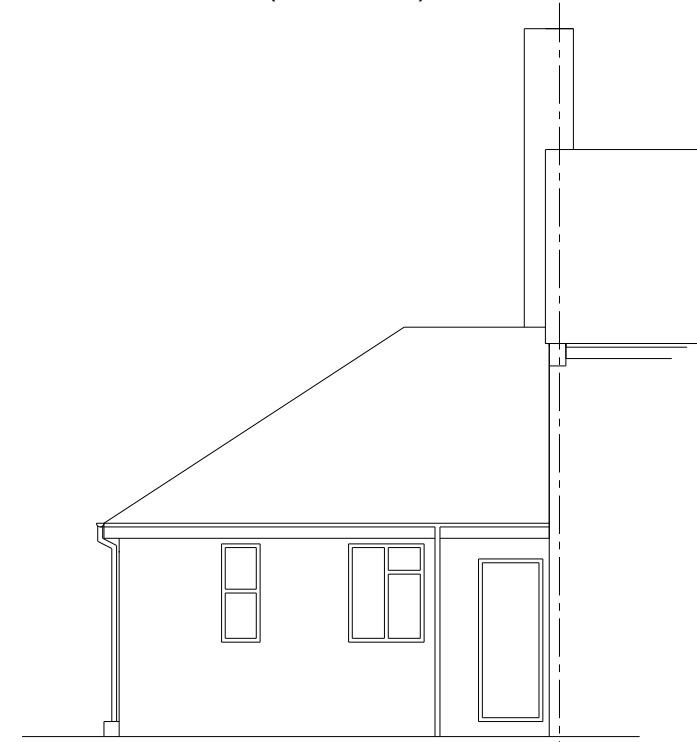

REAR ELEVATION
EXISTING

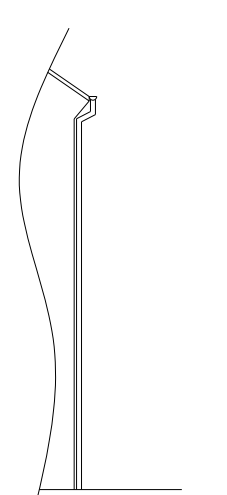


LEFT SIDE ELEVATION
EXISTING

LOFT VOLUME

DORMER:- $5.35 \times 2.20 \times 3.20 = 37.66 \times \frac{1}{2} = 18.83$

HIPPED TO GABLE:-
 $6.70 \times 3.90 \times 2.25 = 65.32 \times \frac{1}{2} = 10.88$

ADD:- $18.83 + 10.88 = 29.71 \text{ cum.}$

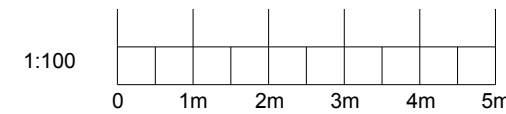

LAWFUL DEVELOPMENT CERTIFICATE EXISTING
 USE OF PORCH, CHANGE OF ROOF FROM
 HIPPED TO GABLE WITH REAR DORMER AT 2
 ANGLESY ROAD WATFORD WD19 6UA
 CLIENT:- MR C IORDACHE
 SCALE:- 1:100 @ A3
 DRG NO.-: 1153-B
 DRAWN BY:- ANIL HALLAN TEL:- 07734033013
 DATE:- DEC. 2022