
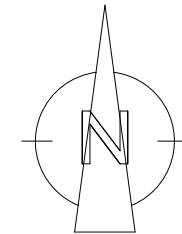


Copyright on all drawings and documents prepared by Anglia Building Consultants is their property. Drawings, documents and designs may not be reproduced in part or in whole without their written permission.

All dimensions and levels should be checked on site prior to commencement of works. Any discrepancy found should be reported to the agent.

This drawing is to be read in conjunction with all relevant engineers and specialist sub-contractors drawings and specifications, along with any other drawings, specification and details prepared by Anglia Building Consultants for the project.

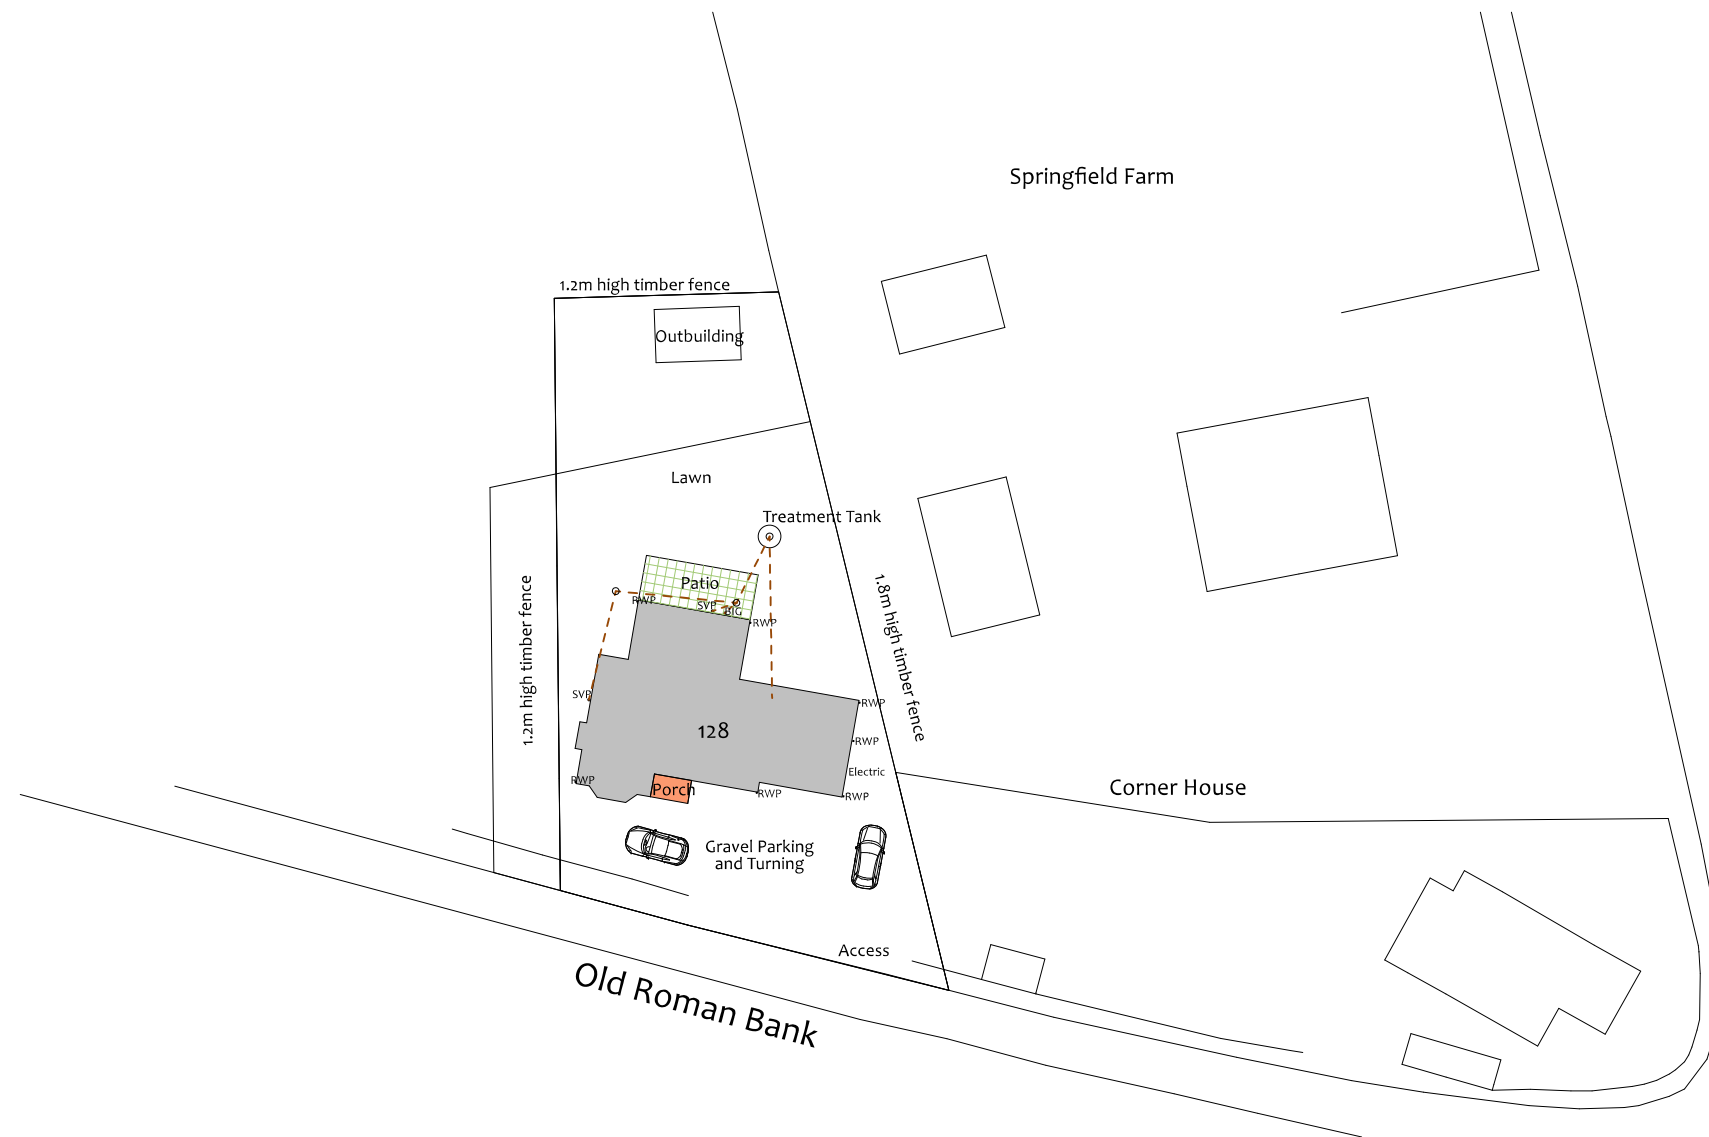

Villeneuve - Basin Road - Outwell
 Norfolk - PE14 8TQ
 01945 772550
 01223 969427
www.angliabuildingconsultants.co.uk
info@angliabuildingconsultants.co.uk

No	Date	Revision
Issue: For Planning Approval		
Site: 128 Old Roman Bank, Terrington St Clements, Norfolk, PE34 4JP		
Project: Residential Development		
Drawing Title: As Built Site Plan		
Client: Mr and Mrs Chapman		
Date	February 2023	
Scale	1:500 at A3	
Drawing Number	P-22-2335-2	

(c) Crown Copyright and database rights 2023. Ordnance Survey Licence 100031961
 Reproduction in whole or in part is prohibited
 without the prior permission of Ordnance Survey.

