



Front Elevation


**Materials**  
 Wall - Crest - Old Saxon Blend Bricks  
 Roof - Sandtoft Clay New Cassius (Antique Slate)  
 Windows/doors - UPVC Slate Grey

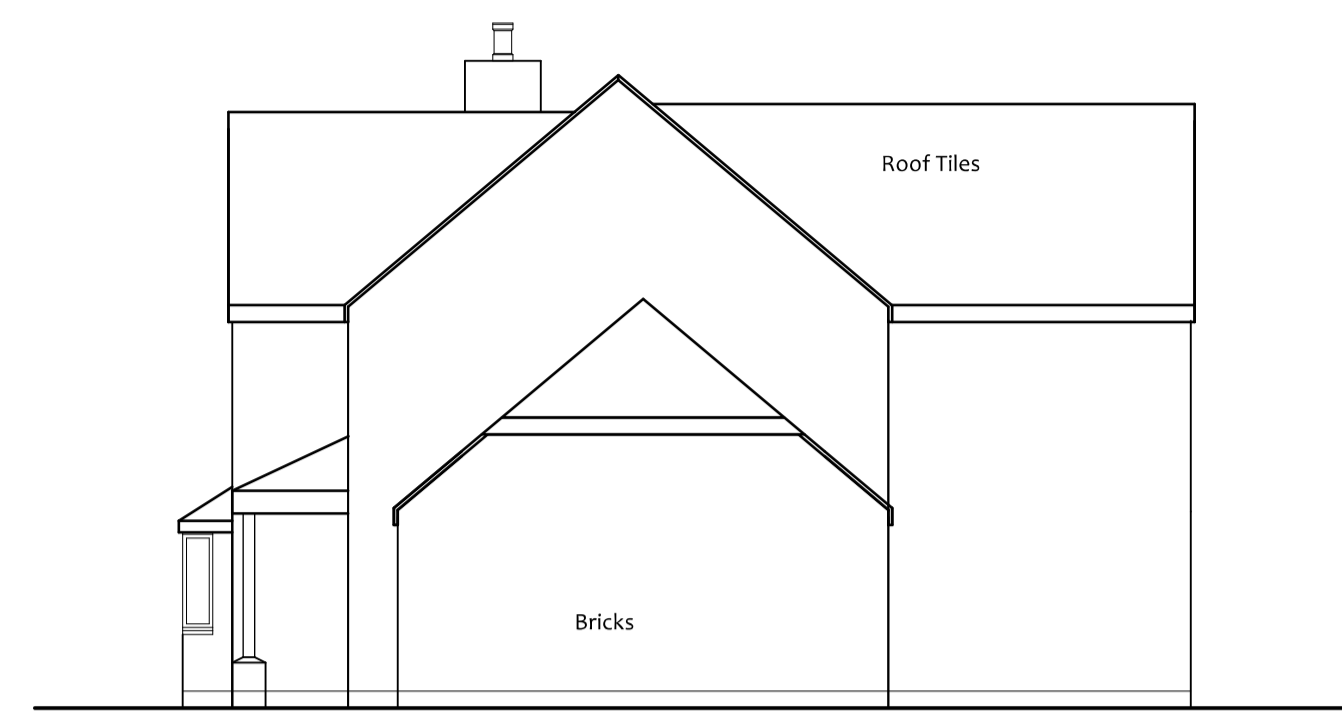


Side Elevation

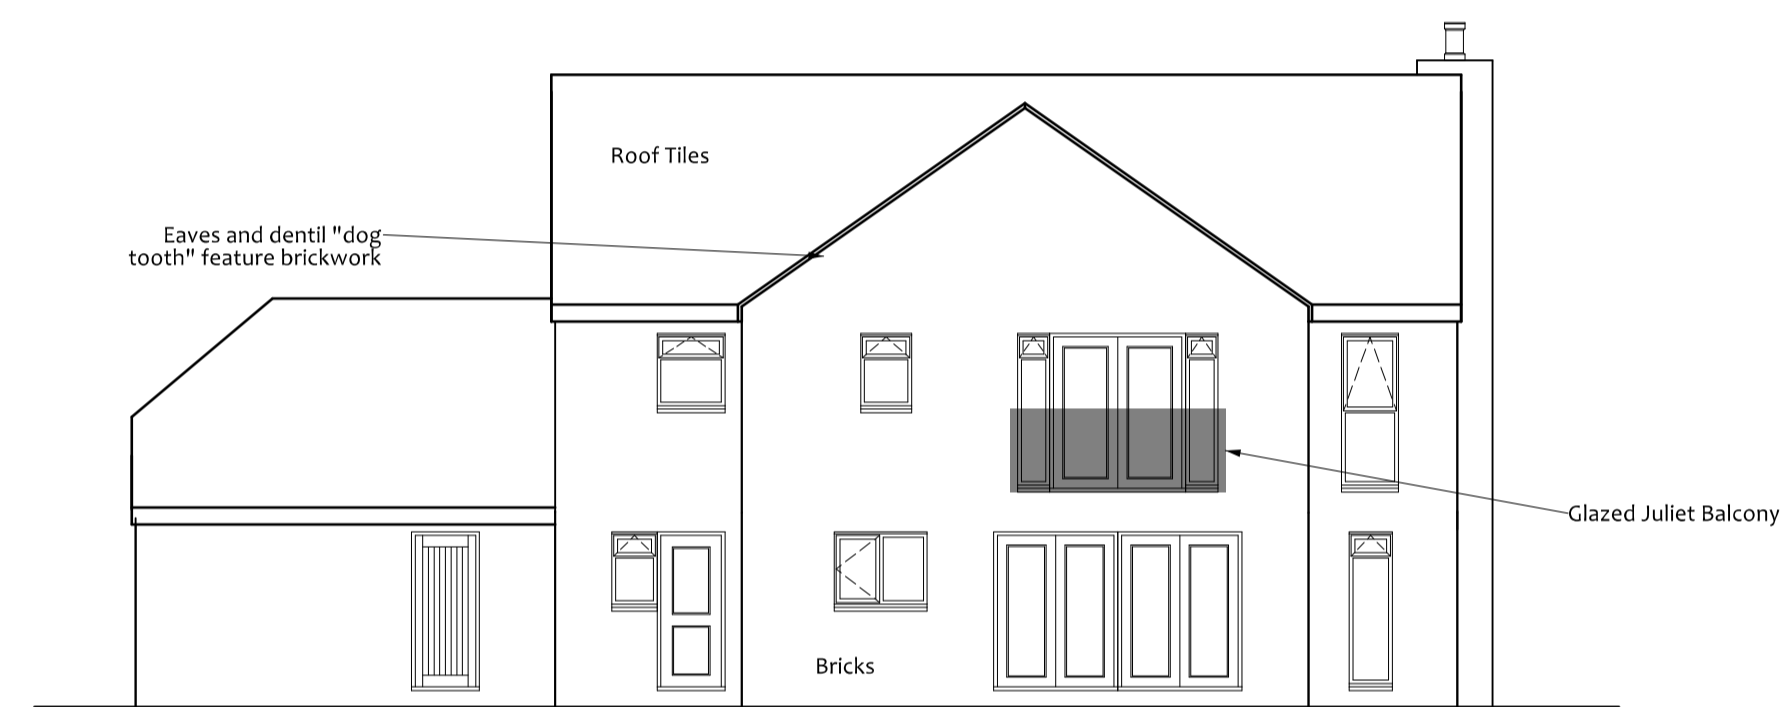


Rear Elevation

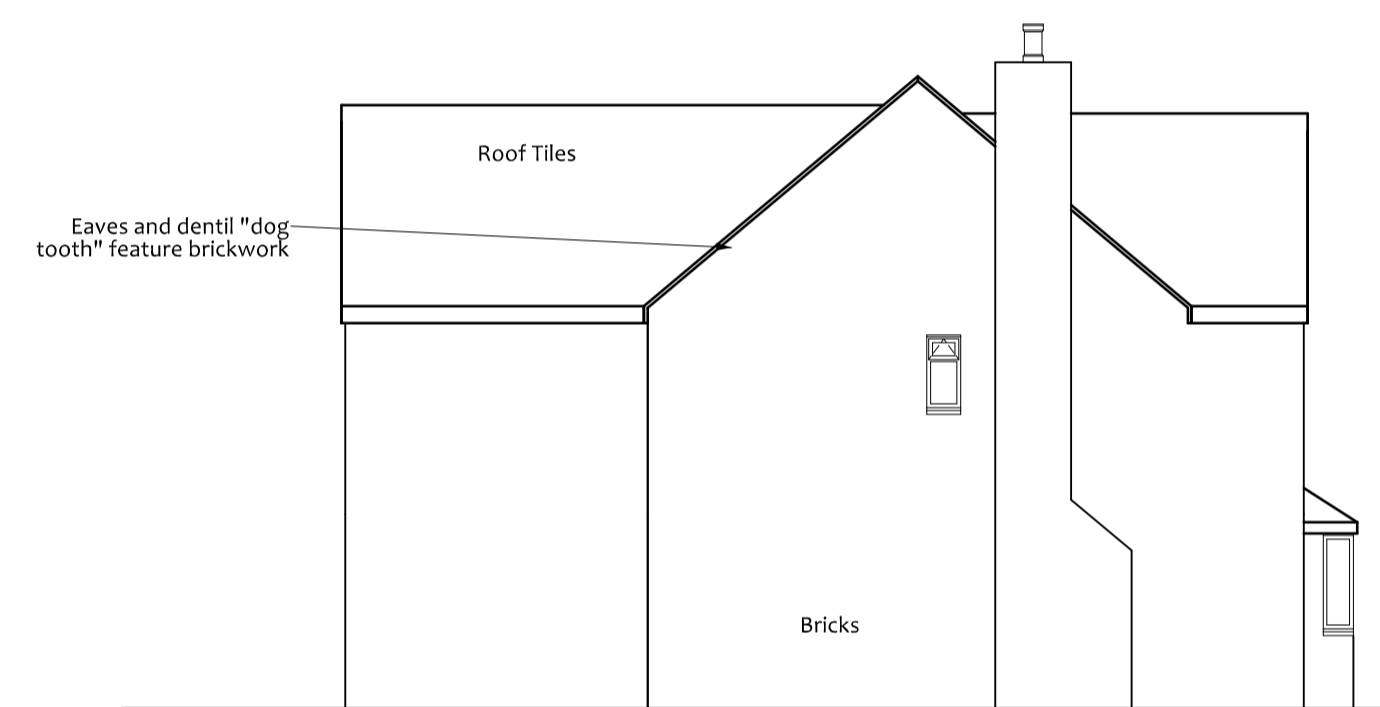

Side Elevation

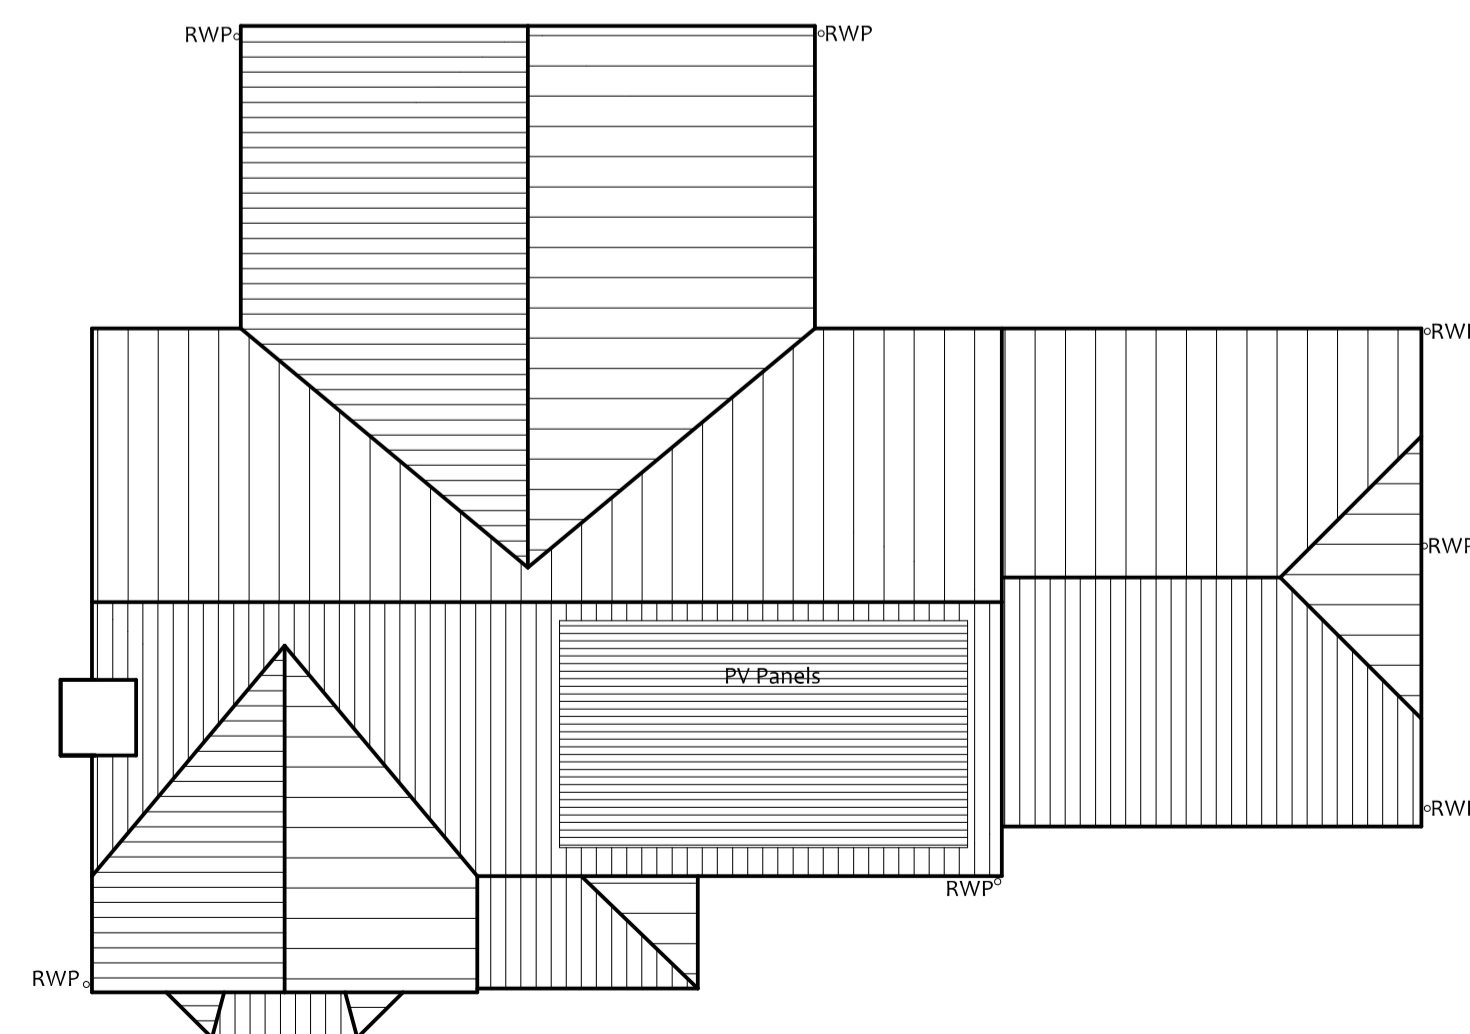

Roof Plan

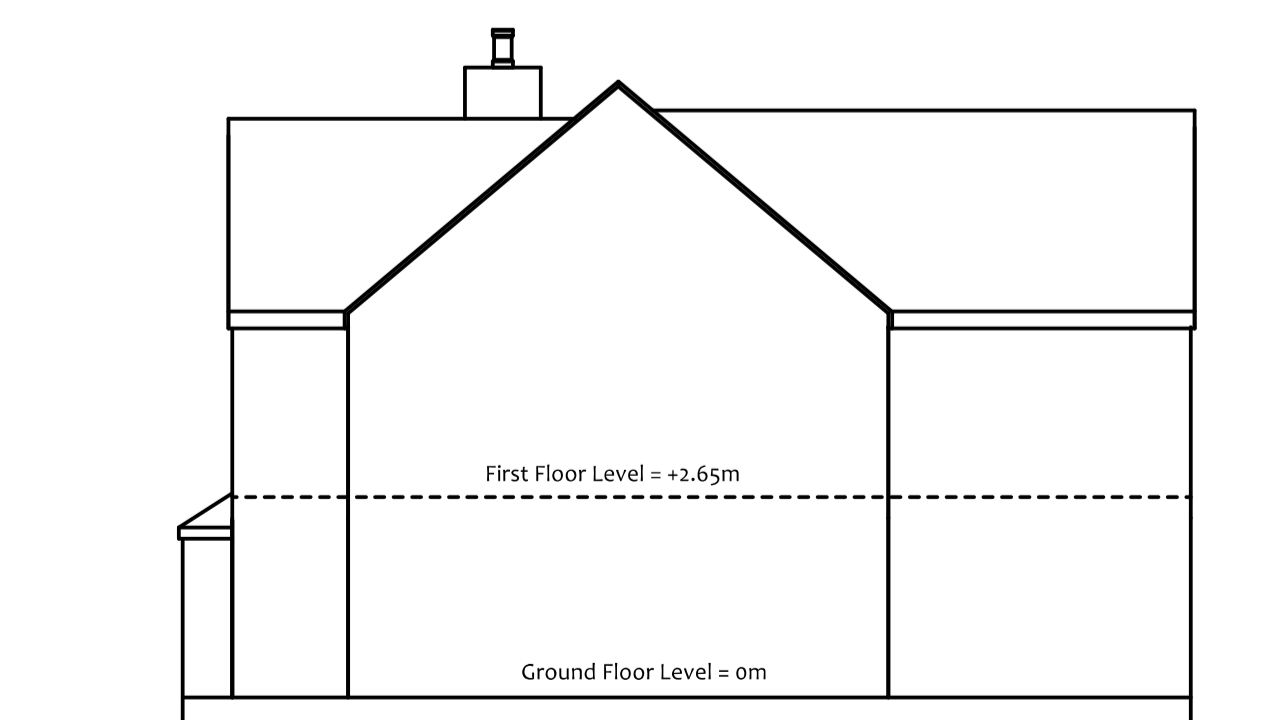

Site Section



Villeneuve - Basin Road - Outwell  
 Norfolk - PE14 8TQ  
 01945 772550  
 01223 969427  
[www.angliabuildingconsultants.co.uk](http://www.angliabuildingconsultants.co.uk)  
[info@angliabuildingconsultants.co.uk](mailto:info@angliabuildingconsultants.co.uk)

No	Date	Revision
Issue: For Planning Approval		
Site: 128 Old Roman Bank, Terrington St Clements, Norfolk, PE34 4JP		
Project: Residential Development		
Drawing Title: As Built Elevations, Roof Plan and Site Section		
Client: Mr and Mrs Chapman		
Date	February 2023	
Scale	1:100 at A1	
Drawing Number	P-22-2335-4	