






LOCATION PLAN
SCALE 1/1250

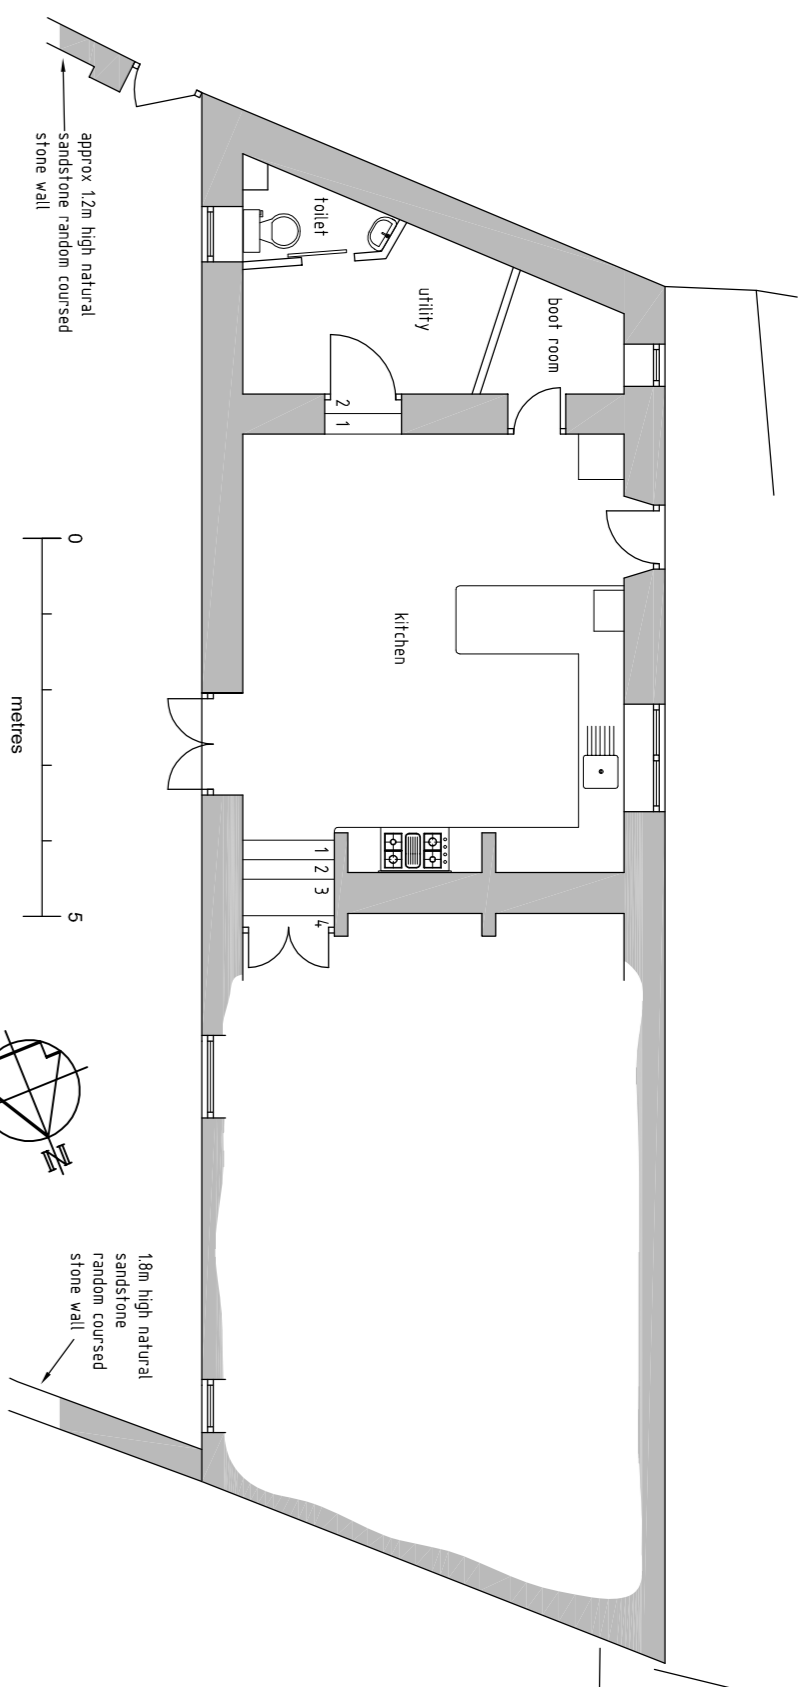


ORIGINAL GROUND FLOOR PLAN
SCALE 1/100

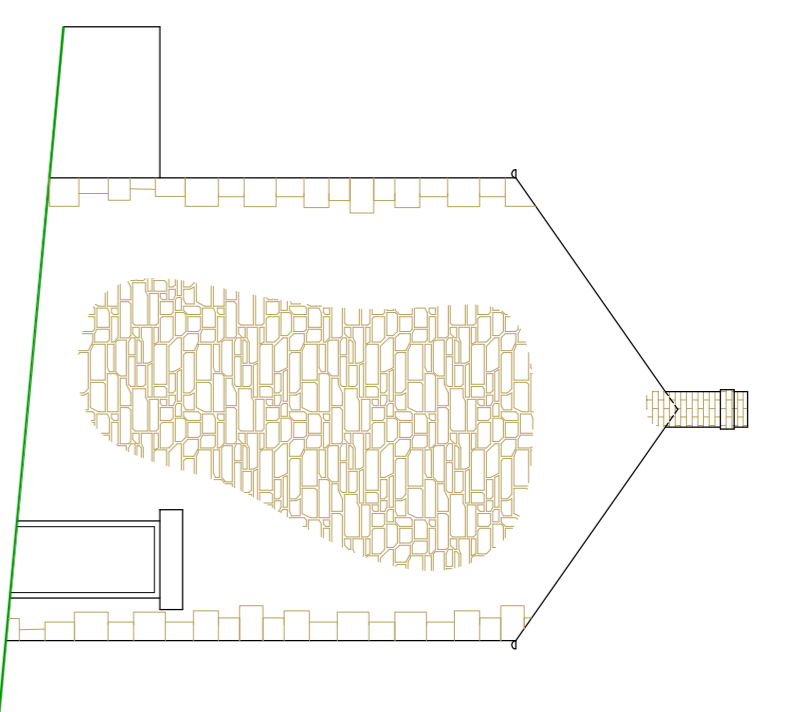


ORIGINAL WESTERN SIDE ELEVATION
SCALE 1/100

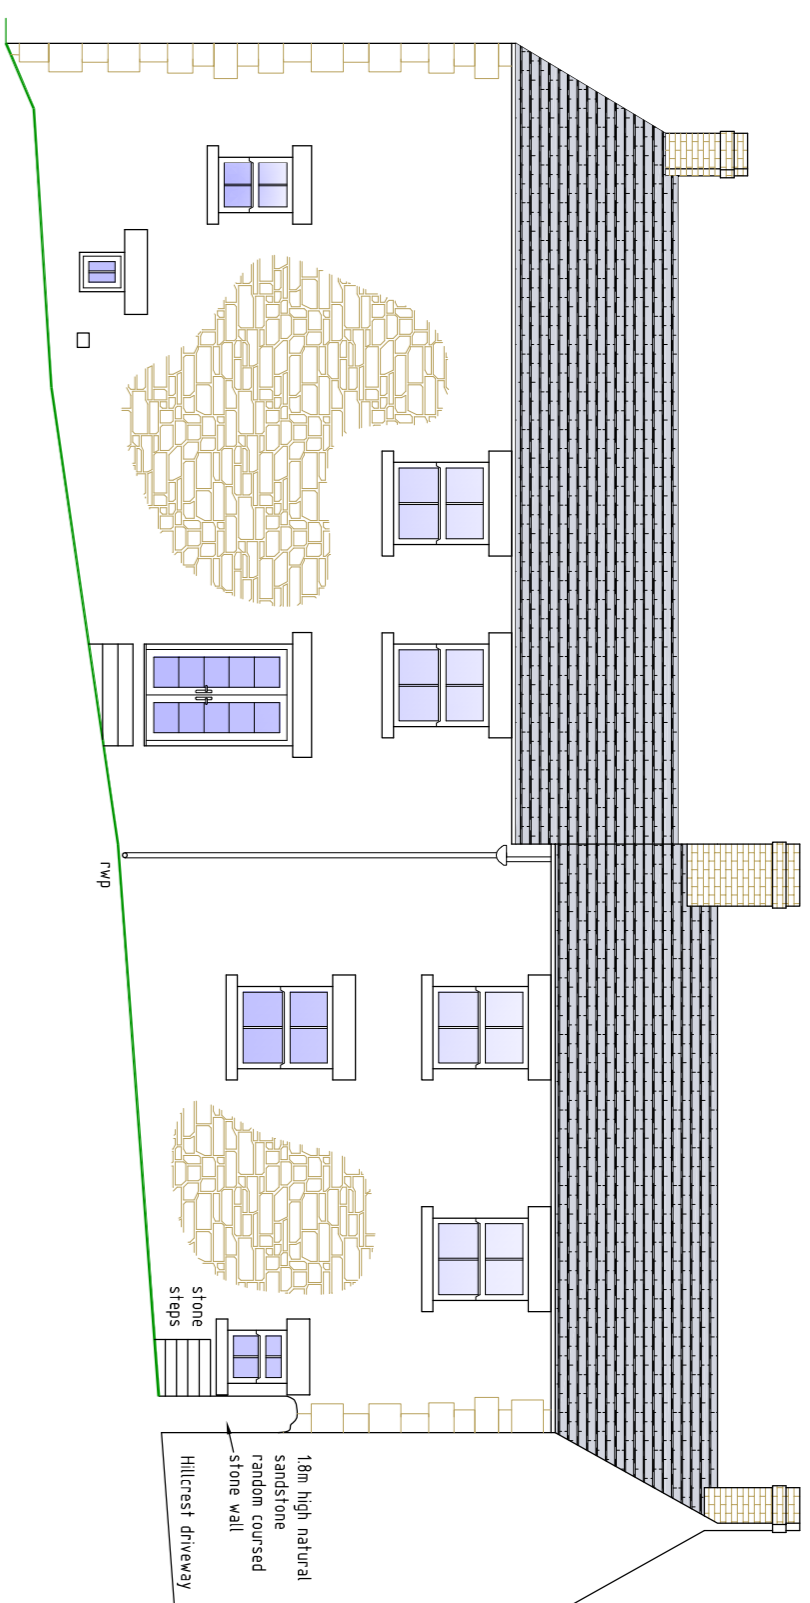


ORIGINAL SOUTHERN REAR ELEVATION
SCALE 1/100

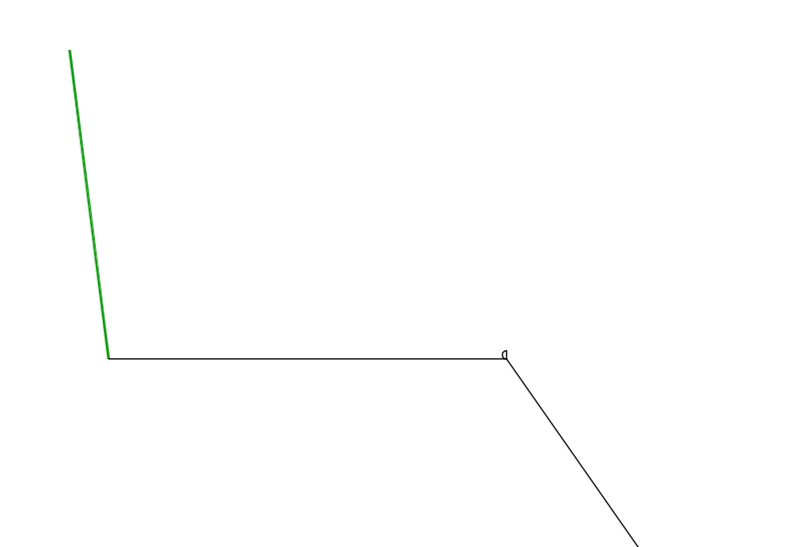


ORIGINAL EASTERN SIDE ELEVATION
SCALE 1/100

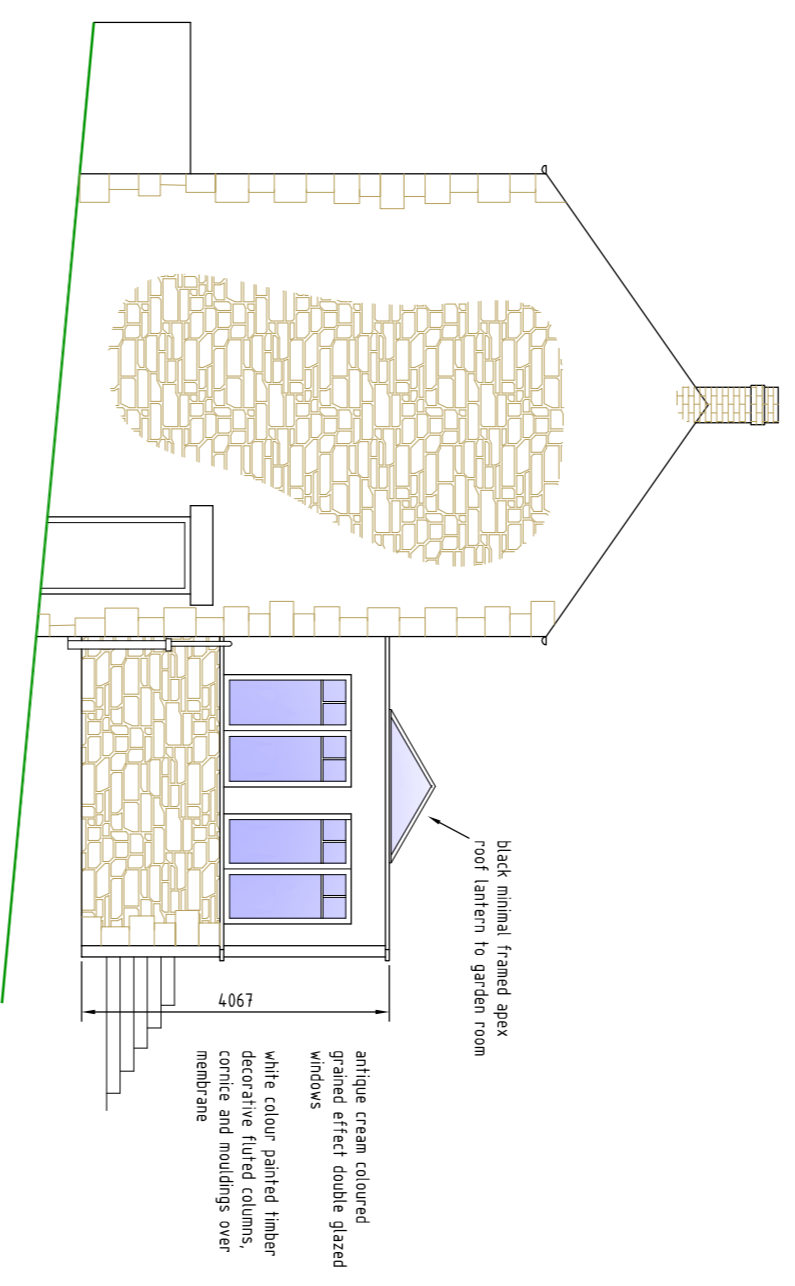


PROPOSED (AS BUILT) WESTERN SIDE ELEVATION
SCALE 1/100

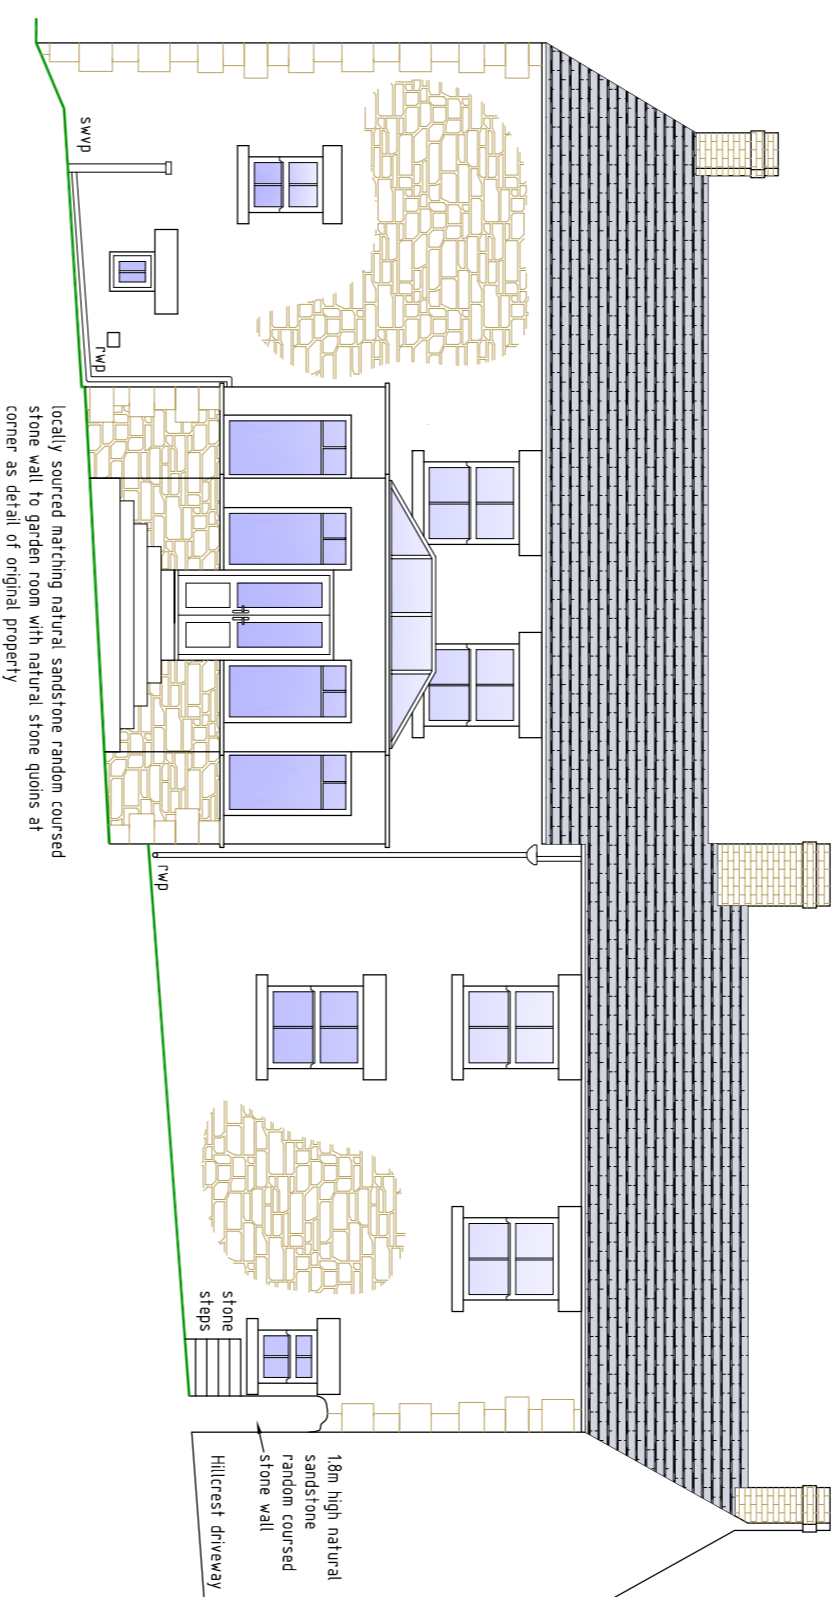


PROPOSED (AS BUILT) SOUTHERN REAR ELEVATION
SCALE 1/100

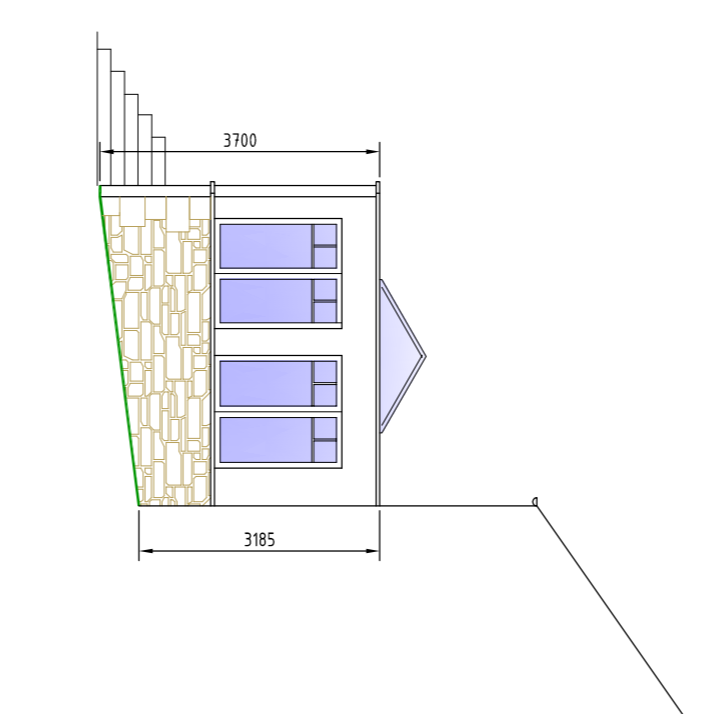

PROPOSED (AS BUILT) EASTERN SIDE ELEVATION
SCALE 1/100

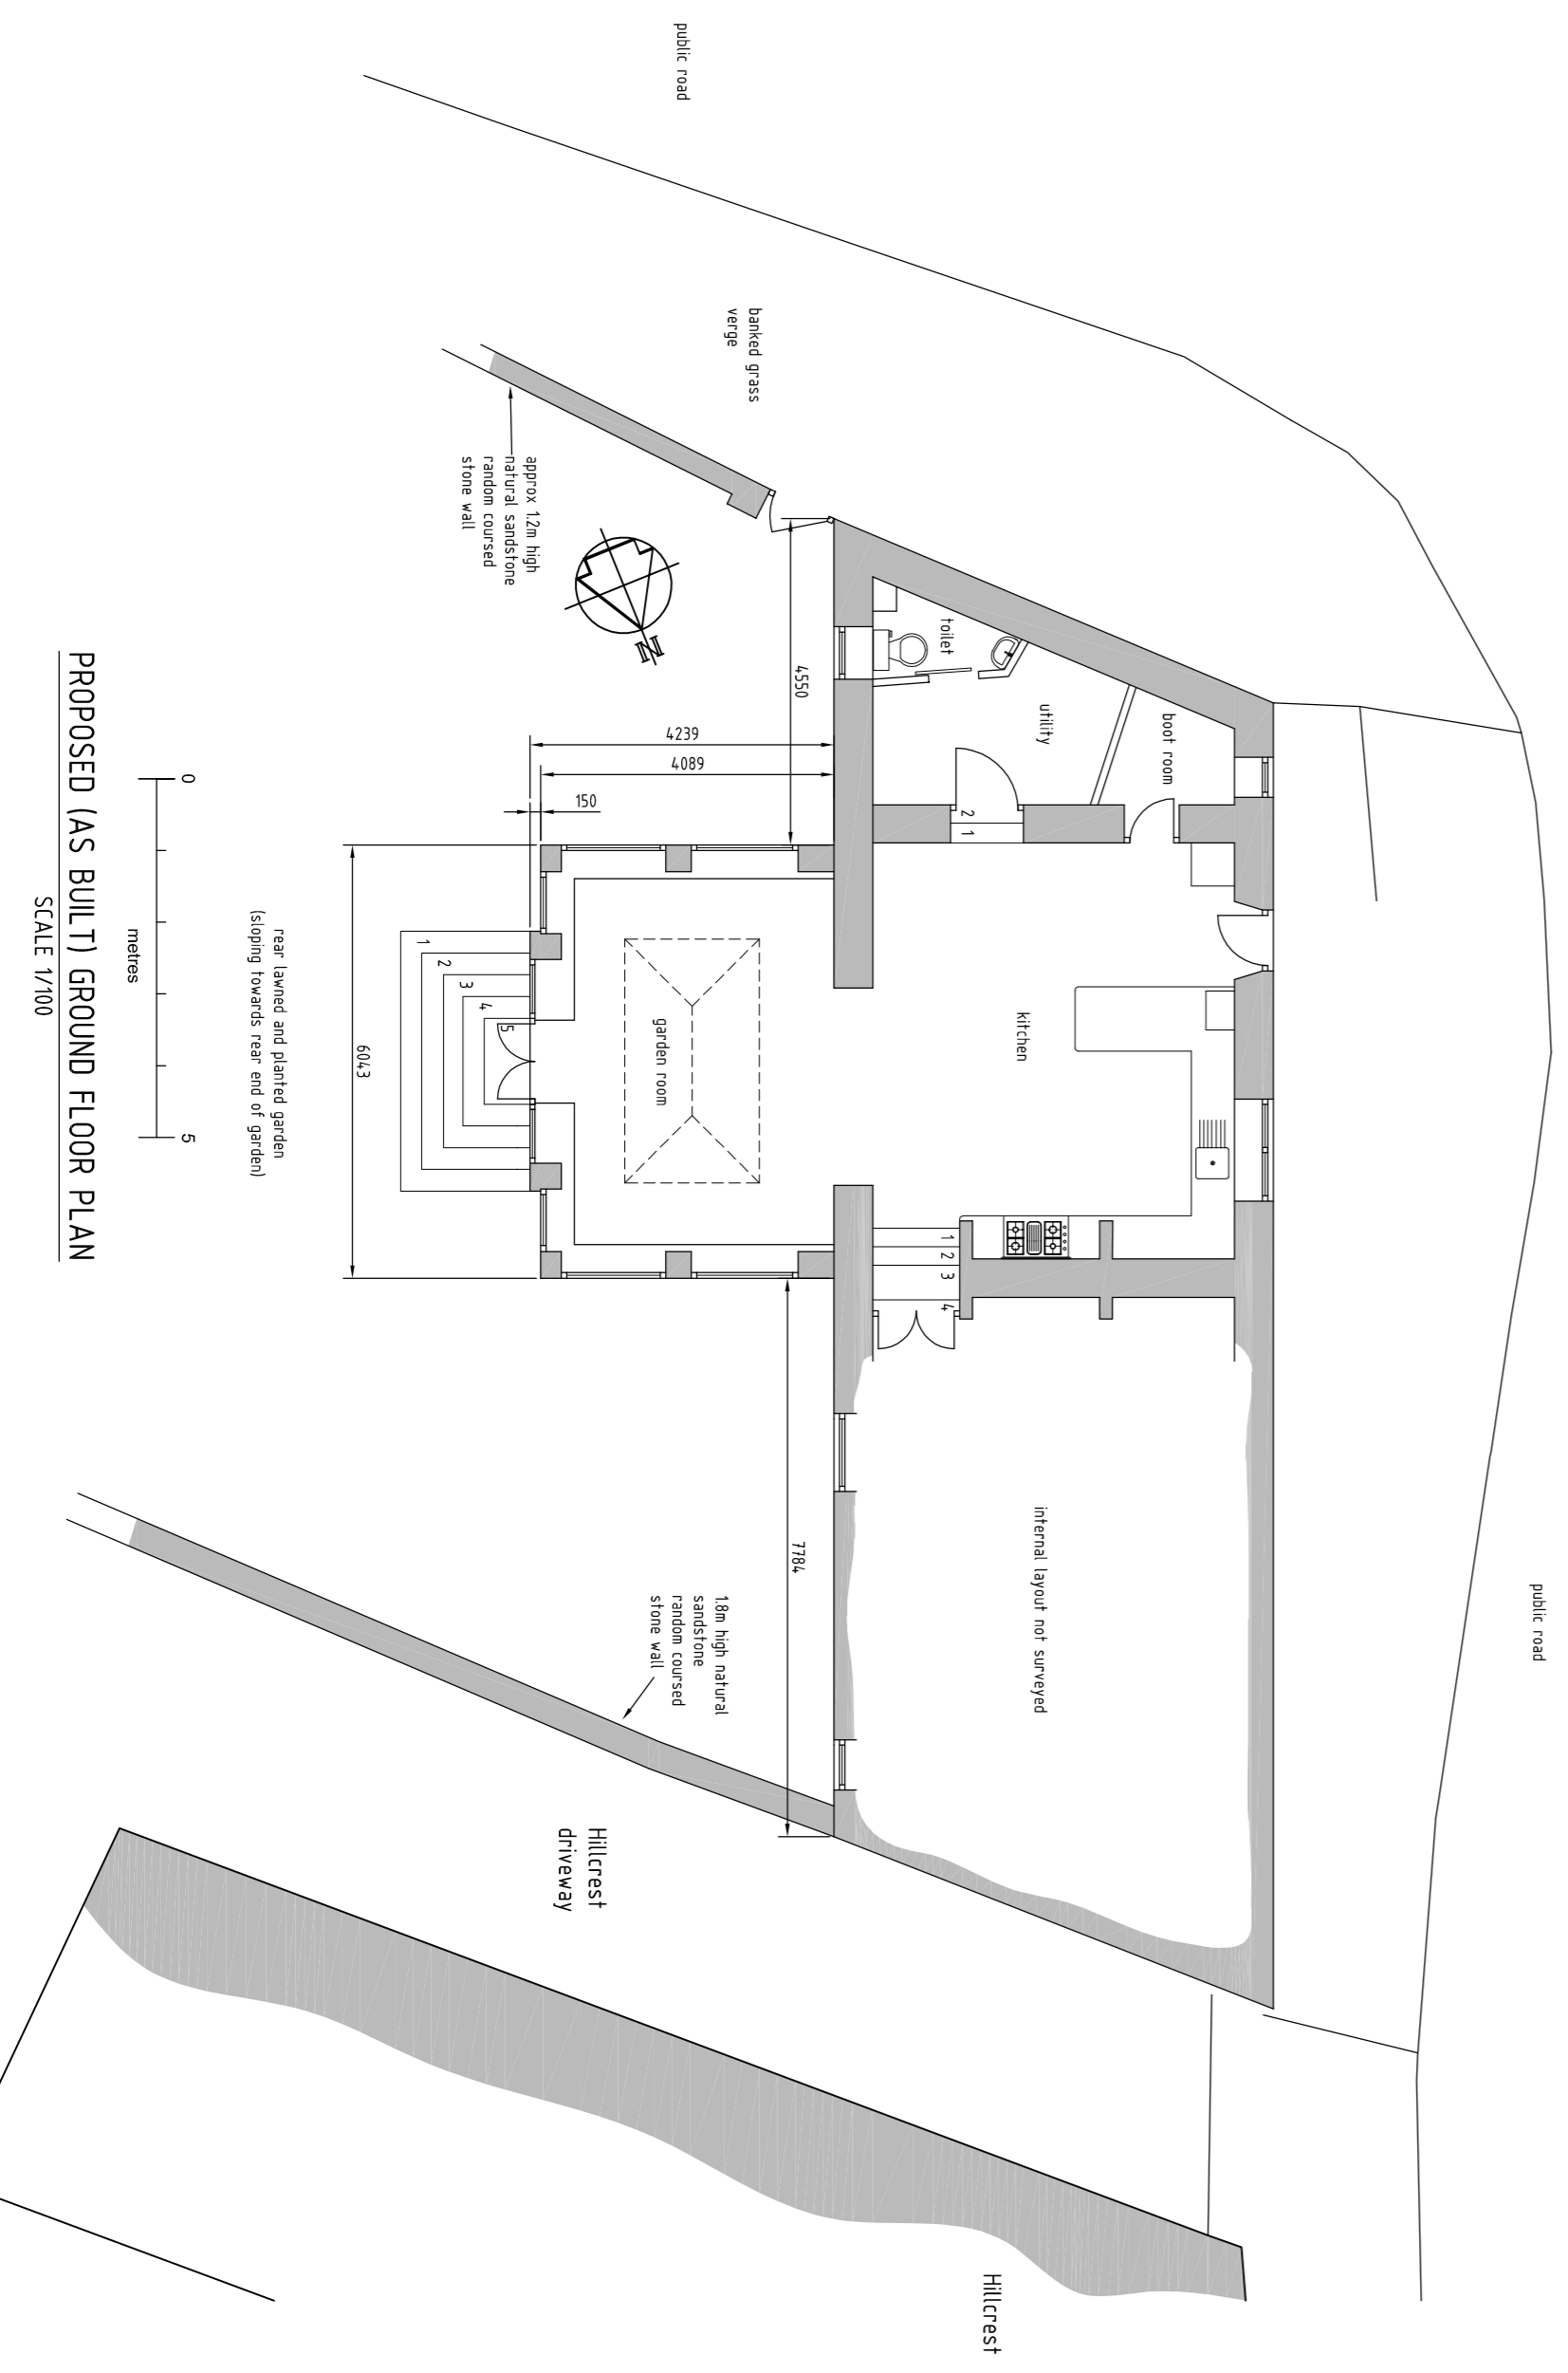

PROPOSED (AS BUILT) GROUND FLOOR PLAN
SCALE 1/100

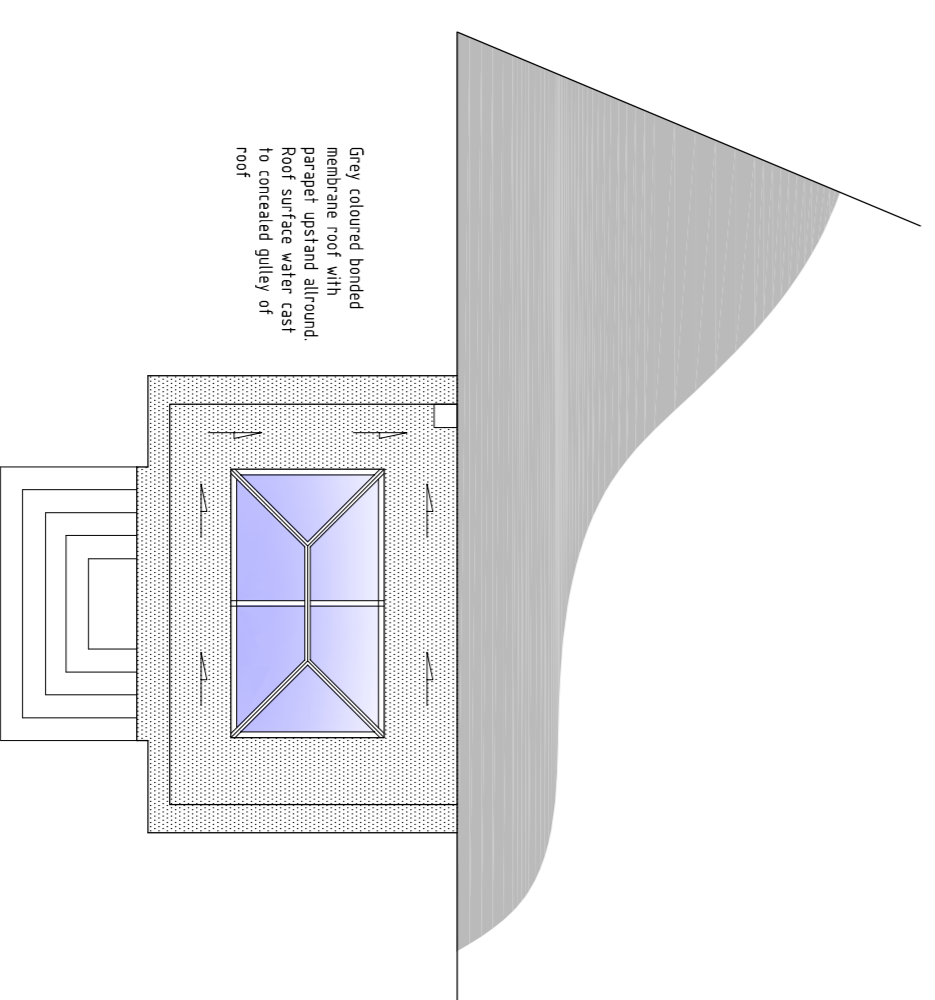

PROPOSED (AS BUILT) ROOF PLAN
SCALE 1/100

Amendments

Rev	Date	Description
0/A	1/3/23	Further detail sent subject to drawing. Existing and proposed details are shown in red and green respectively. To further additional A3 size drawings of 900 mm (A3) (DIP0510FF/01) & (A3) (DIP0510FF/02) respectively.

aspect design
building - civil - structural

tel: 0789 424 1113 / 0191 370 1526
email: info@aspectdesign.org

Client:
MR T TAYLOR
THE OLD POST OFFICE,
NEWTON, NORTHUMBERLAND,
NE43 7UL

Project Title:
CONSTRUCTION OF SINGLE STOREY GARDEN
ROOM TO REAR OF THE OLD POST OFFICE

Drawing Title:
GARDEN ROOM DETAILS
(RETROSPECTIVE PLANNING APPLICATION)

Scale: 1/100, 1/200 & 1/1250	Drawn By: PB
Date: FEB 2023	Rev: 0/A