



Any dimensions shown should be checked on site and discrepancies reported to the Architect prior to construction. Designs are not coordinated with engineer projects. Do not scale for construction purposes.


Block Plans are scaled from the Ordnance Survey Location Maps. Please see the licence number for the Os Maps in the Location Plans

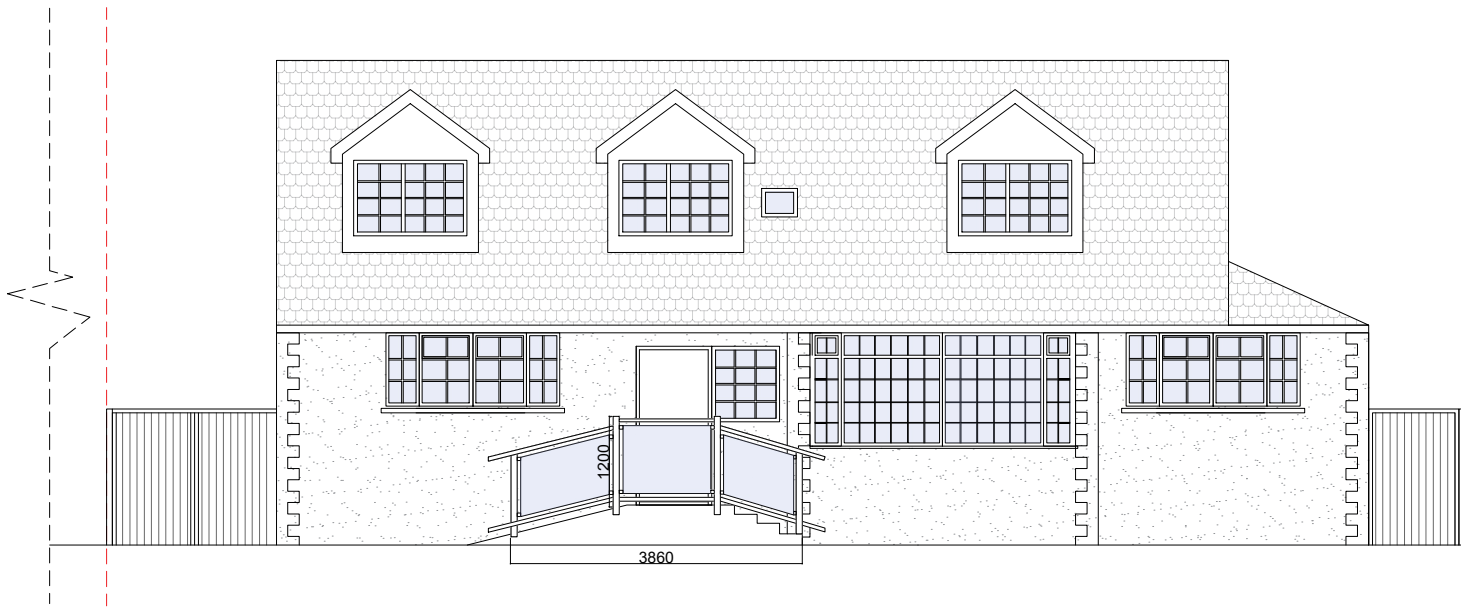


As Built South Elevation

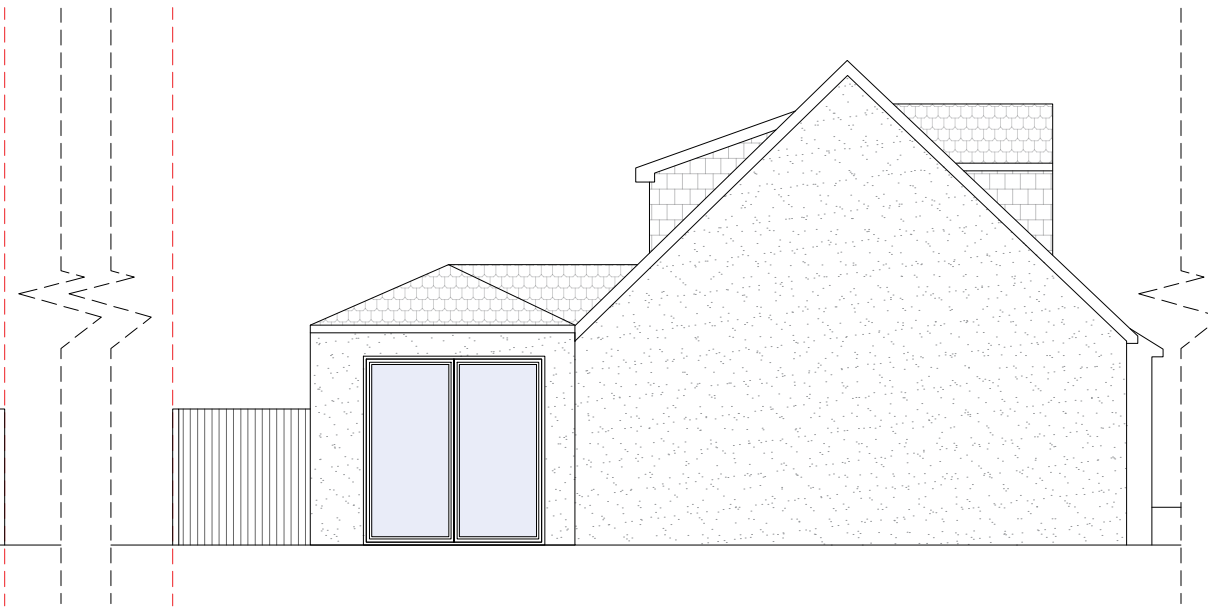


As Built West Elevation

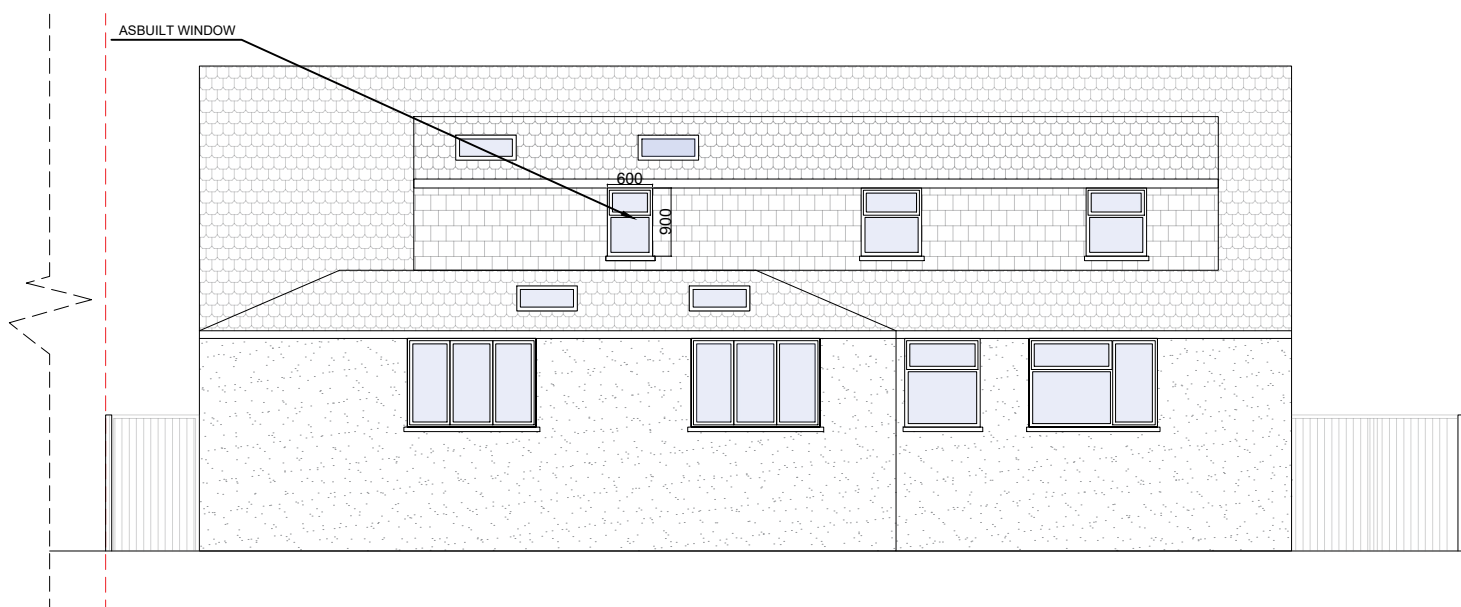

As Built North Elevation

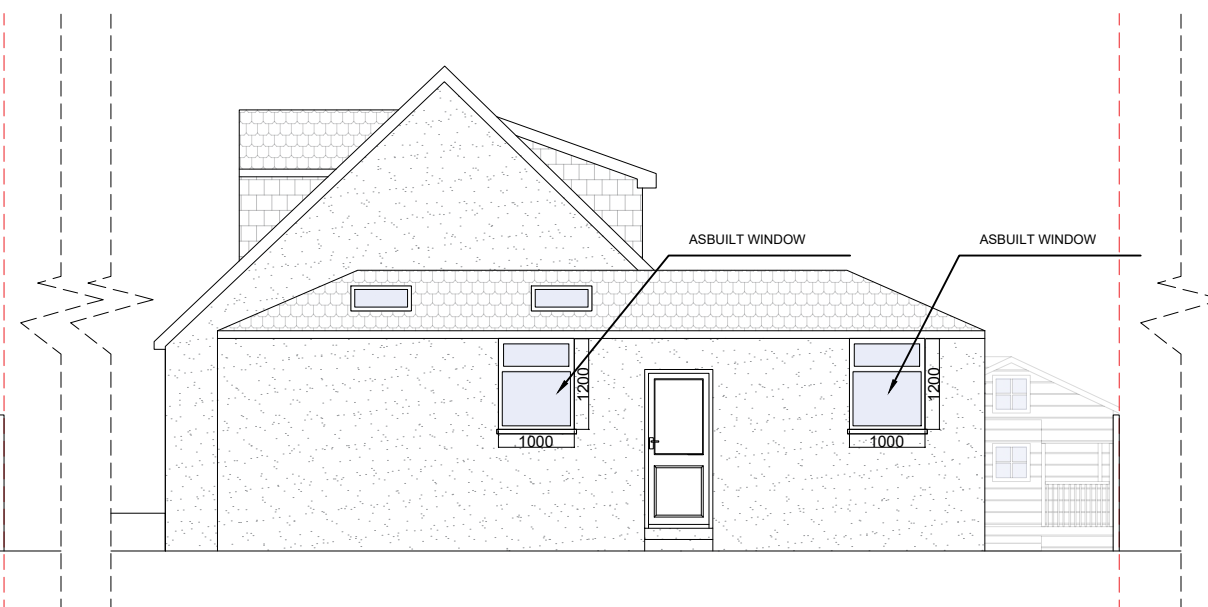

As Built East Elevation

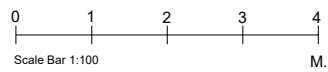

Drawing Name As Built Elevations	
Project Address 2 Greystones Close Aberford Leeds LS25 3AR	
Scale 1/100 at A3	Date 26.04.2023
Designer DG	Revision V4

Drawing No.
**2GreystonesClose_
AsBuiltElevations_V4**



Planning By Design Ltd
www.planning-by-design.co.uk
hello@planning-by-design.co.uk