



Any dimensions shown should be checked on site and discrepancies reported to the Architect prior to construction. Designs are not coordinated with engineer projects. Do not scale for construction purposes.


As Approved  
As Built

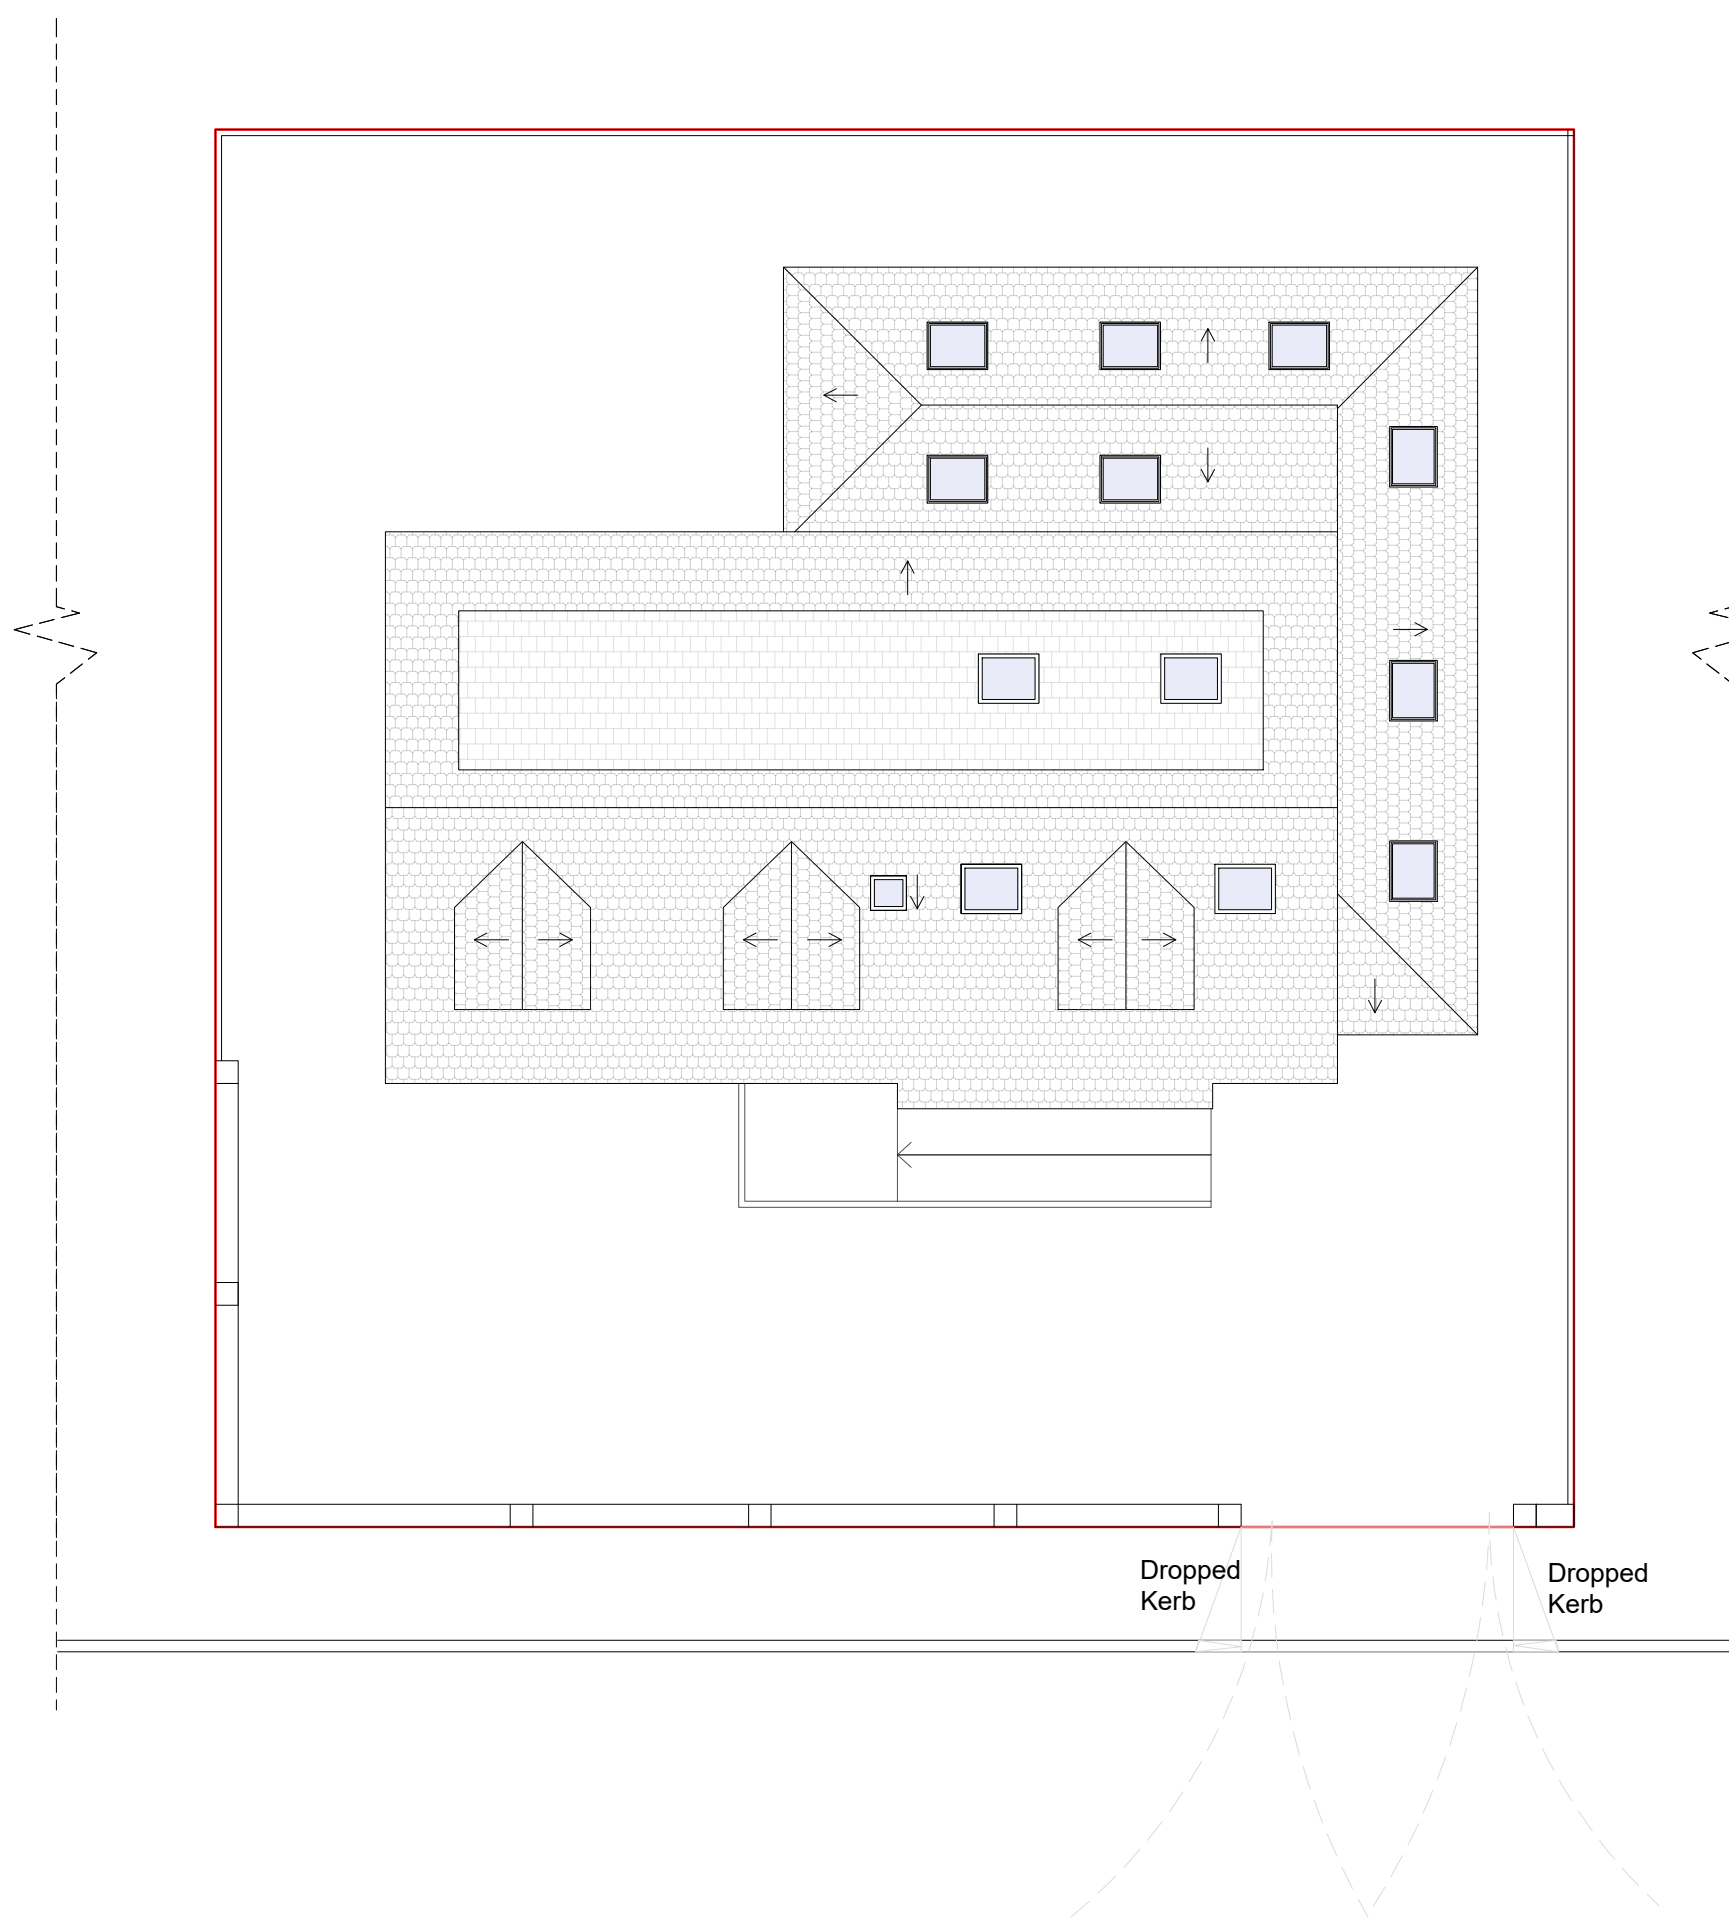

As Approved Roof Plan

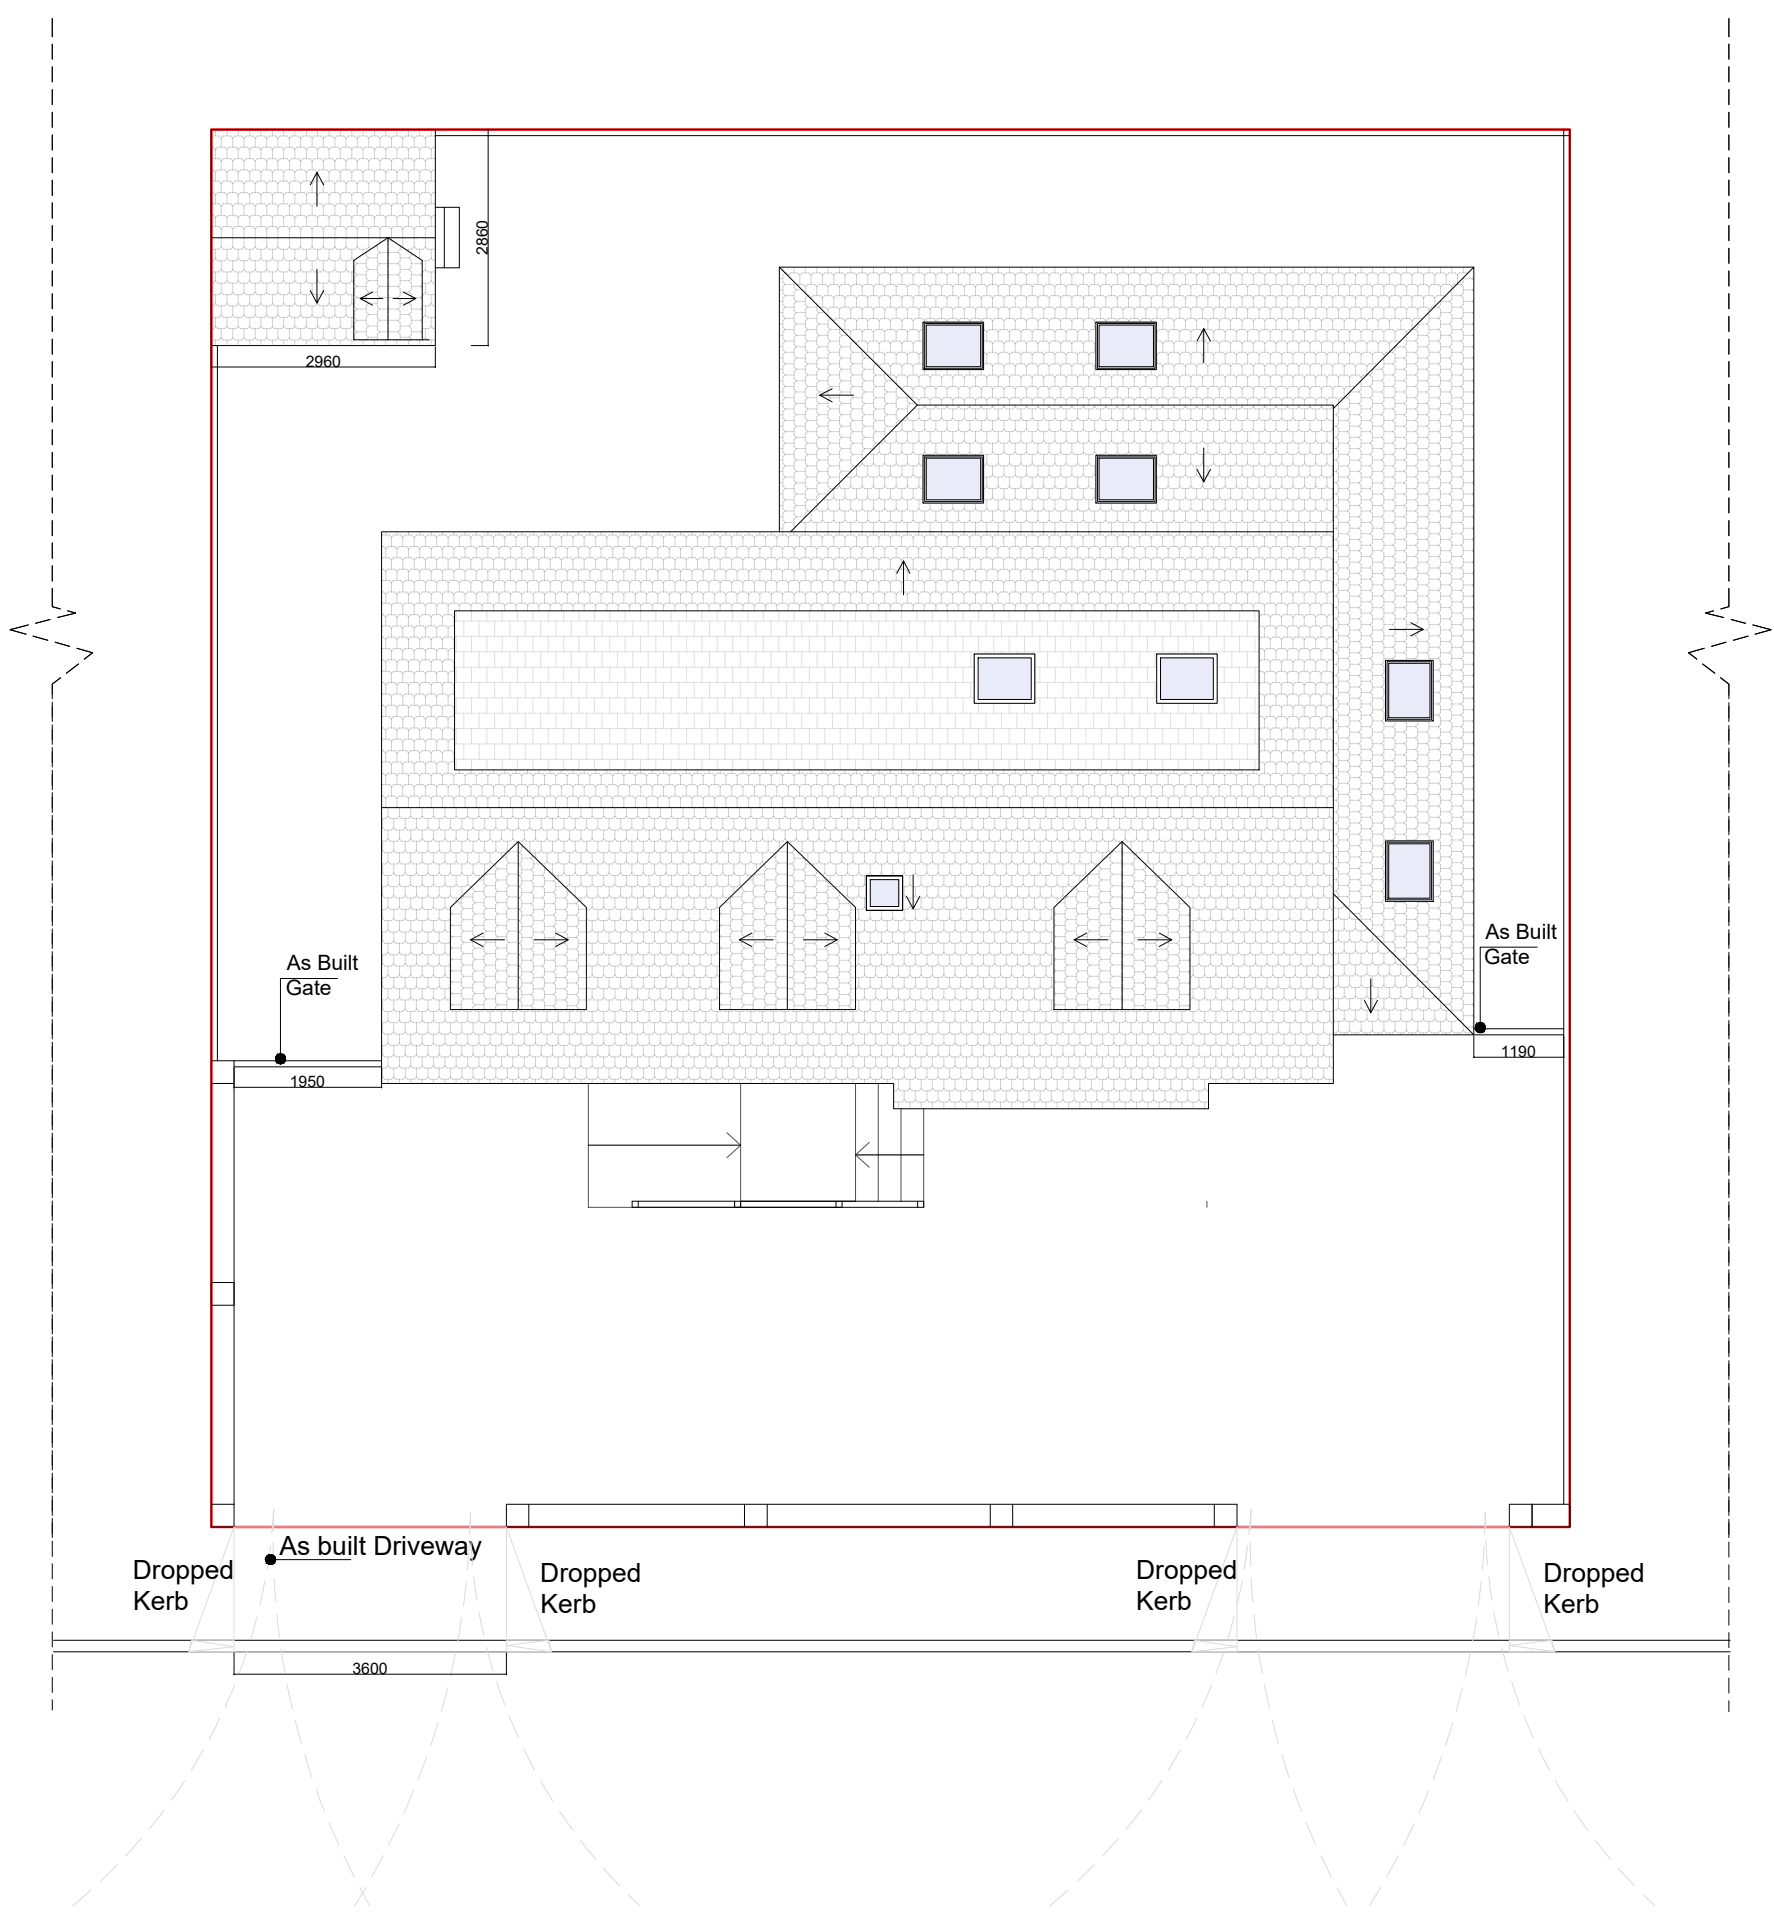

As Built Roof Plan

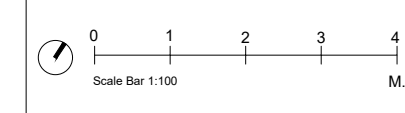

Drawing Name	
Roof Plans	
Project Address	
2 Greystones Close Aberford Leeds LS25 3AR	
Scale	Date
1/100 at A2	07.03.2023
Designer	Revision
DG	V4
Drawing No.	
2GreystonesClose_ RoofPlans_V4	



Planning By Design Ltd  
www.planning-by-design.co.uk  
hello@planning-by-design.co.uk